SURVEY

OF PART OF

ORIGINAL LOT Nº 40 TRACT Nº 6

PENFIELD TOWNSHIP

COUNTY OF LORAIN STATE OF OHIO

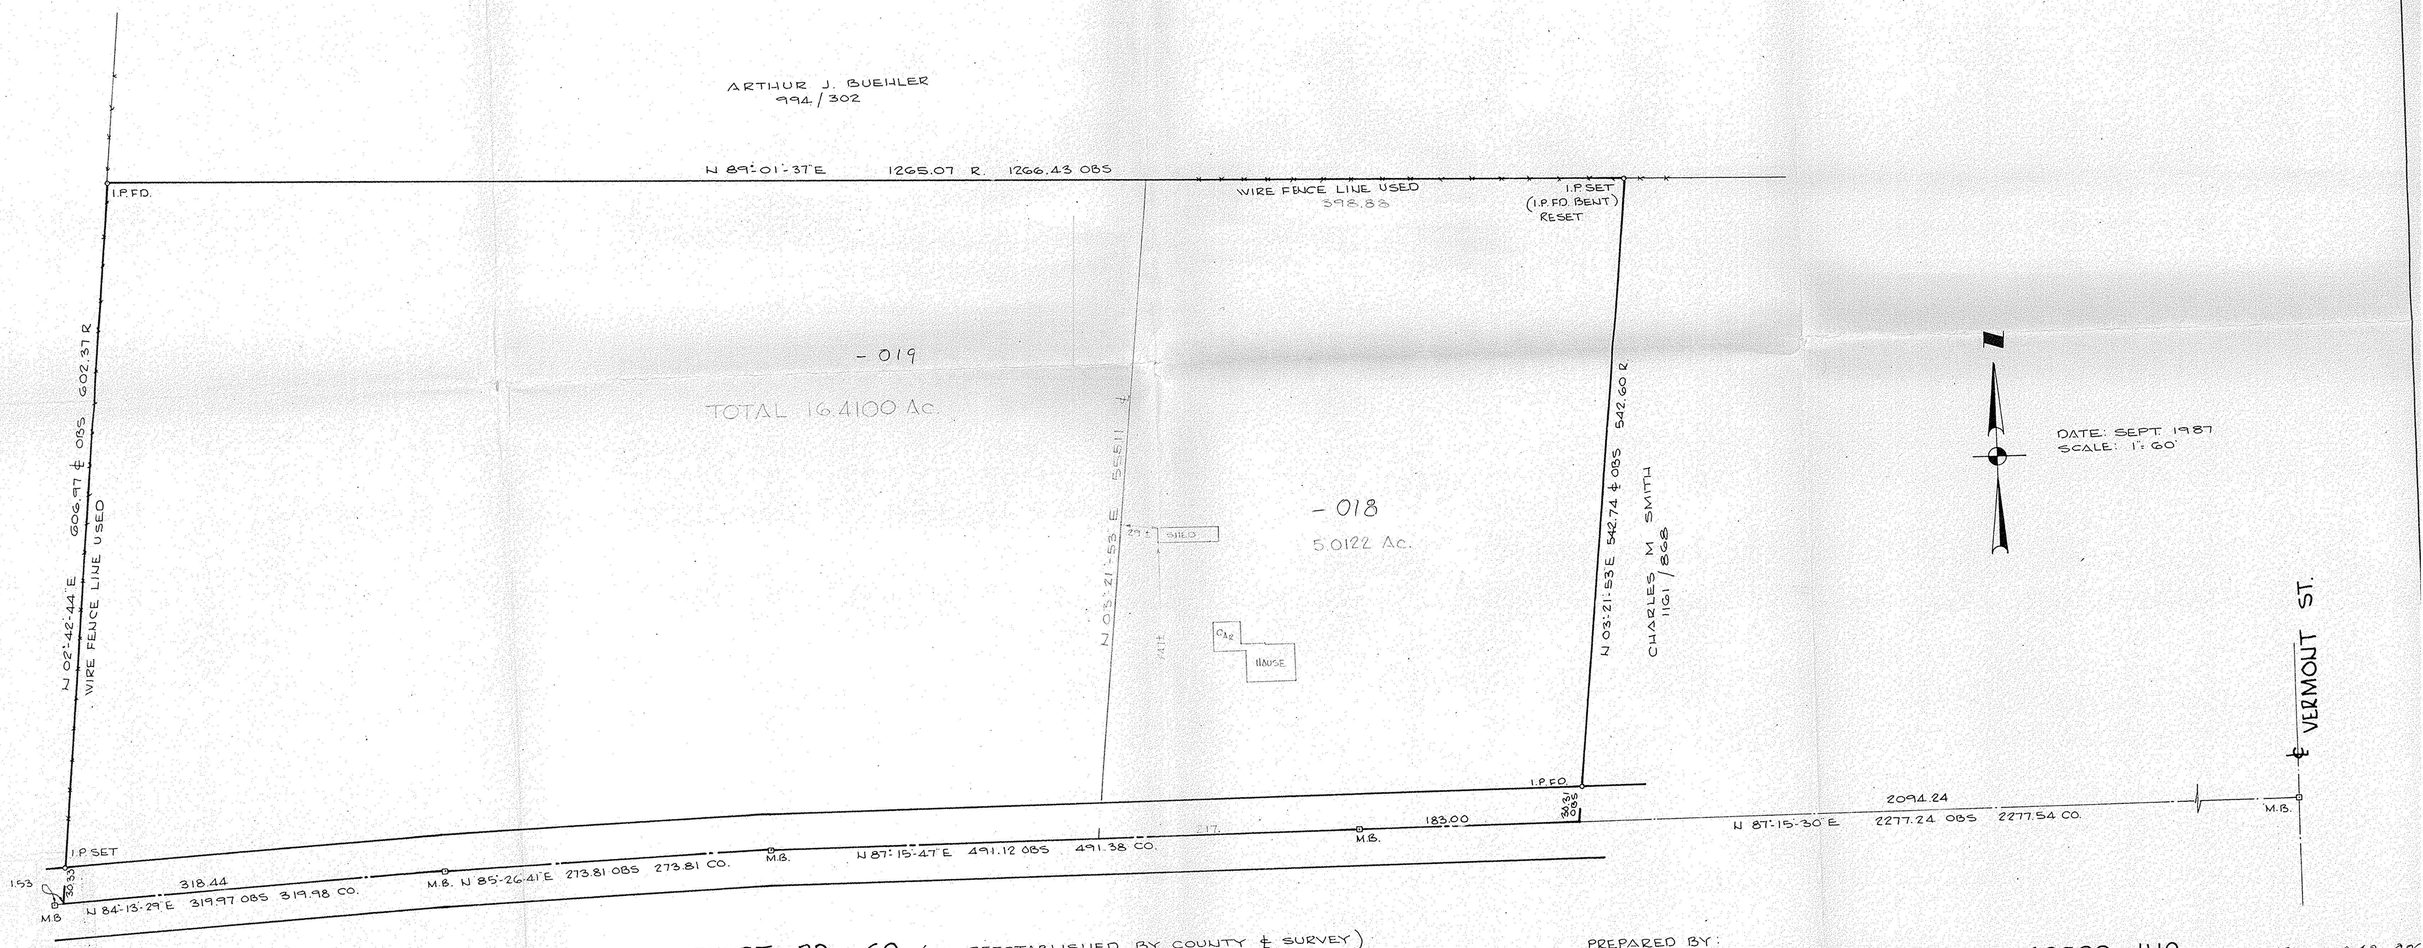

SHORT RD 60 (AS REESTABLISHED BY COUNTY & SURVEY)

PREPARED BY:

LAUNDON - SIMON - CAHL AND ASSOC., INC.

ENGINEERS AND SURVEYORS
219 COURT ST.
ELYRIA, O

JOB Nº 87-1645

STATE OF OHIO
DANE A. HAPONEK
S-6211
REGISTERED SURVEYOR

19-06-040-000

#17699

APPROVED
LORAIN CO.
MAP DEPT.
DATE 9-25-87
PAGE 19-D
BY B. FRANCI
VOID NUMBER 17699

SEP 9 1987