CARDINAL SURVEYS
PLAT OF SURVEY
PREPARED FOR MRS. E. GNANOT

SURVEY IN PENFIELD. TOWNSHIP NO. 16 TRACT NO. 5
SURVEY 32.50 AC PER DEED, FOUND TO BE 32.9312 ACRES, SPLIT BASICALLY IN HALF. 16.4467 WEST HALF; 16.4845 EAST HALF. FROM DV 302 PG 154

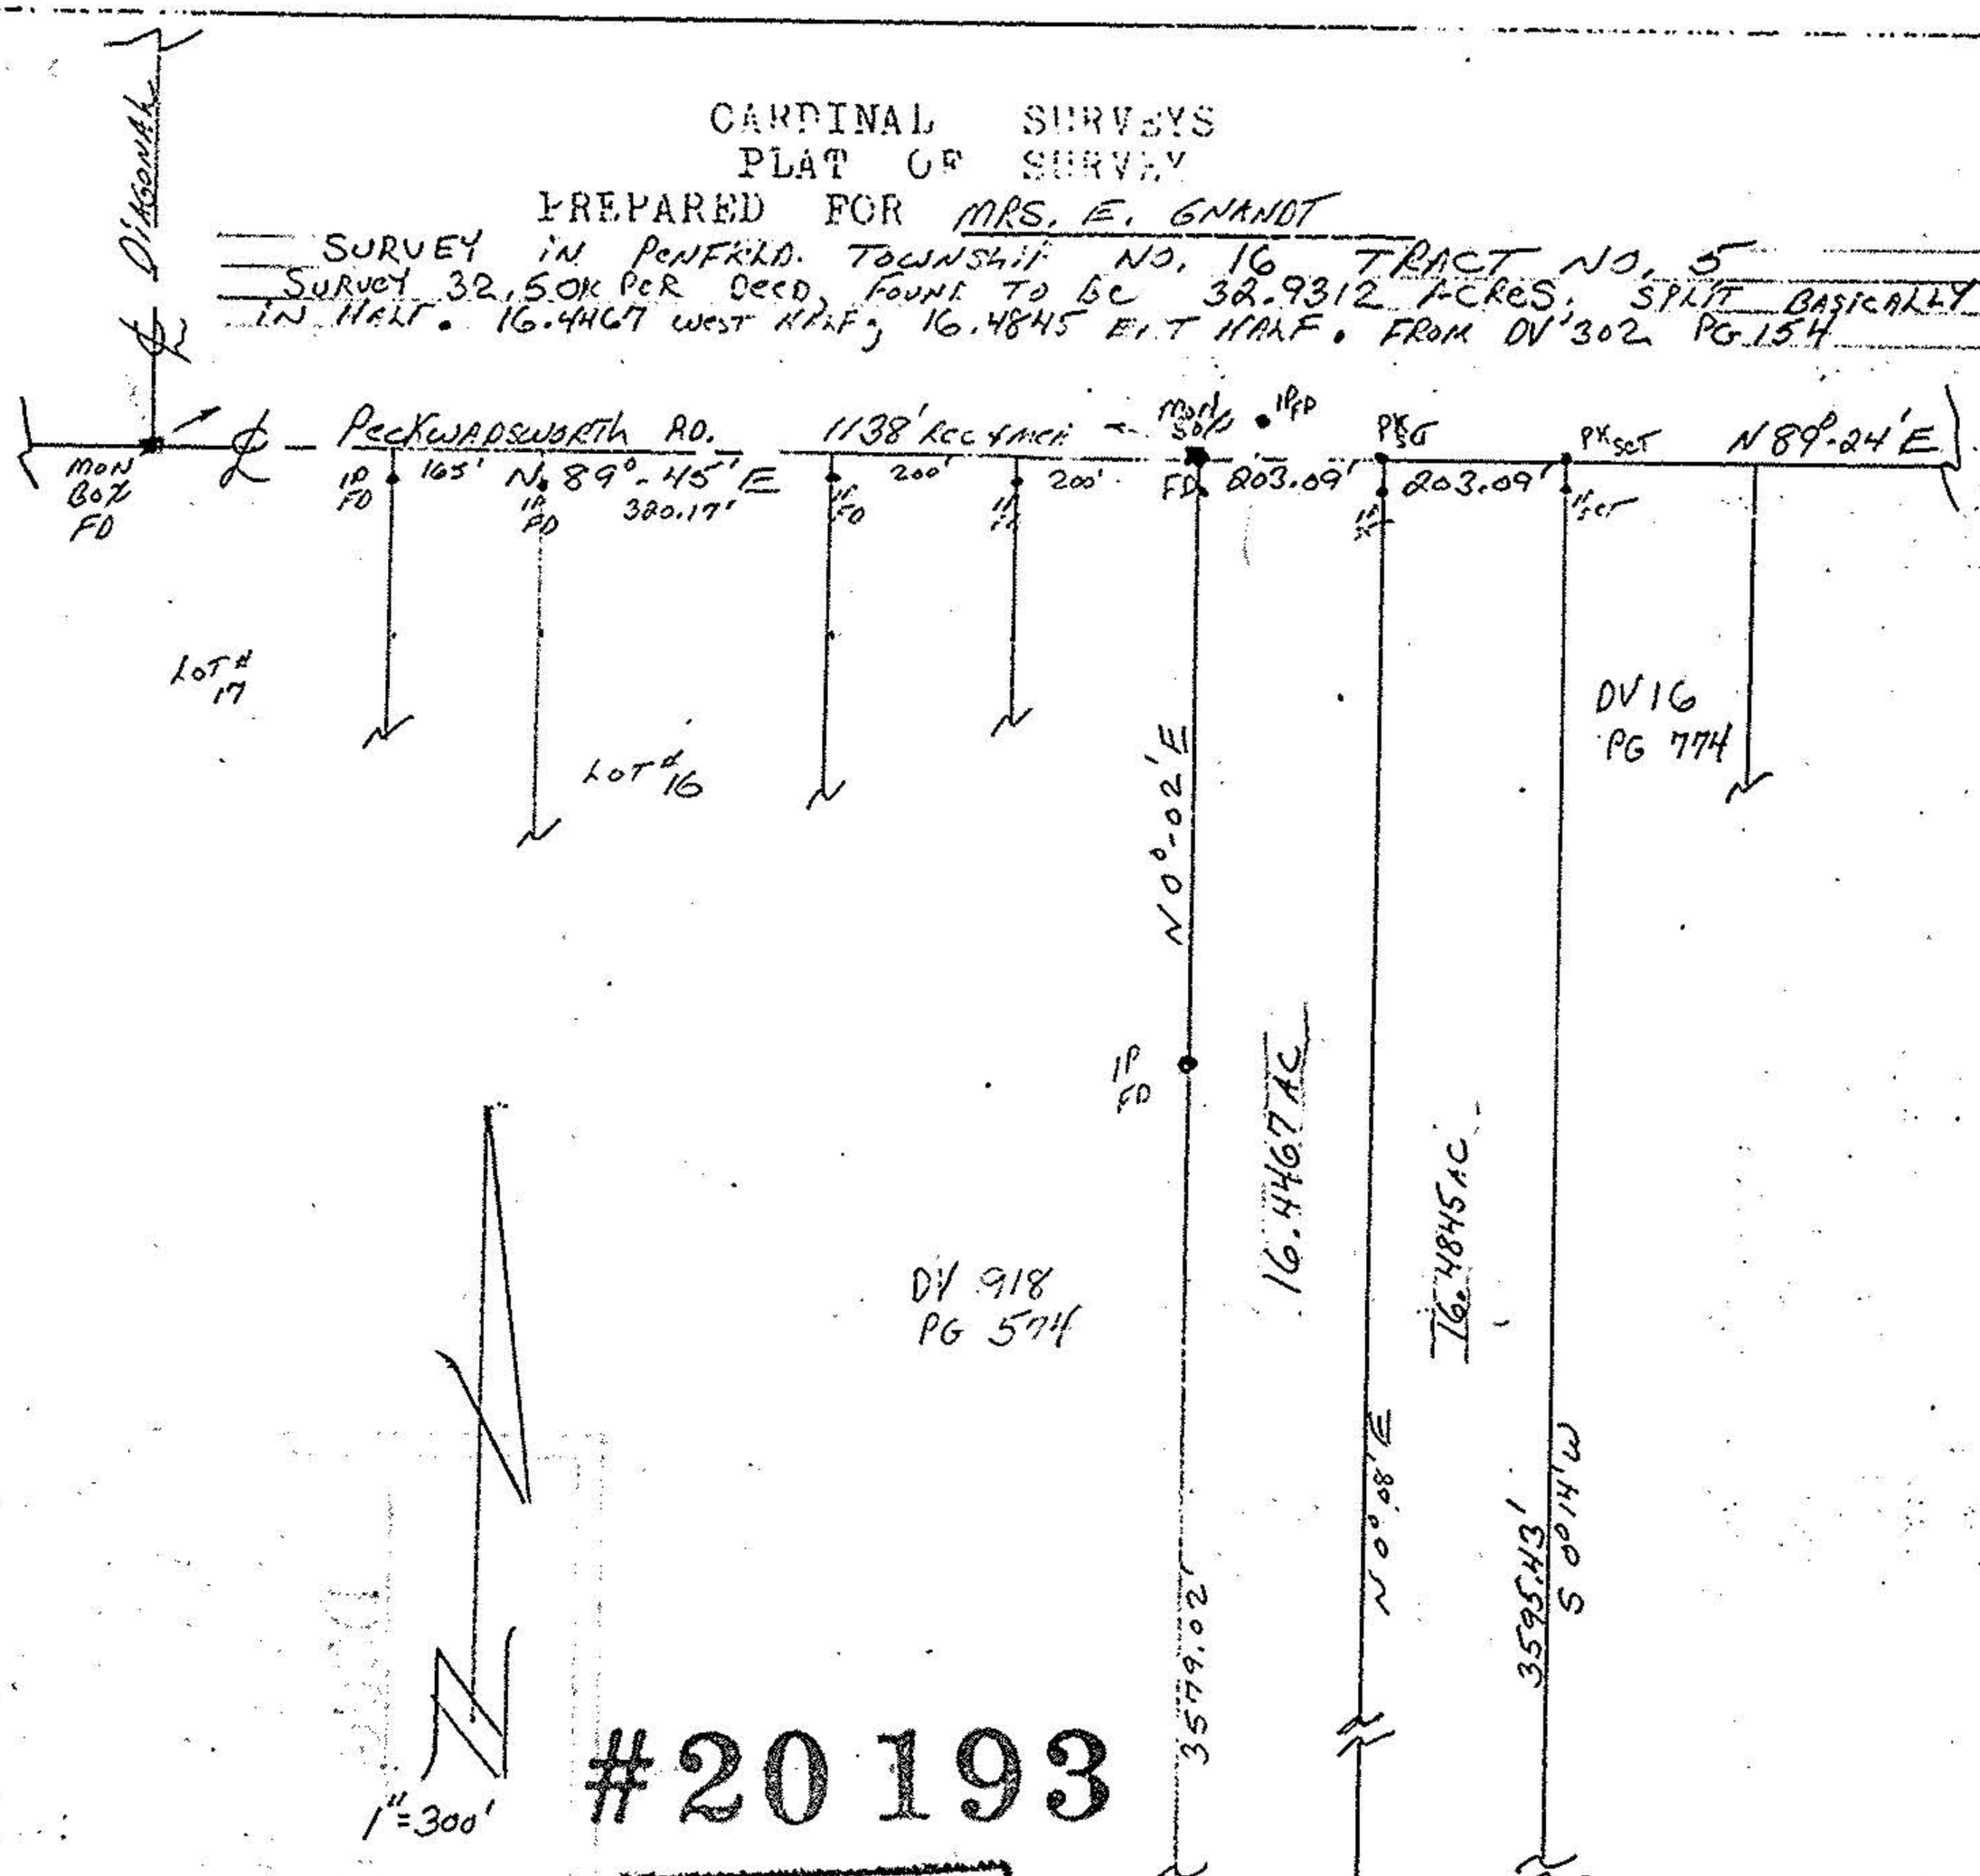

#20193

APPROVED
LORAIN CO.
MAP DEPT.
DATE 12/18/92
PAGE 19-A
BY T. Holust F. Colbert
VOID AFTER 20193

DATE: Nov. 27, 1992

SCALE: 1" = 300'

19-A

19-05-016-000