


19-A

#14182

19-05-017-000-003
19-05-018-000
19-06-116-000

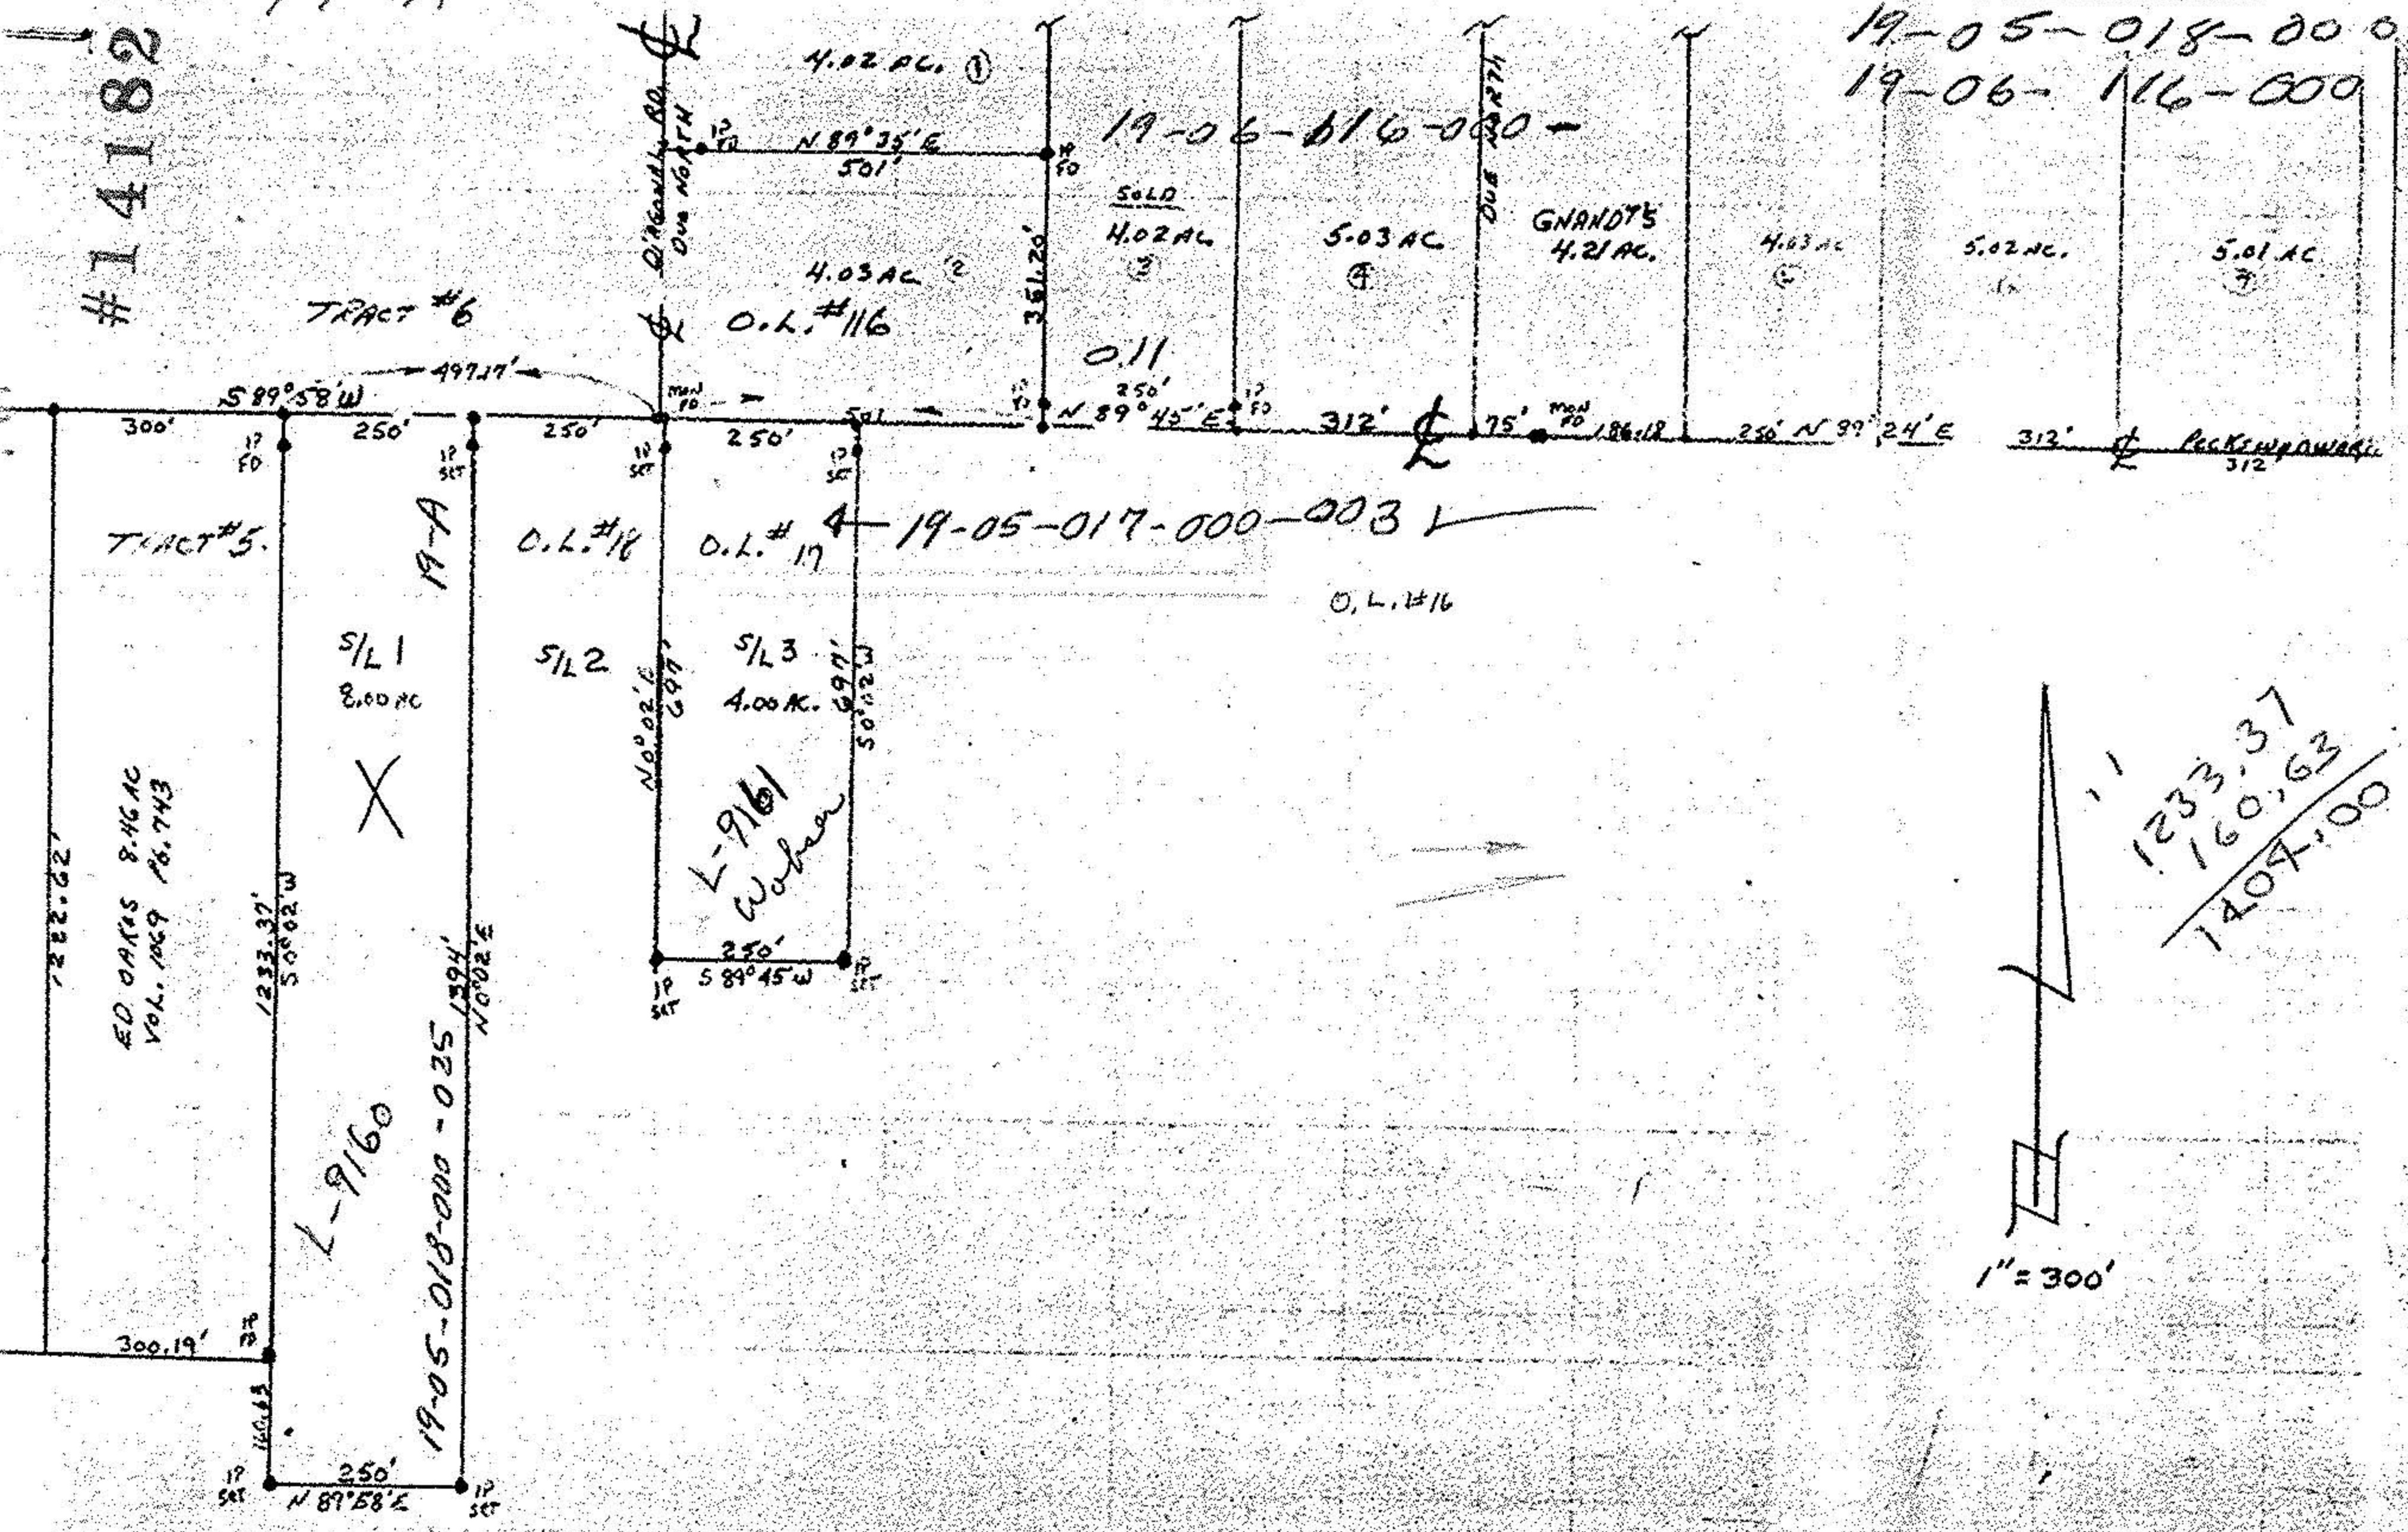

1233.37
160.63
1407.00

#14182