


CONRAD FARMS - AN OHIO PARTNERSHIP
D.V. 1283 P 833

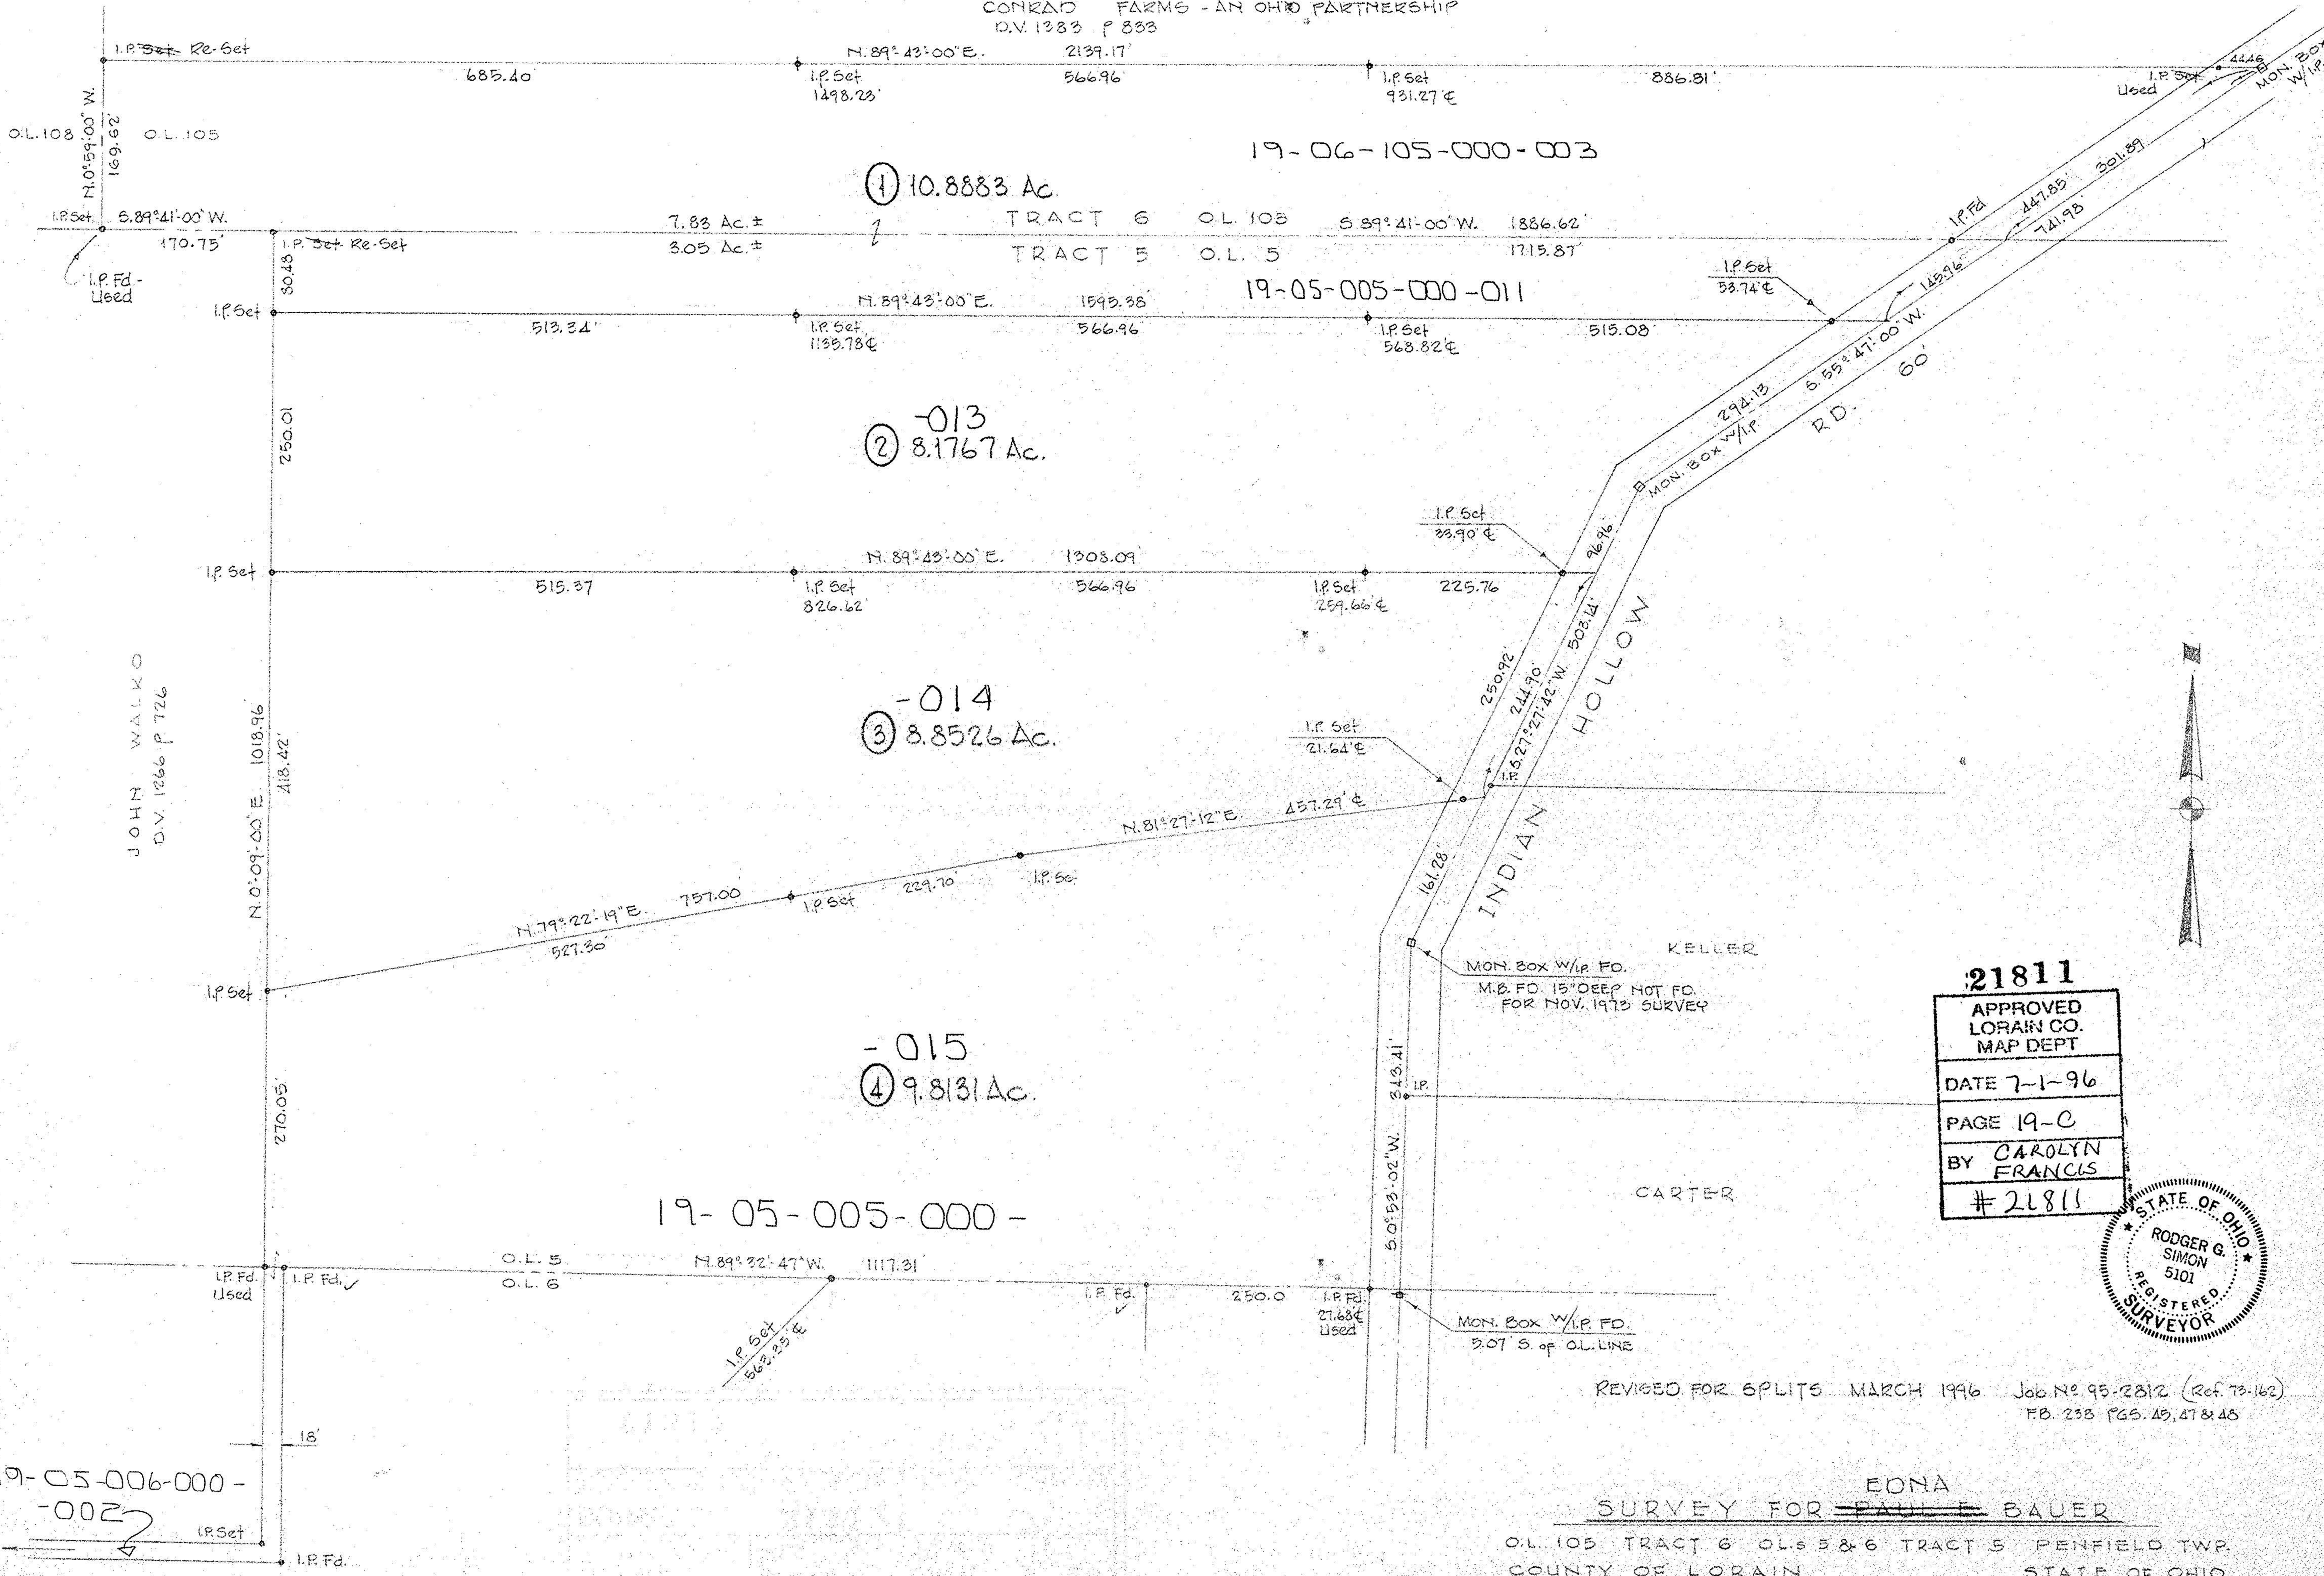

21811
APPROVED
LORAIN CO.
MAP DEPT
DATE 7-1-96
PAGE 19-C
BY CAROLYN
FRANCIS
#21811



REVISED FOR SPLITS MARCH 1996 Job No. 95-2812 (Ref. 73-162)
FB. 233 PGS. 45, 47 & 48

EDNA
SURVEY FOR PAUL E. BAUER
O.L. 105 TRACT 6 O.L. 5 & 6 TRACT 5 PENFIELD TWP.
COUNTY OF LORAIN STATE OF OHIO
SCALE 1"=100'
NOV. 1973
LAUNOON, SIMON, CAHL & ASSOC. - ENGINEERS & SURVEYORS

19-05-006-000-002
18' LANE TO LAGRANGE ROAD