MAP OF SURVEY AND LOT SPLIT

FOR

DONALD F. AND ELAINE F. EYRING

SITUATED IN THE TOWNSHIP OF PENFIELD, COUNTY OF LORAIN, STATE OF OHIO, AND KNOWN AS BEING PART OF ORIGINAL PENFIELD TOWNSHIP LOT NO. 8 IN SECTION TRACT 5.

NORTH
SCALE 1" = 100'

SURVEYOR'S STATEMENT

DISTANCES ARE EXPRESSED IN FEET AND DECIMAL PARTS THEREOF. BEARINGS ARE TO AN ASSUMED MERIDIAN AND ARE USED TO INDICATE ANGLES ONLY. IRON MONUMENTS WERE FOUND OR SET AS INDICATED HEREON ARE OF WHICH I DECLARE TO BE CORRECT.

Thomas M Snezek 3/19/92
THOMAS M. SNEZEK REG. #7051
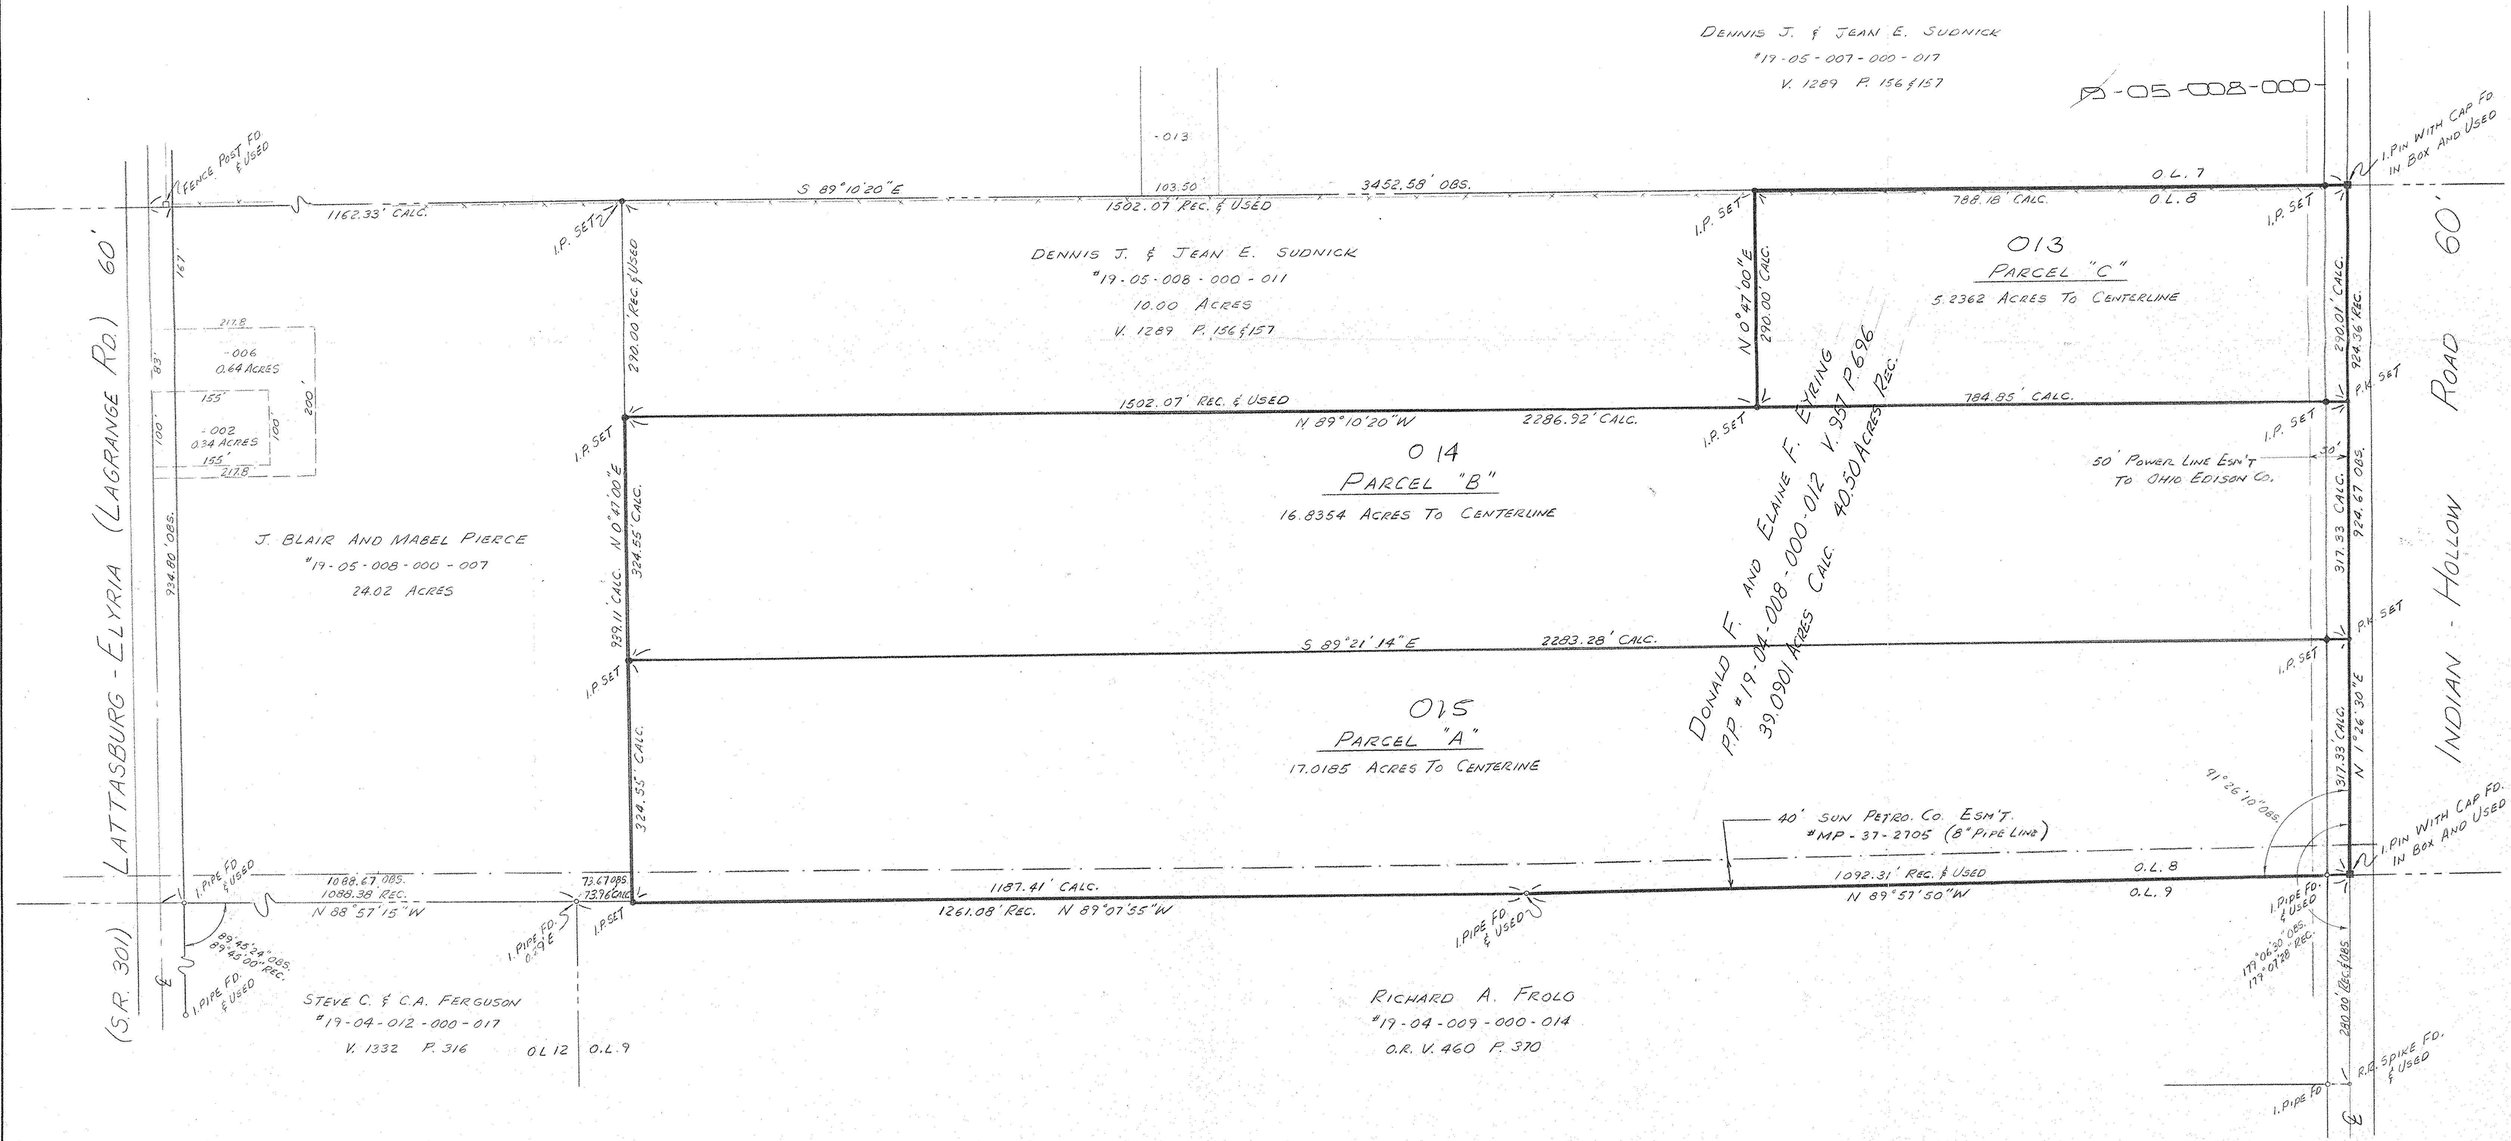
STATE OF OHIO THOMAS M. SNEZEK S-7051 SURVEYOR