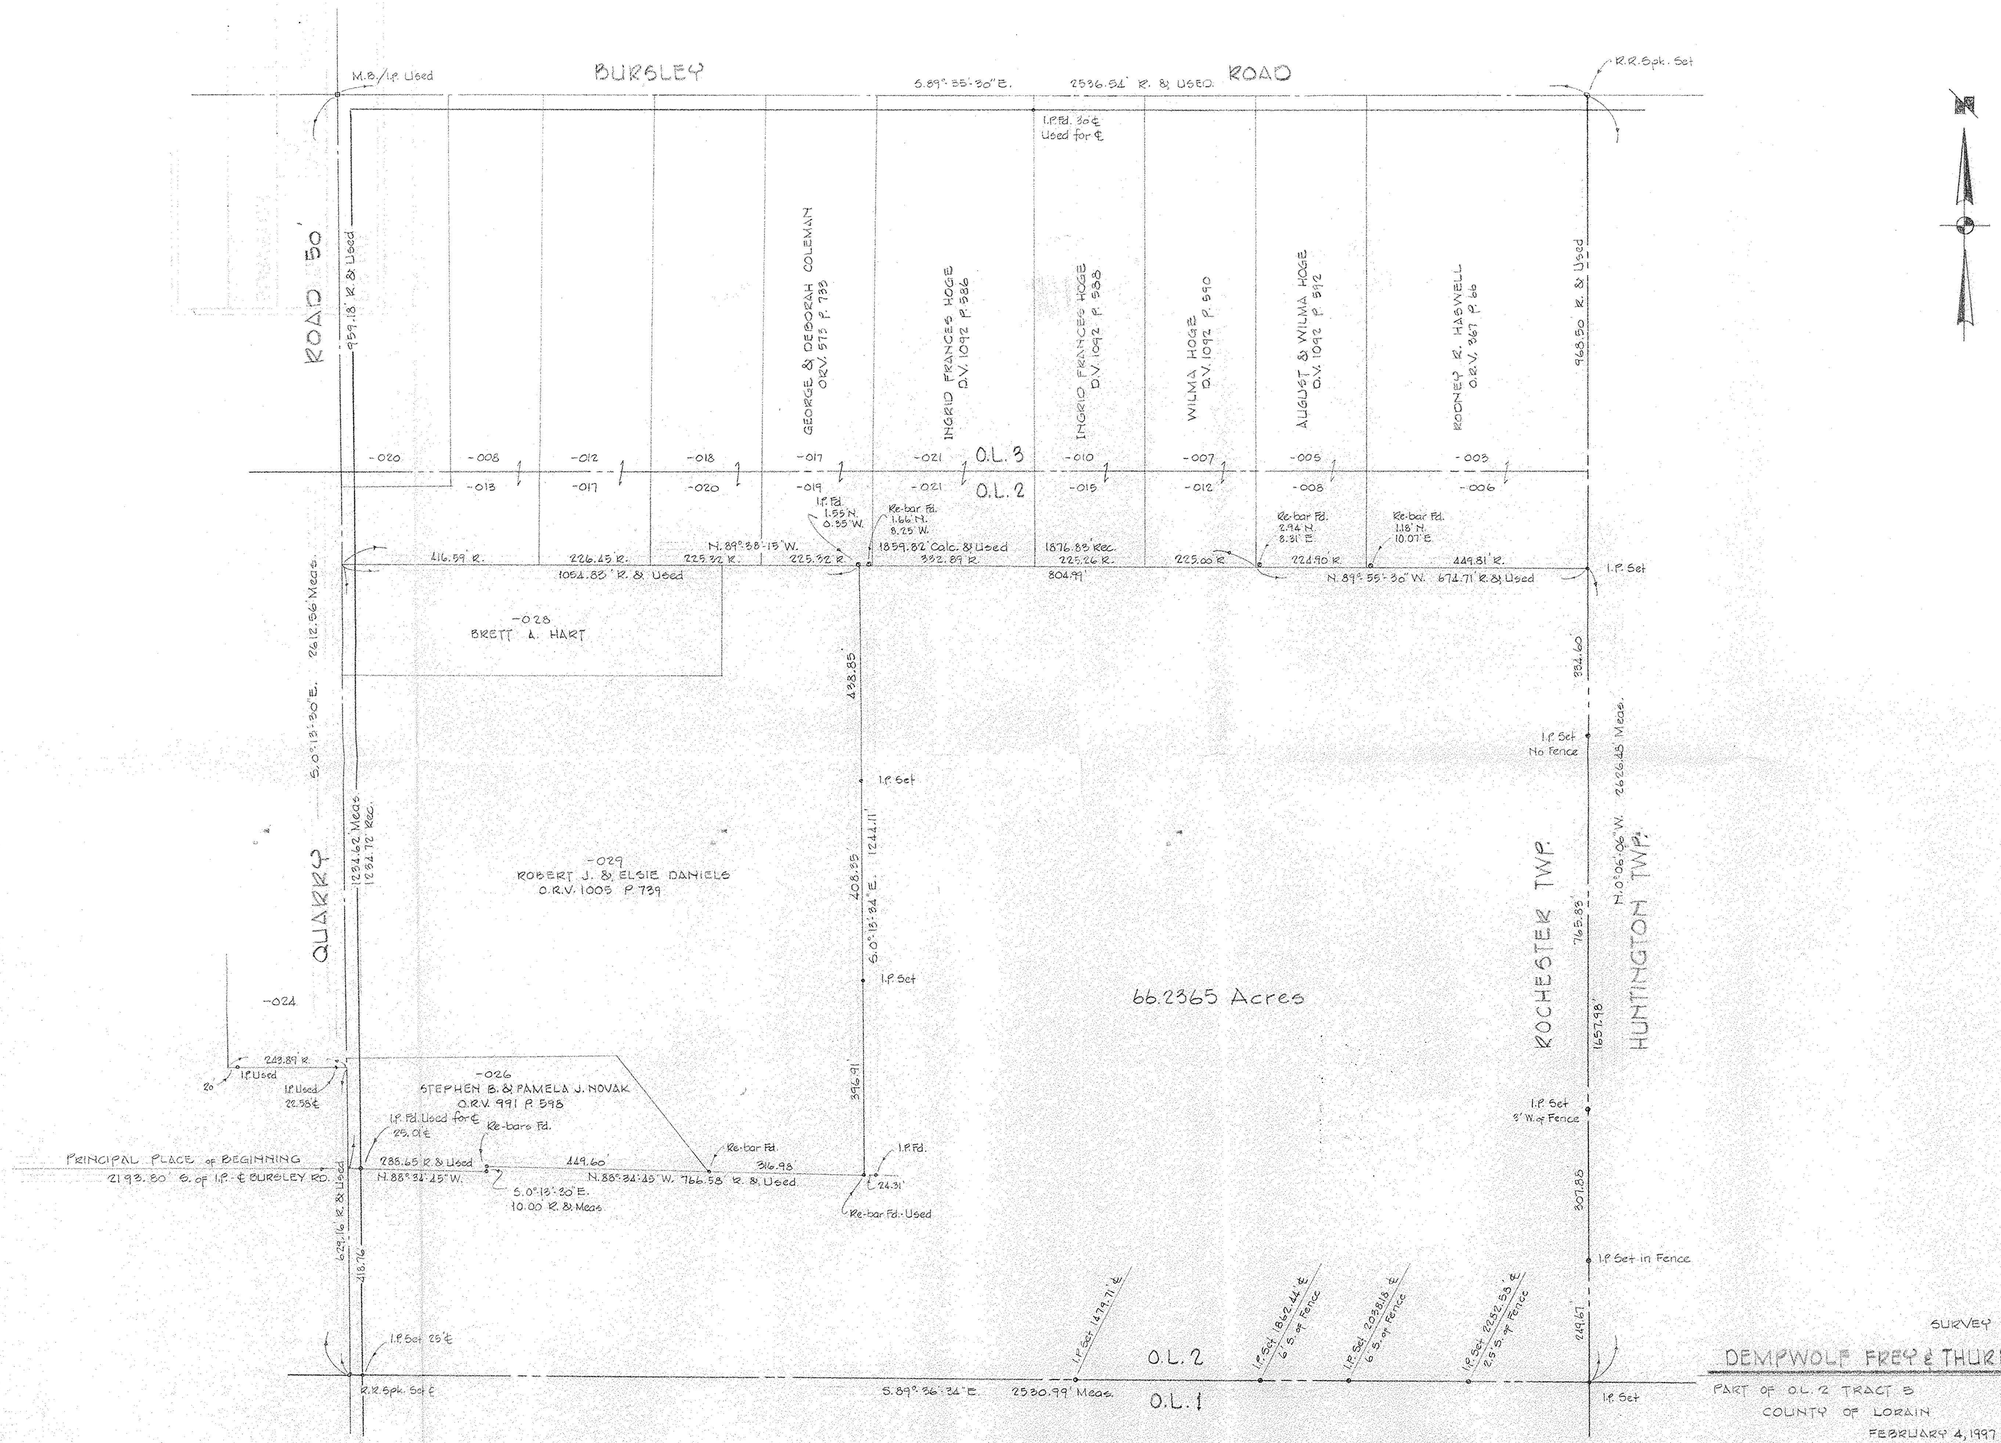

22063-D

APPROVED
LORAIN CO.
MAP DEPT.
DATE 2/6/97
PAGE 20-D
BY R. BELL
VOID AFTER # 220631 D

STATE OF OHIO
RODGER G. SIMON
5101
REGISTERED SURVEYOR

SURVEY FOR

DEMPWOLF FREY & THURMAN DOWNING, TRUSTEES

PART OF O.L. 2 TRACT 3 — TOWNSHIP OF ROCHESTER
COUNTY OF LORAIN — STATE OF OHIO

FEBRUARY 4, 1997 — SCALE 1"=150'

LAUNDON • SIMON • CAHL & ASSOC.
PROFESSIONAL LAND SURVEYORS
110 MIDDLE AVE. ELYRIA, O. 44035

JOB № 96-2923 F.B. 240 P. 32-35