

20-05-009-000

20-D

28
25
574

10531

20D

20-D

BURSLEY ROAD

5.89°07'E. 25.00' RR Spk. Fd. S.89°40'E. 289.00' Spt. Fd. 238.0' Spt. Fd. 752.00' S.89°17'E. 211.00'

IVORY SPARKS
2-13-73 D.V. 1070 PG. 414

50' EASEMENT FOR IRISH RD.

N.0°07'E.

269.90 X 25
Plat Vol 30
Pg 417

MAY 13 1977


1.9379 Acres

1.94
- 15.
1.79

CHESTER and JEAN LEWIS
4-16-73 D.V. 1073 PG. 106

S.0°07'W.

284.94' ±

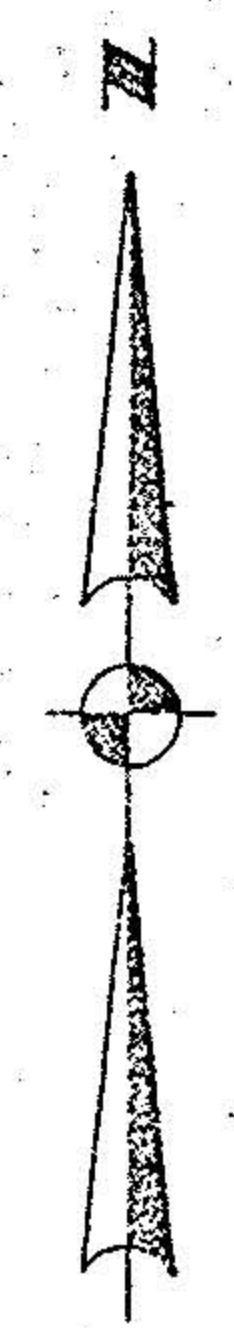

15' EASEMENT FOR DRIVEWAY

10' UTILITY EASEMENT

I.P. Set 5.89°42'W. 227.77'

R=220.70'
2-203.20' Δ=25°04'
88.90' Ch=88.19' N.77°46'W.

SURVEY FOR

IVORY SPARKS

O.L. 9 TRACT 5 ROCHESTER TWP.
LORAIN COUNTY OHIO
SCALE 1"=40' MARCH 17, 1977
LAUNDON • SIMON • CAHL & ASSOC.
ENGINEERS

322-3789
322-7625
20-05-009-000

11877-584
145-76