MAP OF SURVEY, LOT SPLIT AND ASSEMBLY

PREPARED FOR

DORIS IRISH, ETAL.

SITUATED IN THE TOWNSHIP OF ROCHESTER, COUNTY OF LORAIN, STATE OF OHIO AND BEING KNOWN AS PART OF ORIGINAL ROCHESTER TOWNSHIP TRACT 5, LOT 9

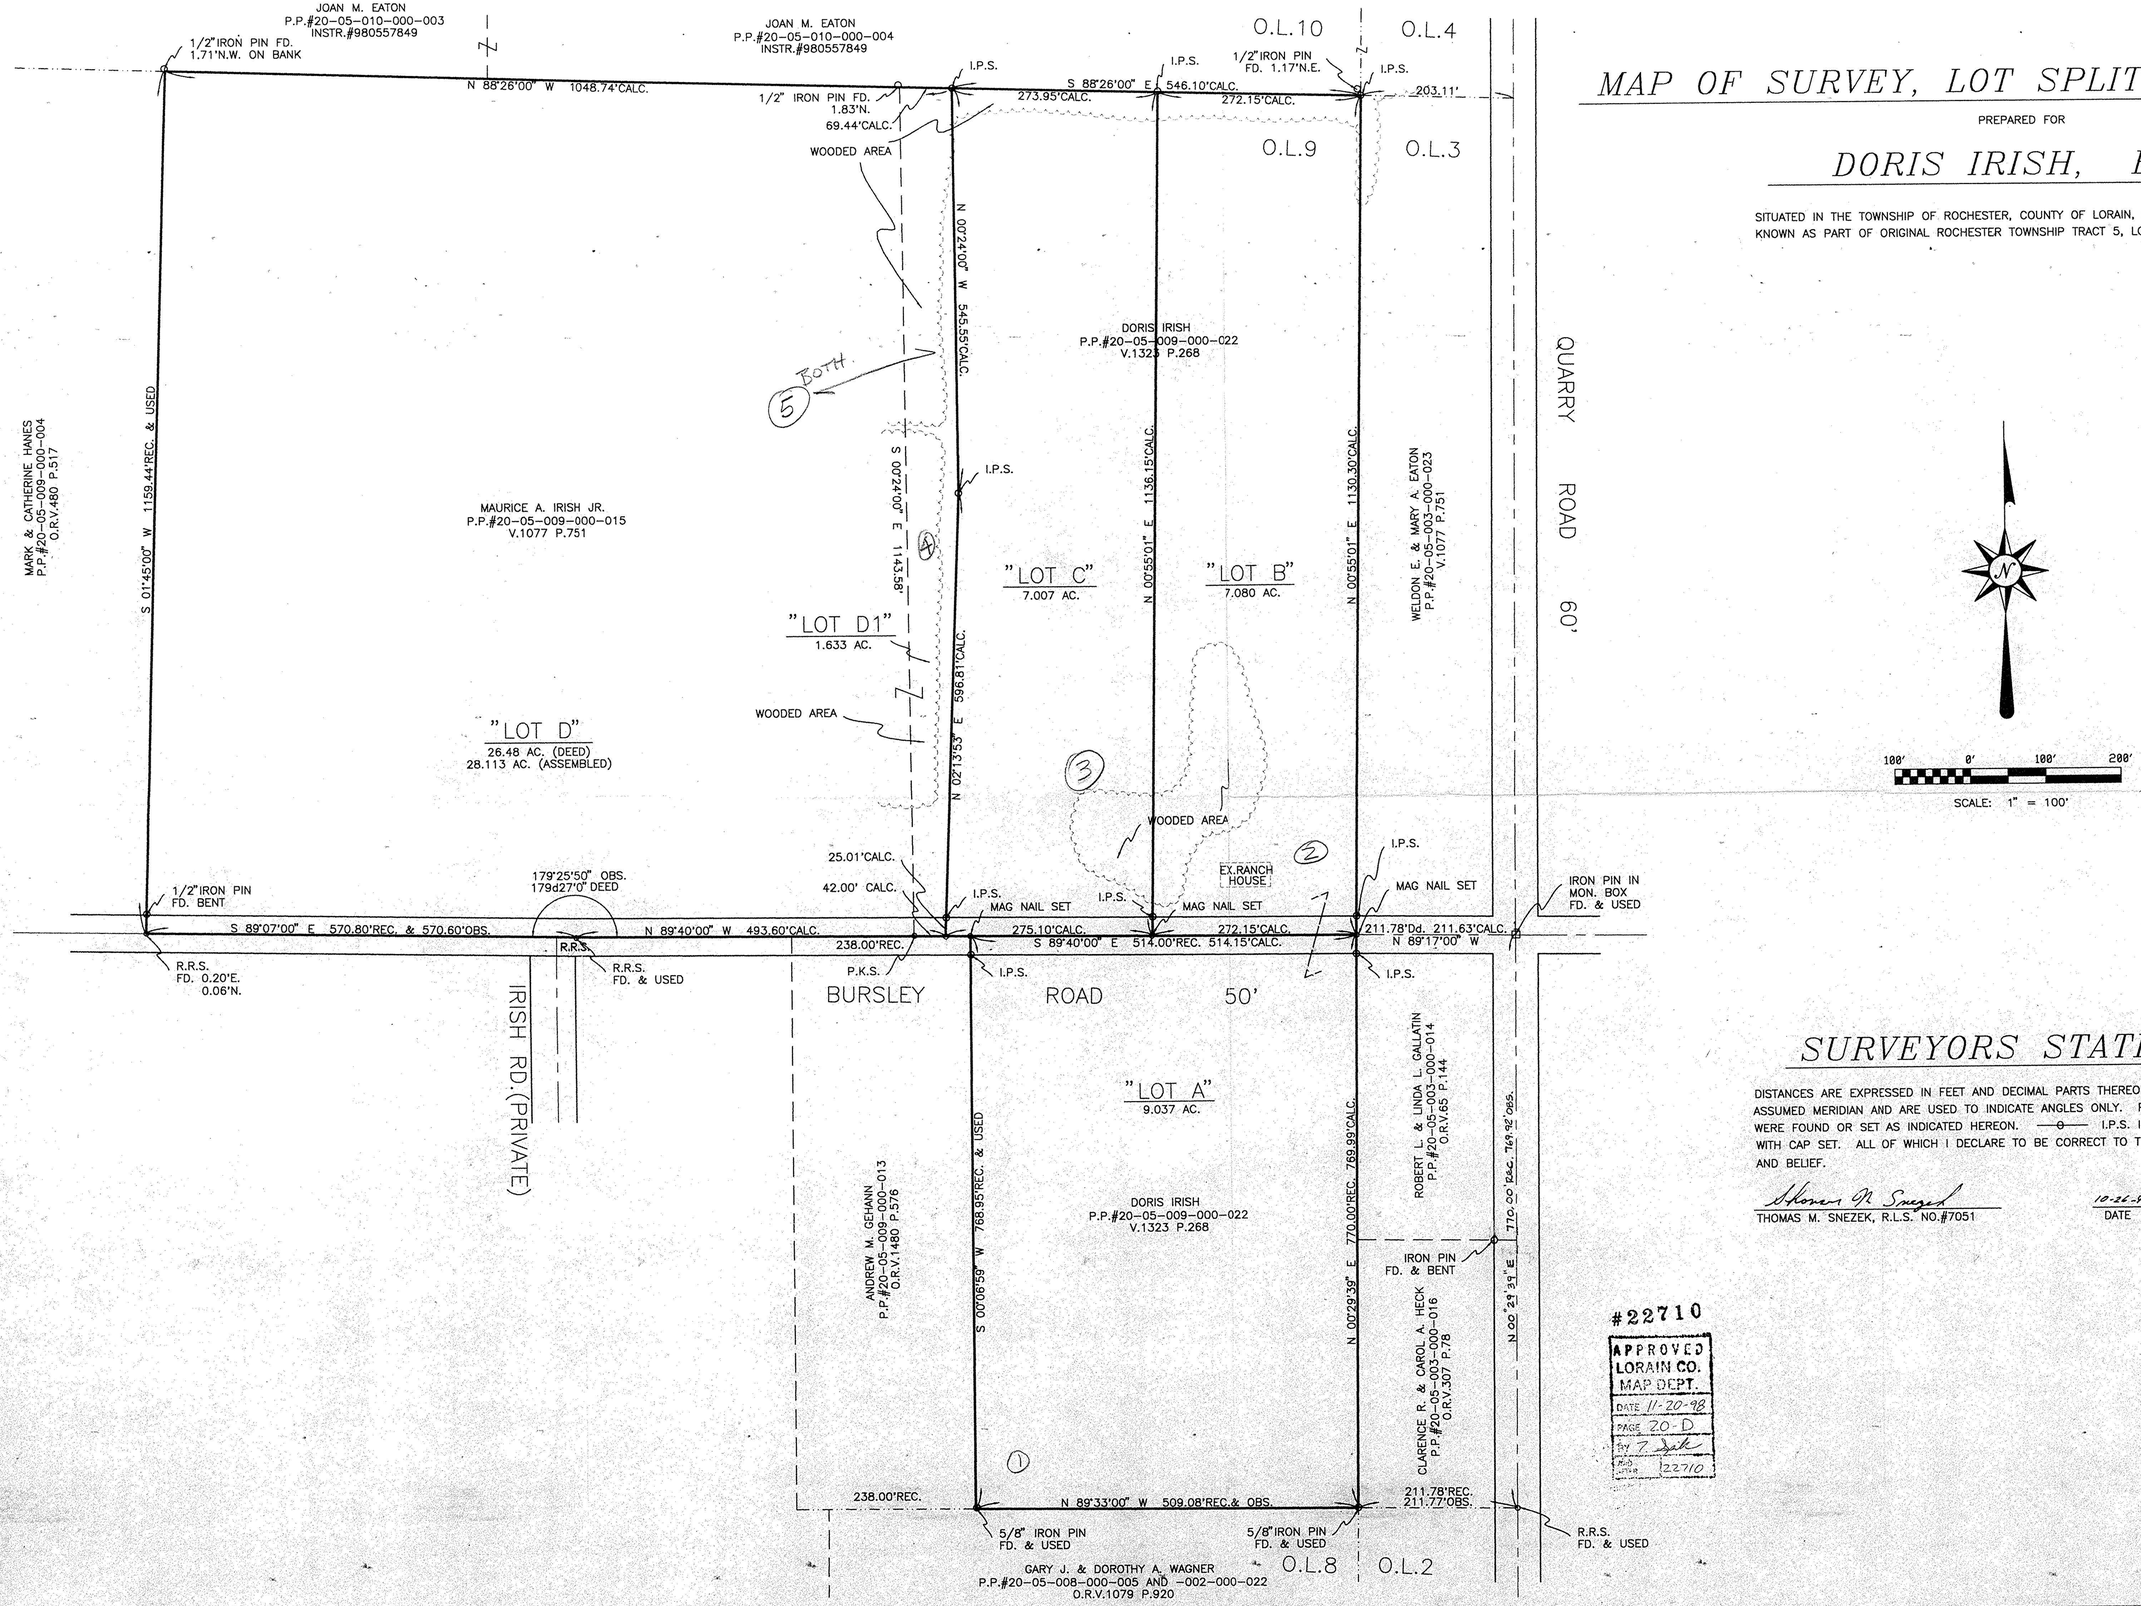

SURVEYORS STATEMENT

DISTANCES ARE EXPRESSED IN FEET AND DECIMAL PARTS THEREOF. BEARINGS ARE TO AN ASSUMED MERIDIAN AND ARE USED TO INDICATE ANGLES ONLY. PERMANENT MONUMENTS WERE FOUND OR SET AS INDICATED HEREON. —o— I.P.S. INDICATES A 5/8" IRON PIN WITH CAP SET. ALL OF WHICH I DECLARE TO BE CORRECT TO THE BEST OF MY ABILITIES AND BELIEF.

Thomas M. Snezek
THOMAS M. SNEZEK, R.L.S. NO.#7051

10-26-98
DATE

STATE OF OHIO
THOMAS M. SNEZEK
S-7051
SURVEYOR

#22710

APPROVED
LORAIN CO.
MAP DEPT.
DATE 11-20-98
PAGE 20-D
BY T Sak
MAP NO. 22710

PROJECT #9824 10/27/98