MAP OF SURVEY, LOT SPLIT, AND ASSEMBLY

PREPARED FOR

ROBERT L. KING REALTY COMPANY

SITUATED IN THE TOWNSHIP OF ROCHESTER, AND ROCHESTER VILLAGE, COUNTY OF LORAIN STATE OF OHIO AND BEING KNOWN AS PART OF ORIGINAL ROCHESTER TOWNSHIP TRACT 5, LOTS 21 AND 22

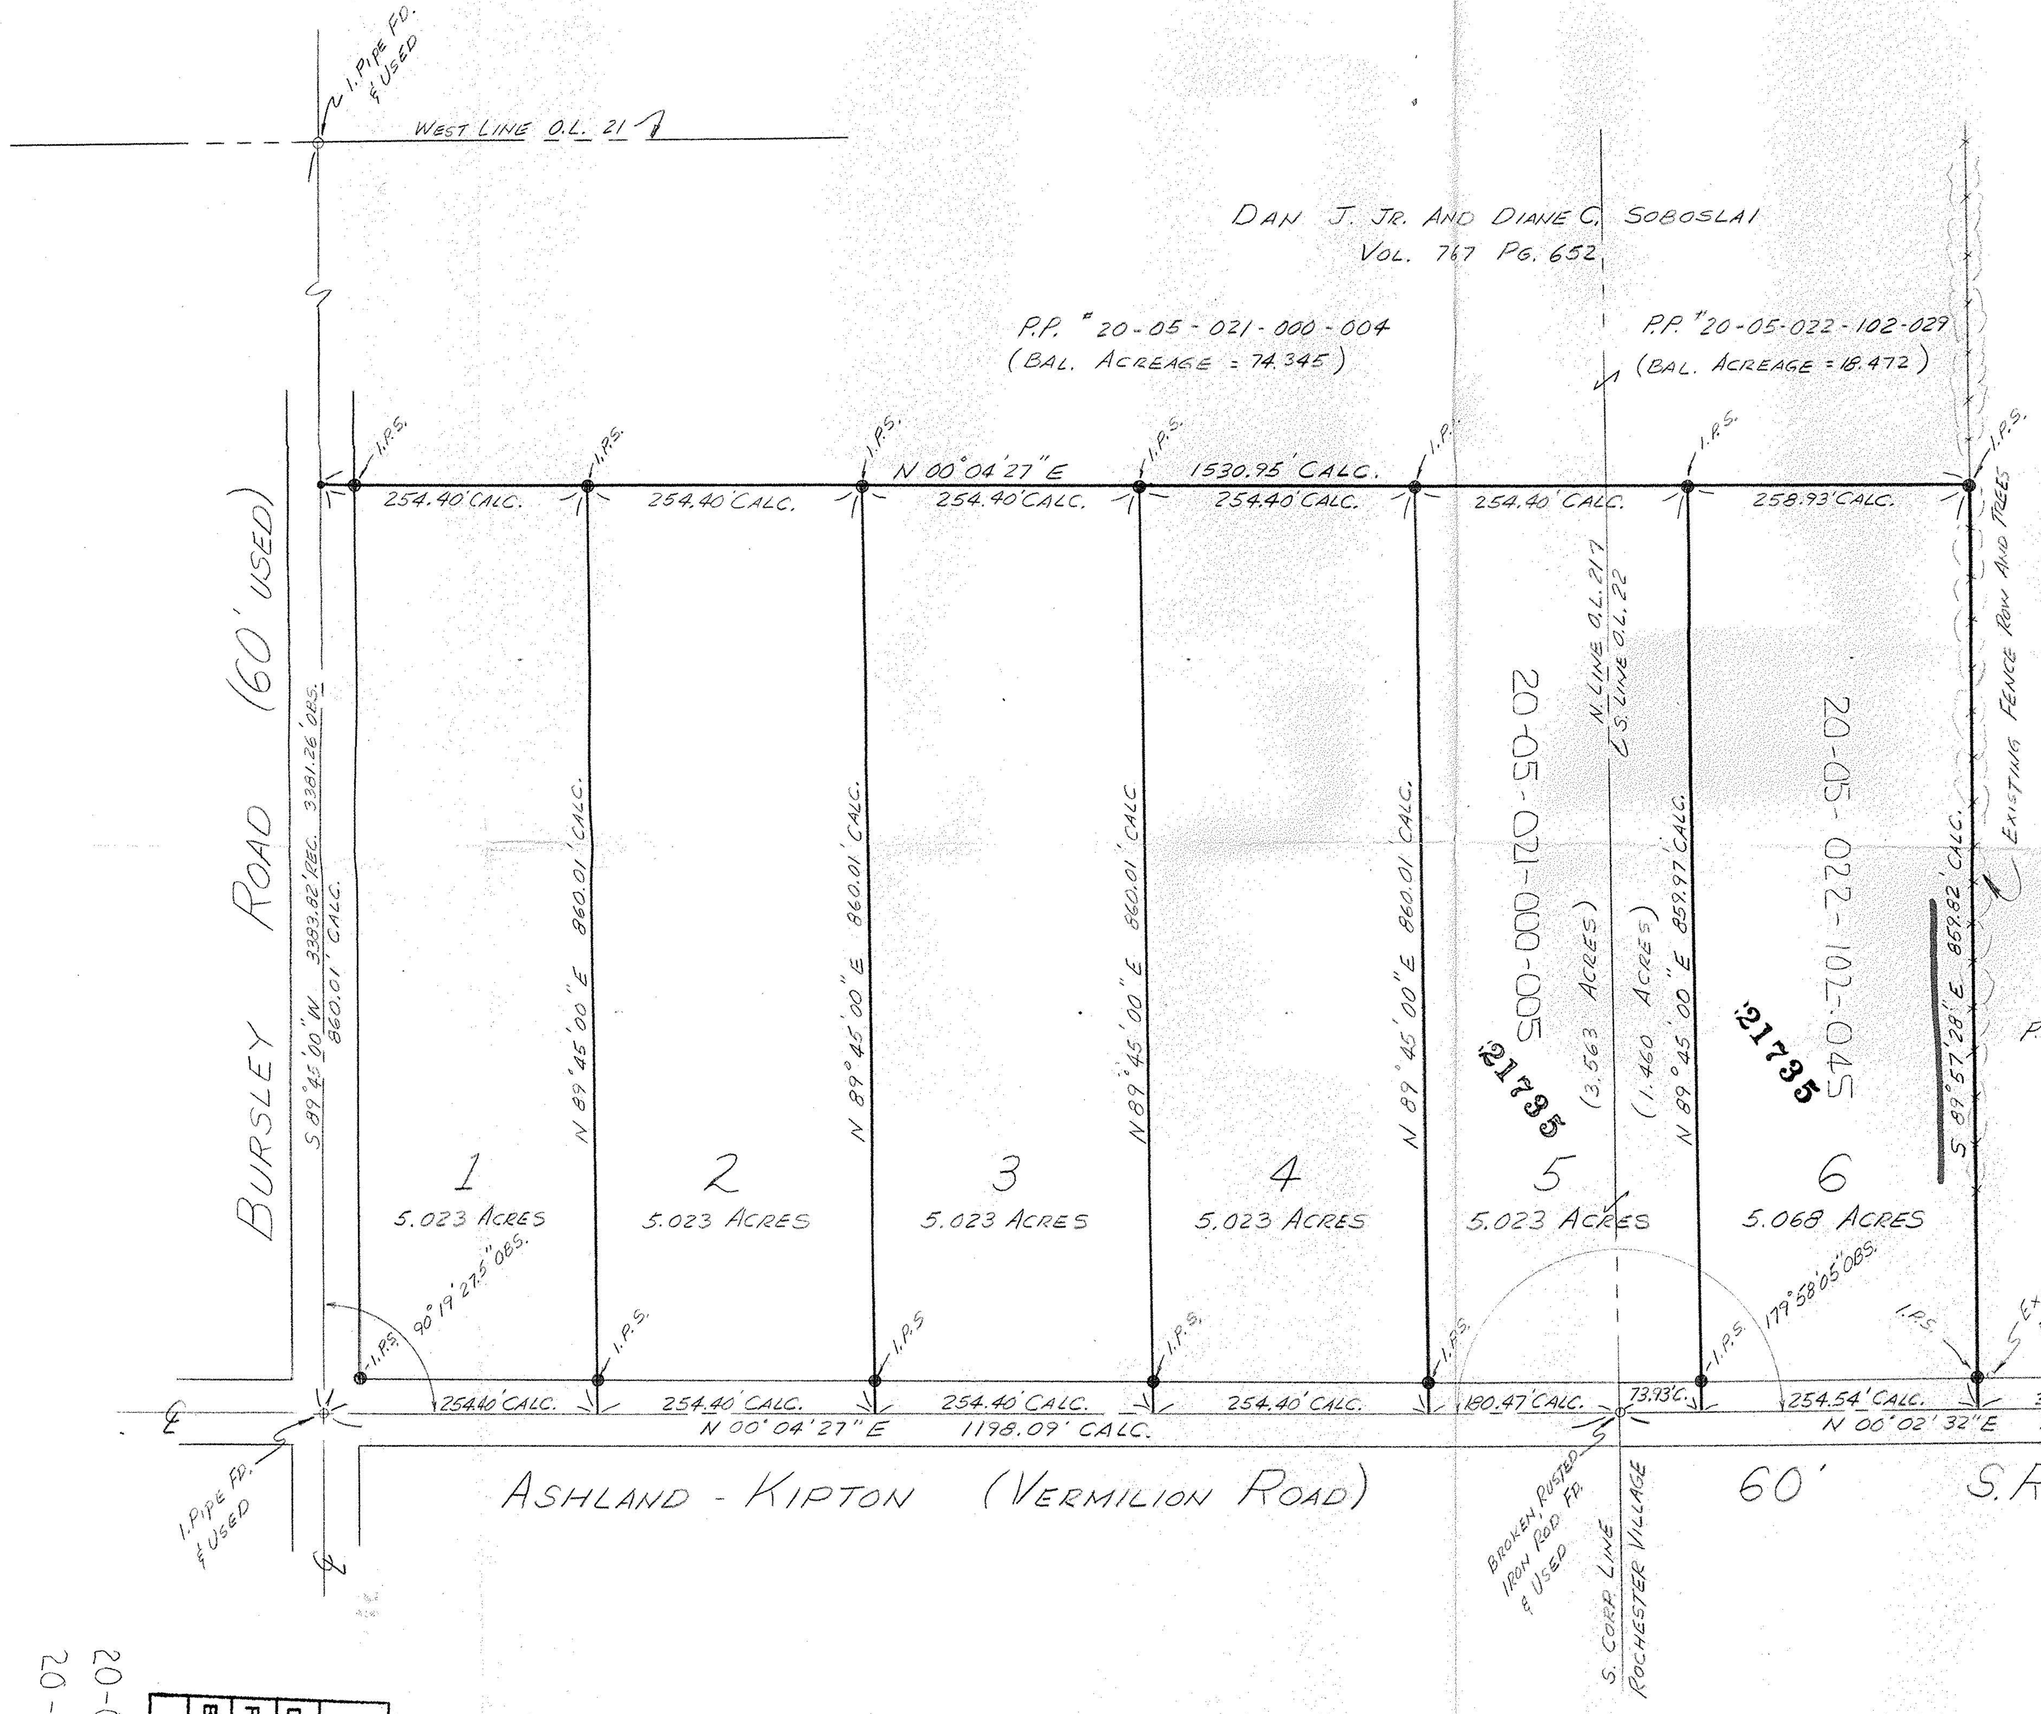

W
S N
E

SCALE 1" = 100'

SURVEYOR'S STATEMENT

DISTANCES ARE EXPRESSED IN FEET AND DECIMAL PARTS THEREOF. BEARING ARE TO AN ASSUMED MERIDIAN AND ARE USED TO INDICATE ANGLES ONLY. PERMANENT MONUMENTS WERE FOUND OR SET AS INDICATED HEREON. ALL OF WHICH I DECLARE TO BE CORRECT TO THE BEST OF MY ABILITY AND BELIEF.

Thomas M Snezek
THOMAS M. SNEZEK, P.S.-7051

REV 4-19-96
1-15-96
DATE

STATE OF OHIO
THOMAS M. SNEZEK
S-7051
SURVEYOR

21735
APPROVED
LORAIN CO.
MAP DEPT.
DATE 4-23-96
PAGE 20-05-022-B
BY C. ARDLYN FRANCIS
#21735

20-05-022-102-
20-05-021-000-

20-C

9601