LORAIN COUNTY, OHIO
ROCHESTER TOWNSHIP
ORIGINAL LOT NO. 27

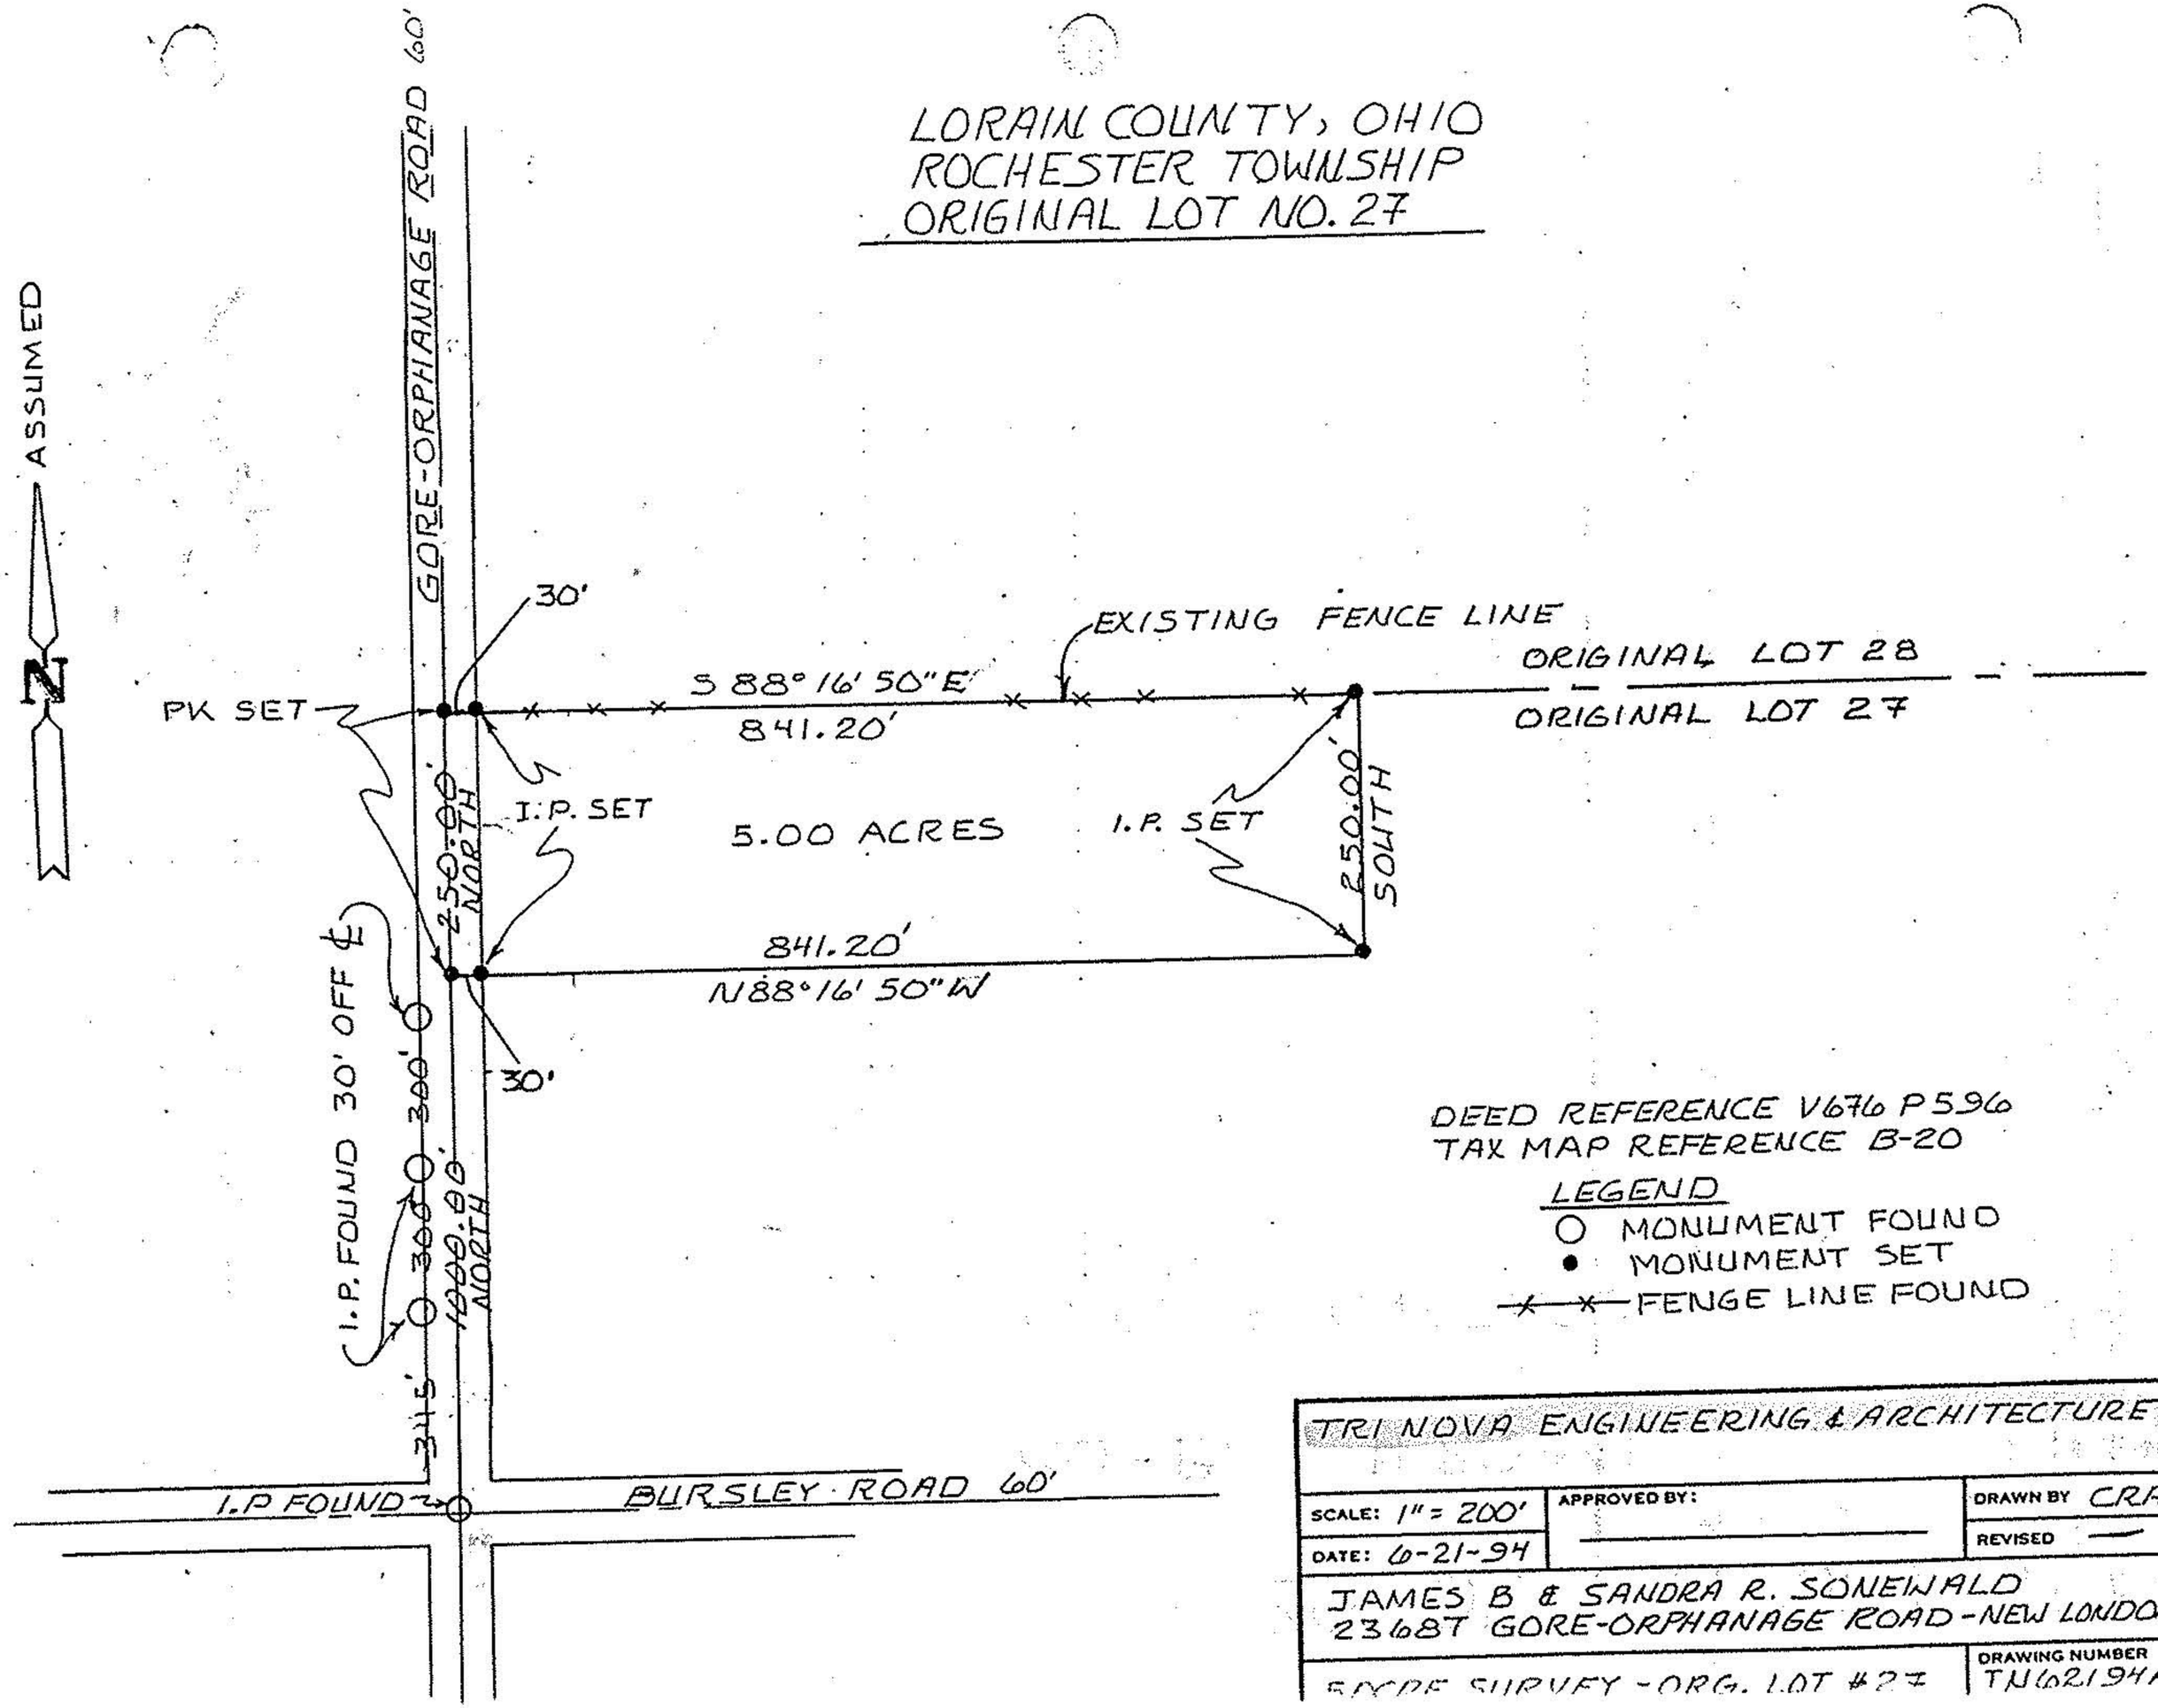

DEED REFERENCE V676 P596
TAX MAP REFERENCE B-20

LEGEND

- ○ MONUMENT FOUND
- ● MONUMENT SET
- —x—x— FENCE LINE FOUND

TRI NOVA ENGINEERING & ARCHITECTURE		
SCALE: 1" = 200'	APPROVED BY:	DRAWN BY CRA
DATE: 6-21-94		REVISED —
JAMES B & SANDRA R. SONEWALD 23687 GORE-ORPHANAGE ROAD - NEW LONDON		
BOUNDARY SURVEY - ORG. LOT #27		DRAWING NUMBER TN62194A