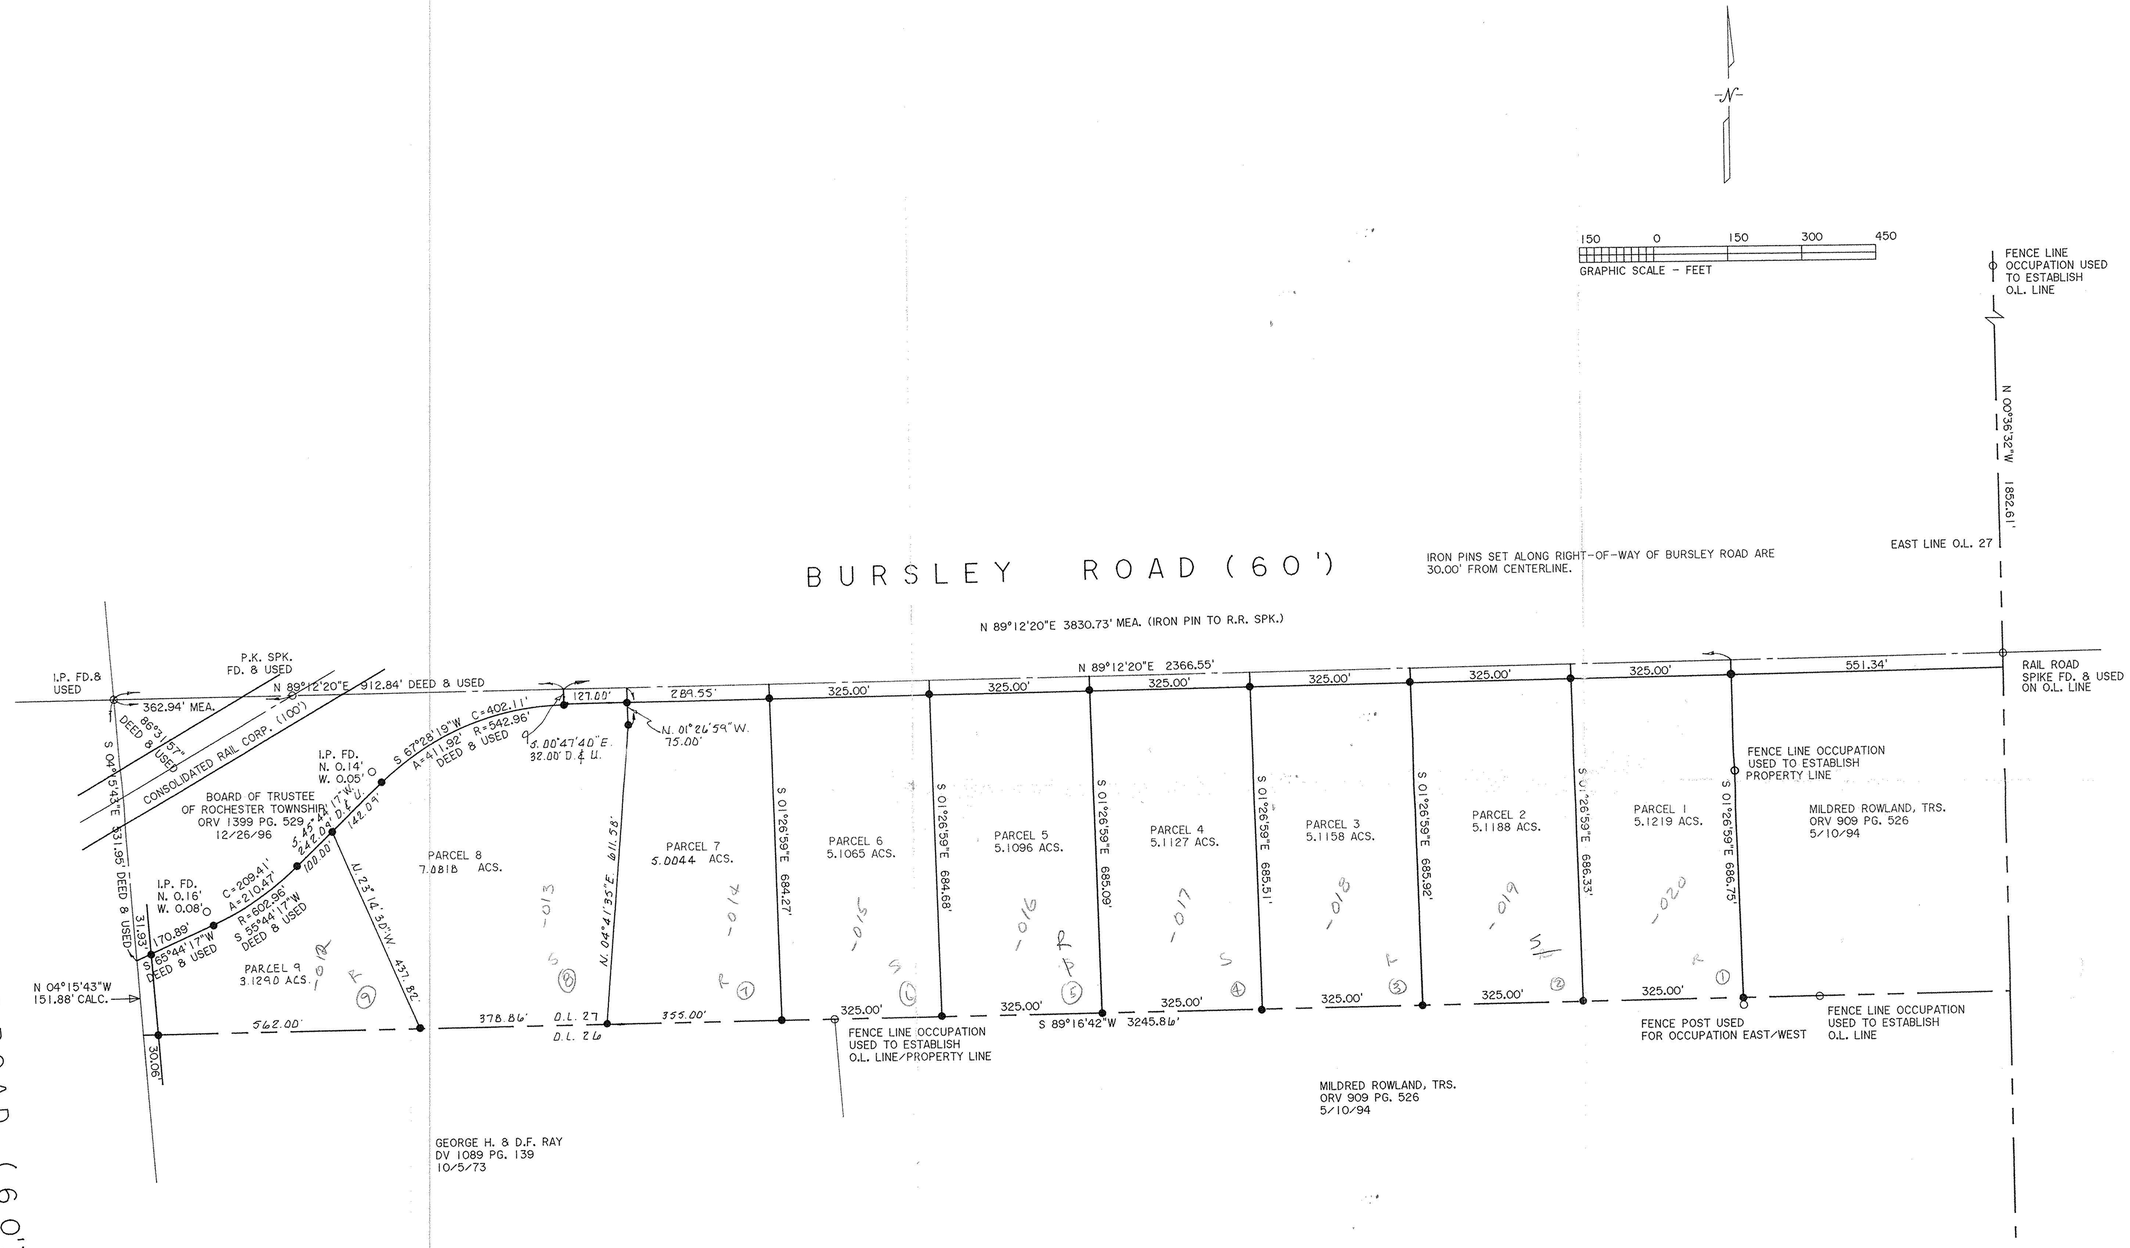

DIMENSIONS SHOWN ON THIS PLAT ARE EXPRESSED IN FEET AND DECIMAL PARTS THEREOF, ALL BEARINGS ARE TO AN ASSUMED MERIDIAN AND ARE USED TO INDICATE ANGLES ONLY. PERMANENT MONUMENTS WERE FOUND OR SET AT ALL POINTS INDICATED HEREON, ALL OF WHICH I CERTIFY TO BE CORRECT.

STATE OF OHIO THOMAS A. SIMON S-7775 REGISTERED PROFESSIONAL SURVEYOR

THOMAS A. SIMON
REG. PROFESSIONAL SURVEYOR
NO. S-7775

● INDICATES IRON PIN SET, 5/8" DIAMETER, 30" LONG WITH CAP "T. SIMON, S-7775"

PLAT OF SURVEY AND SPLIT
FOR
RANDY WOLF

BEING KNOWN AS PART OF ORIGINAL ROCHESTER TOWNSHIP LOT NO. 27, TRACT 5

COUNTY OF LORAIN STATE OF OHIO

FEB. 1998 SCALE: 1" = 150'

#22578

APPROVED LORAIN CO. MAP DEPT.
DATE 7/8/98
PAGE 20-B
BY TJS
VOID AFTER 22578

JOB NO. 98-007

THOMAS SIMON & ASSOCIATES, INC.
PROFESSIONAL LAND SURVEYORS
28901 CLEMENS ROAD
SUITE 119
WESTLAKE, OHIO 44145
(216) 871-1391
FAX (216) 871-7335