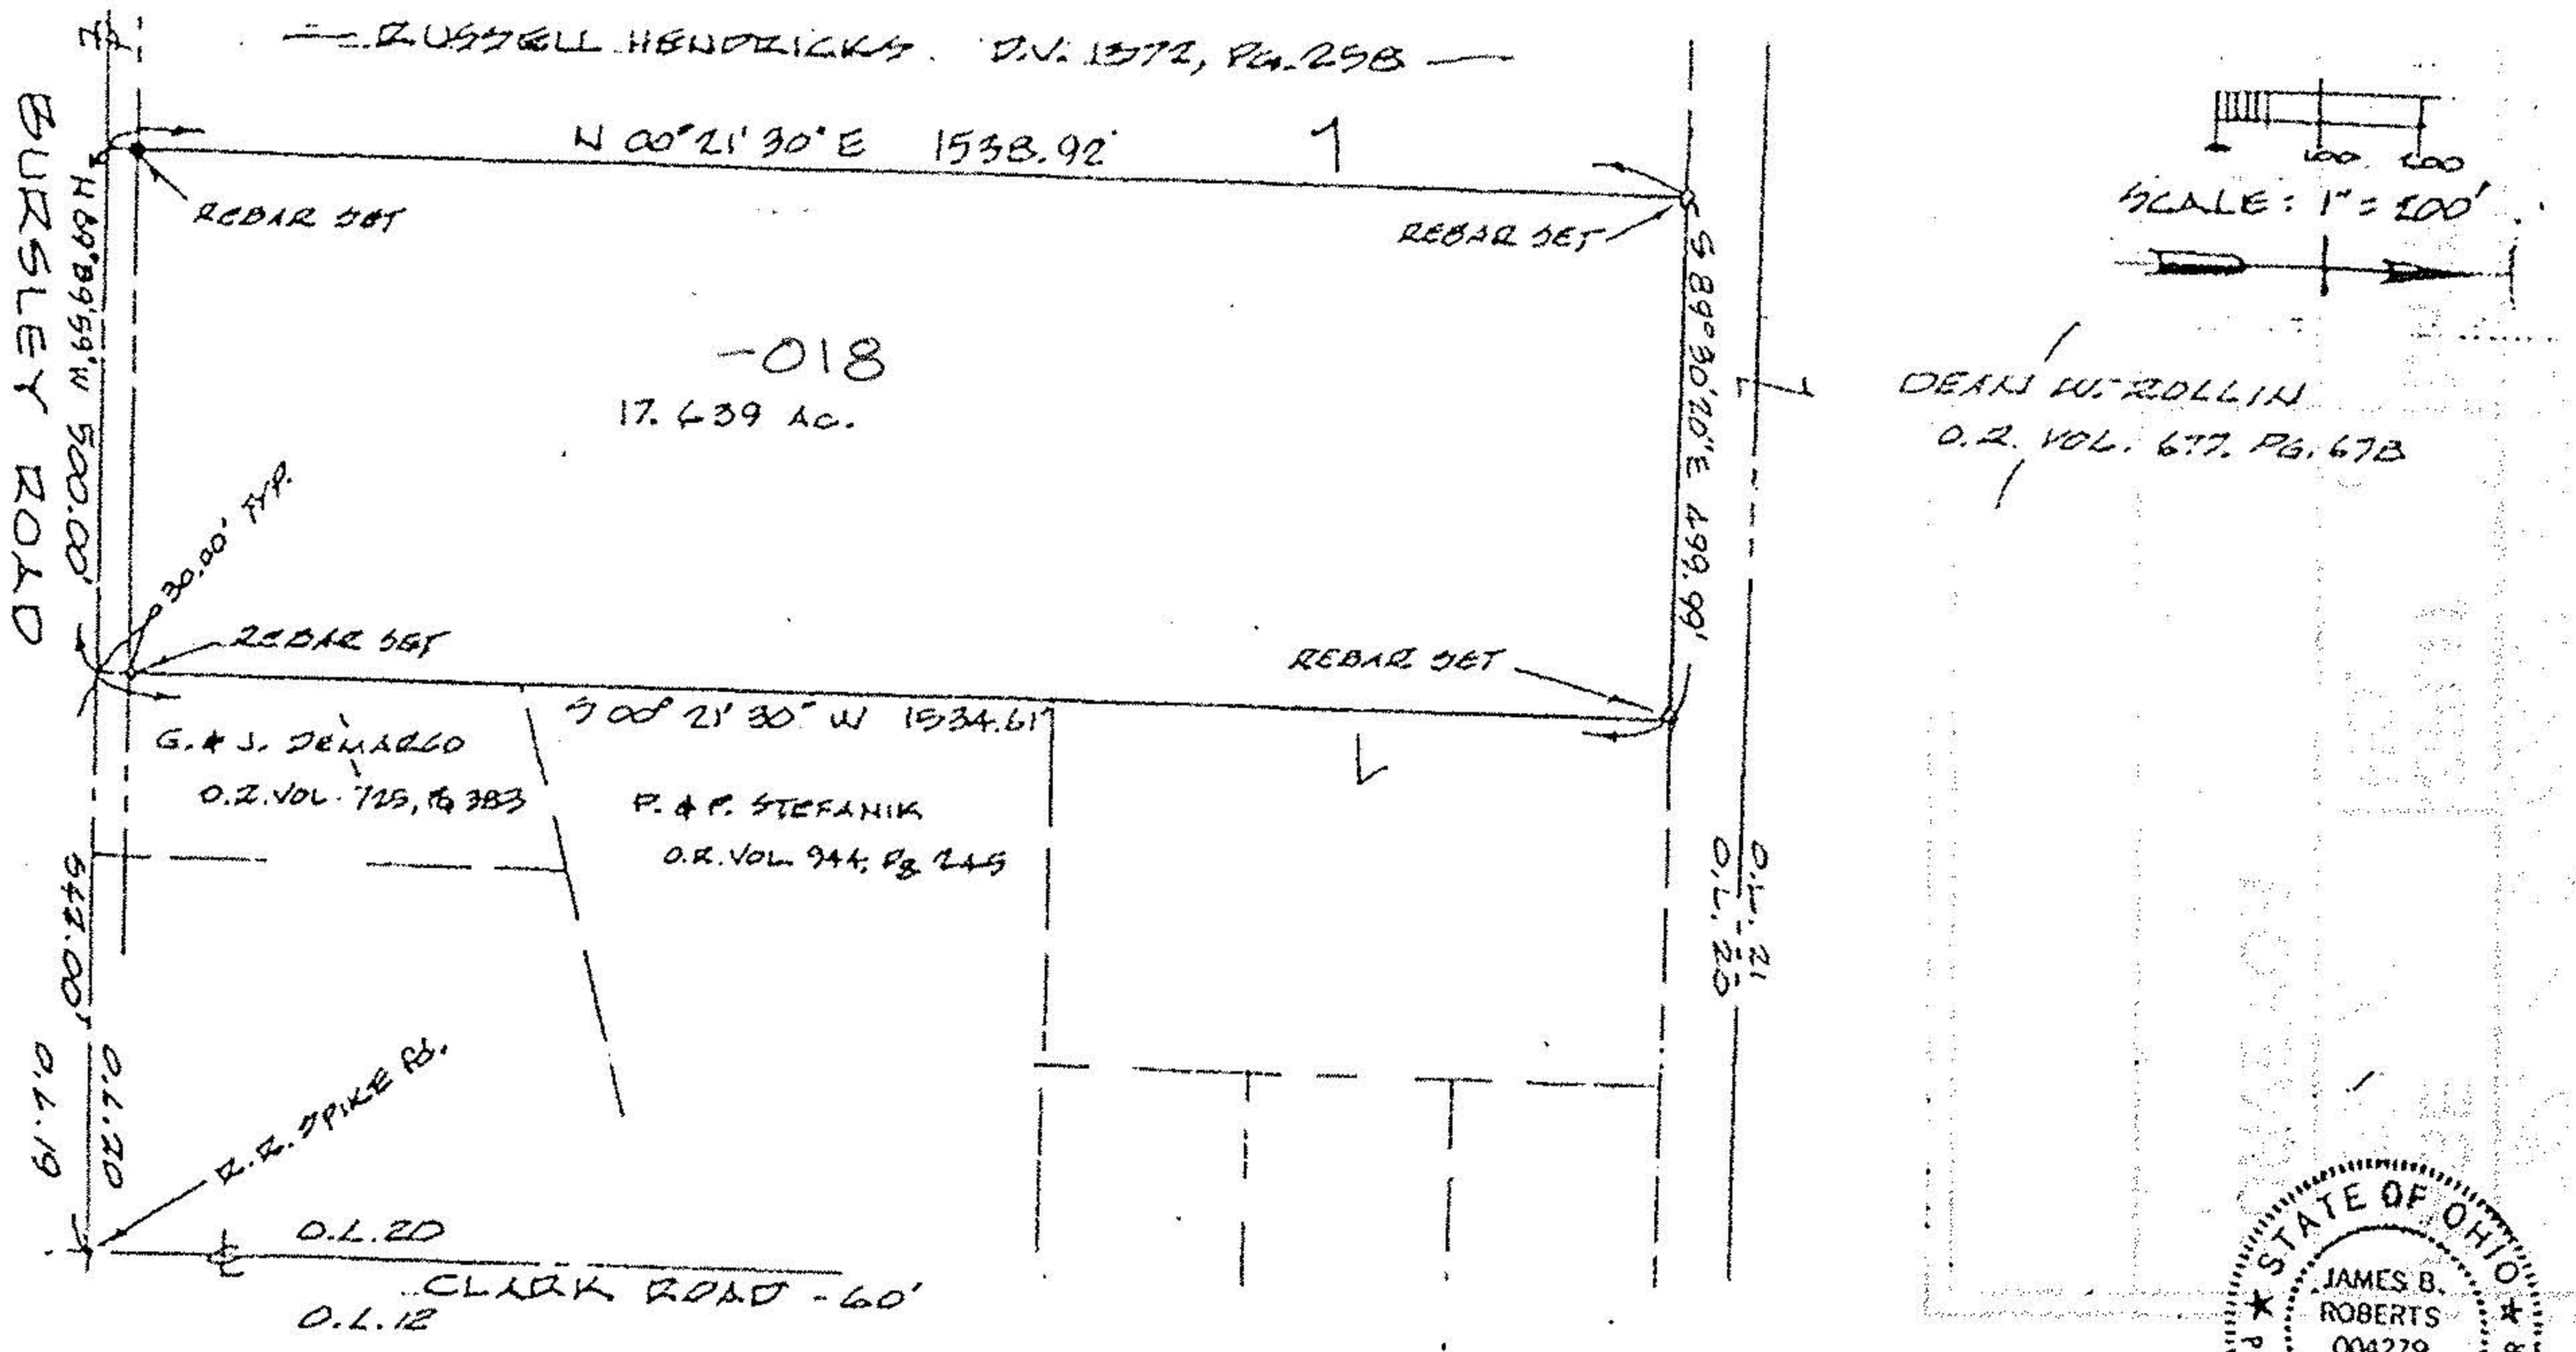

MAP OF PARCEL SPLIT SURVEY
PREPARED FOR RUSSELL HENDRICKS
PART OF ORIG. HUNTINGTON TWP. LOT NO. 20, TR. 5
TOWNSHIP OF HUNTINGTON, LORAIN COUNTY, OHIO
REF: SPLIT FROM P.P. #21-05-020.000-017

V.E. McCARTNEY & ASSOCIATES INC.
ENGINEERS - SURVEYORS
ELYRIA, OHIO
JULY, 1996 #96568T