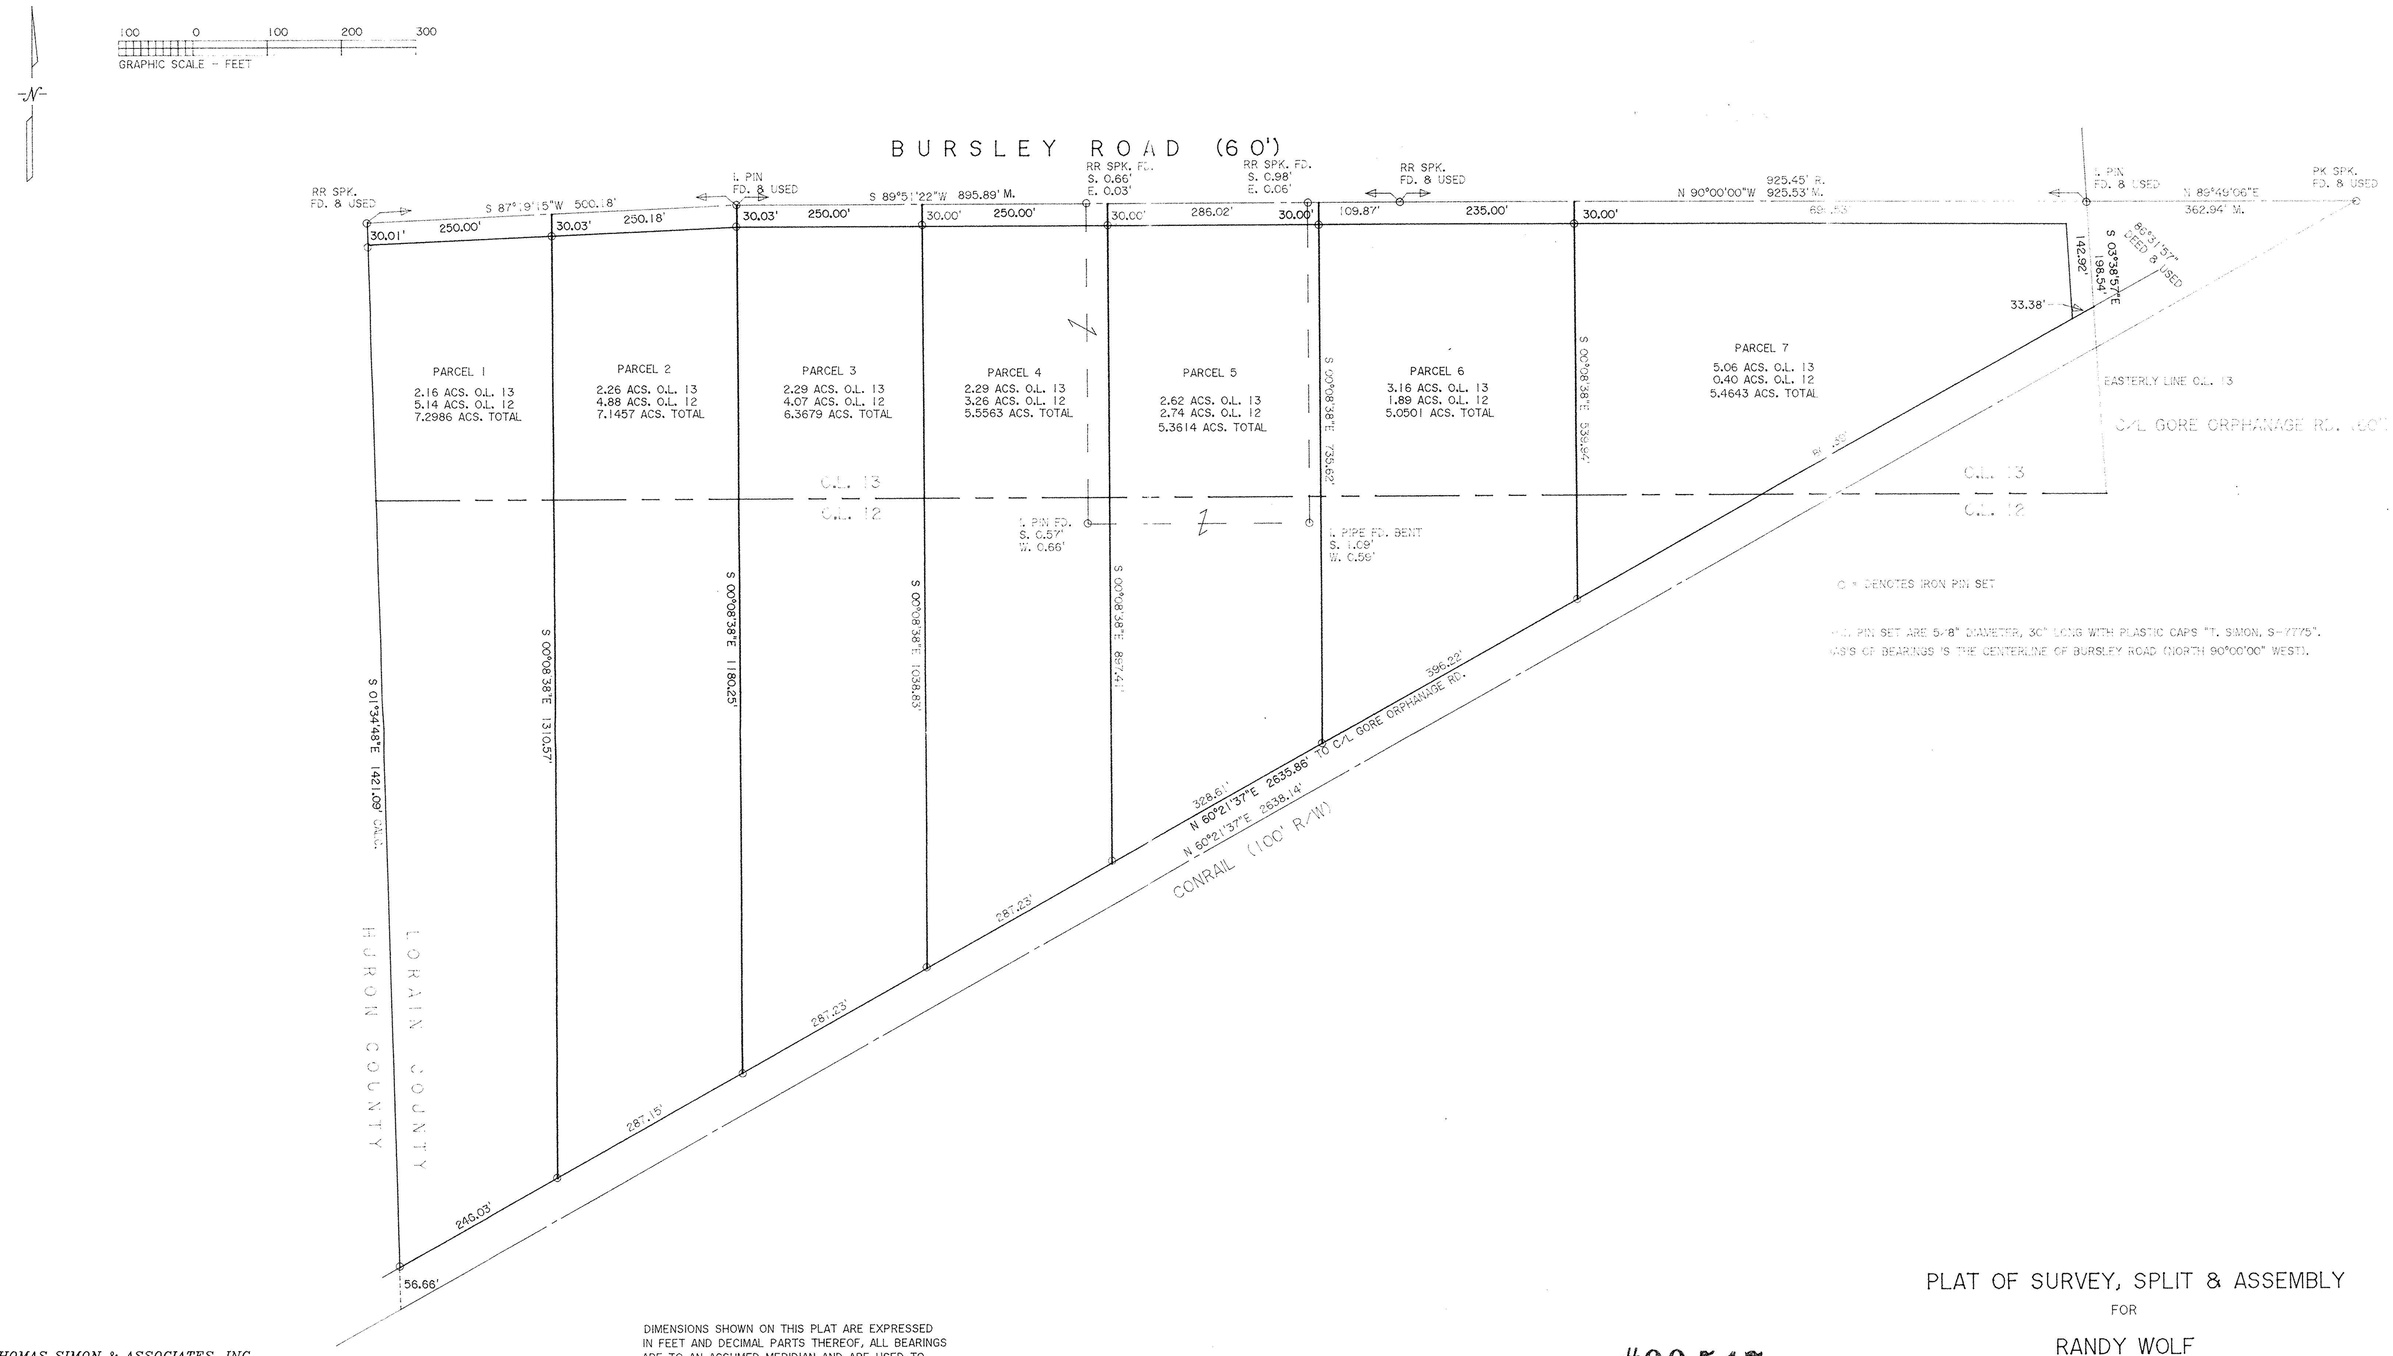

THOMAS SIMON & ASSOCIATES, INC.
PROFESSIONAL LAND SURVEYORS

COBBLESTONE CORNER PROFESSIONAL CENTER
39069 CENTER RIDGE ROAD
NORTH RIDGEVILLE, OHIO 44039
(440) 327-2925
FAX 327-2964

DIMENSIONS SHOWN ON THIS PLAT ARE EXPRESSED IN FEET AND DECIMAL PARTS THEREOF, ALL BEARINGS ARE TO AN ASSUMED MERIDIAN AND ARE USED TO INDICATE ANGLES ONLY. PERMANENT MONUMENTS WERE FOUND OR SET AT ALL POINTS INDICATED HEREON, ALL OF WHICH I CERTIFY TO BE CORRECT.

STATE OF OHIO THOMAS A. SIMON S-7775 REGISTERED PROFESSIONAL SURVEYOR

THOMAS A. SIMON
REG. PROFESSIONAL SURVEYOR
NO. S-7775

#00547

APPROVED
LORAIN CO.
MAP DEPT
DATE 8-29-00
PAGE 20-B
BY J Hatfield
#00547

PLAT OF SURVEY, SPLIT & ASSEMBLY

FOR

RANDY WOLF

BEING KNOWN AS PART OF ORIGINAL
ROCHESTER TOWNSHIP LOT NOS. 12 AND 13, TRACT 20

COUNTY OF LORAIN STATE OF OHIO

MARCH, 1999 SCALE: 1" = 100'

JOB NO. 99-008

Tract 20, Lots 12 & 13