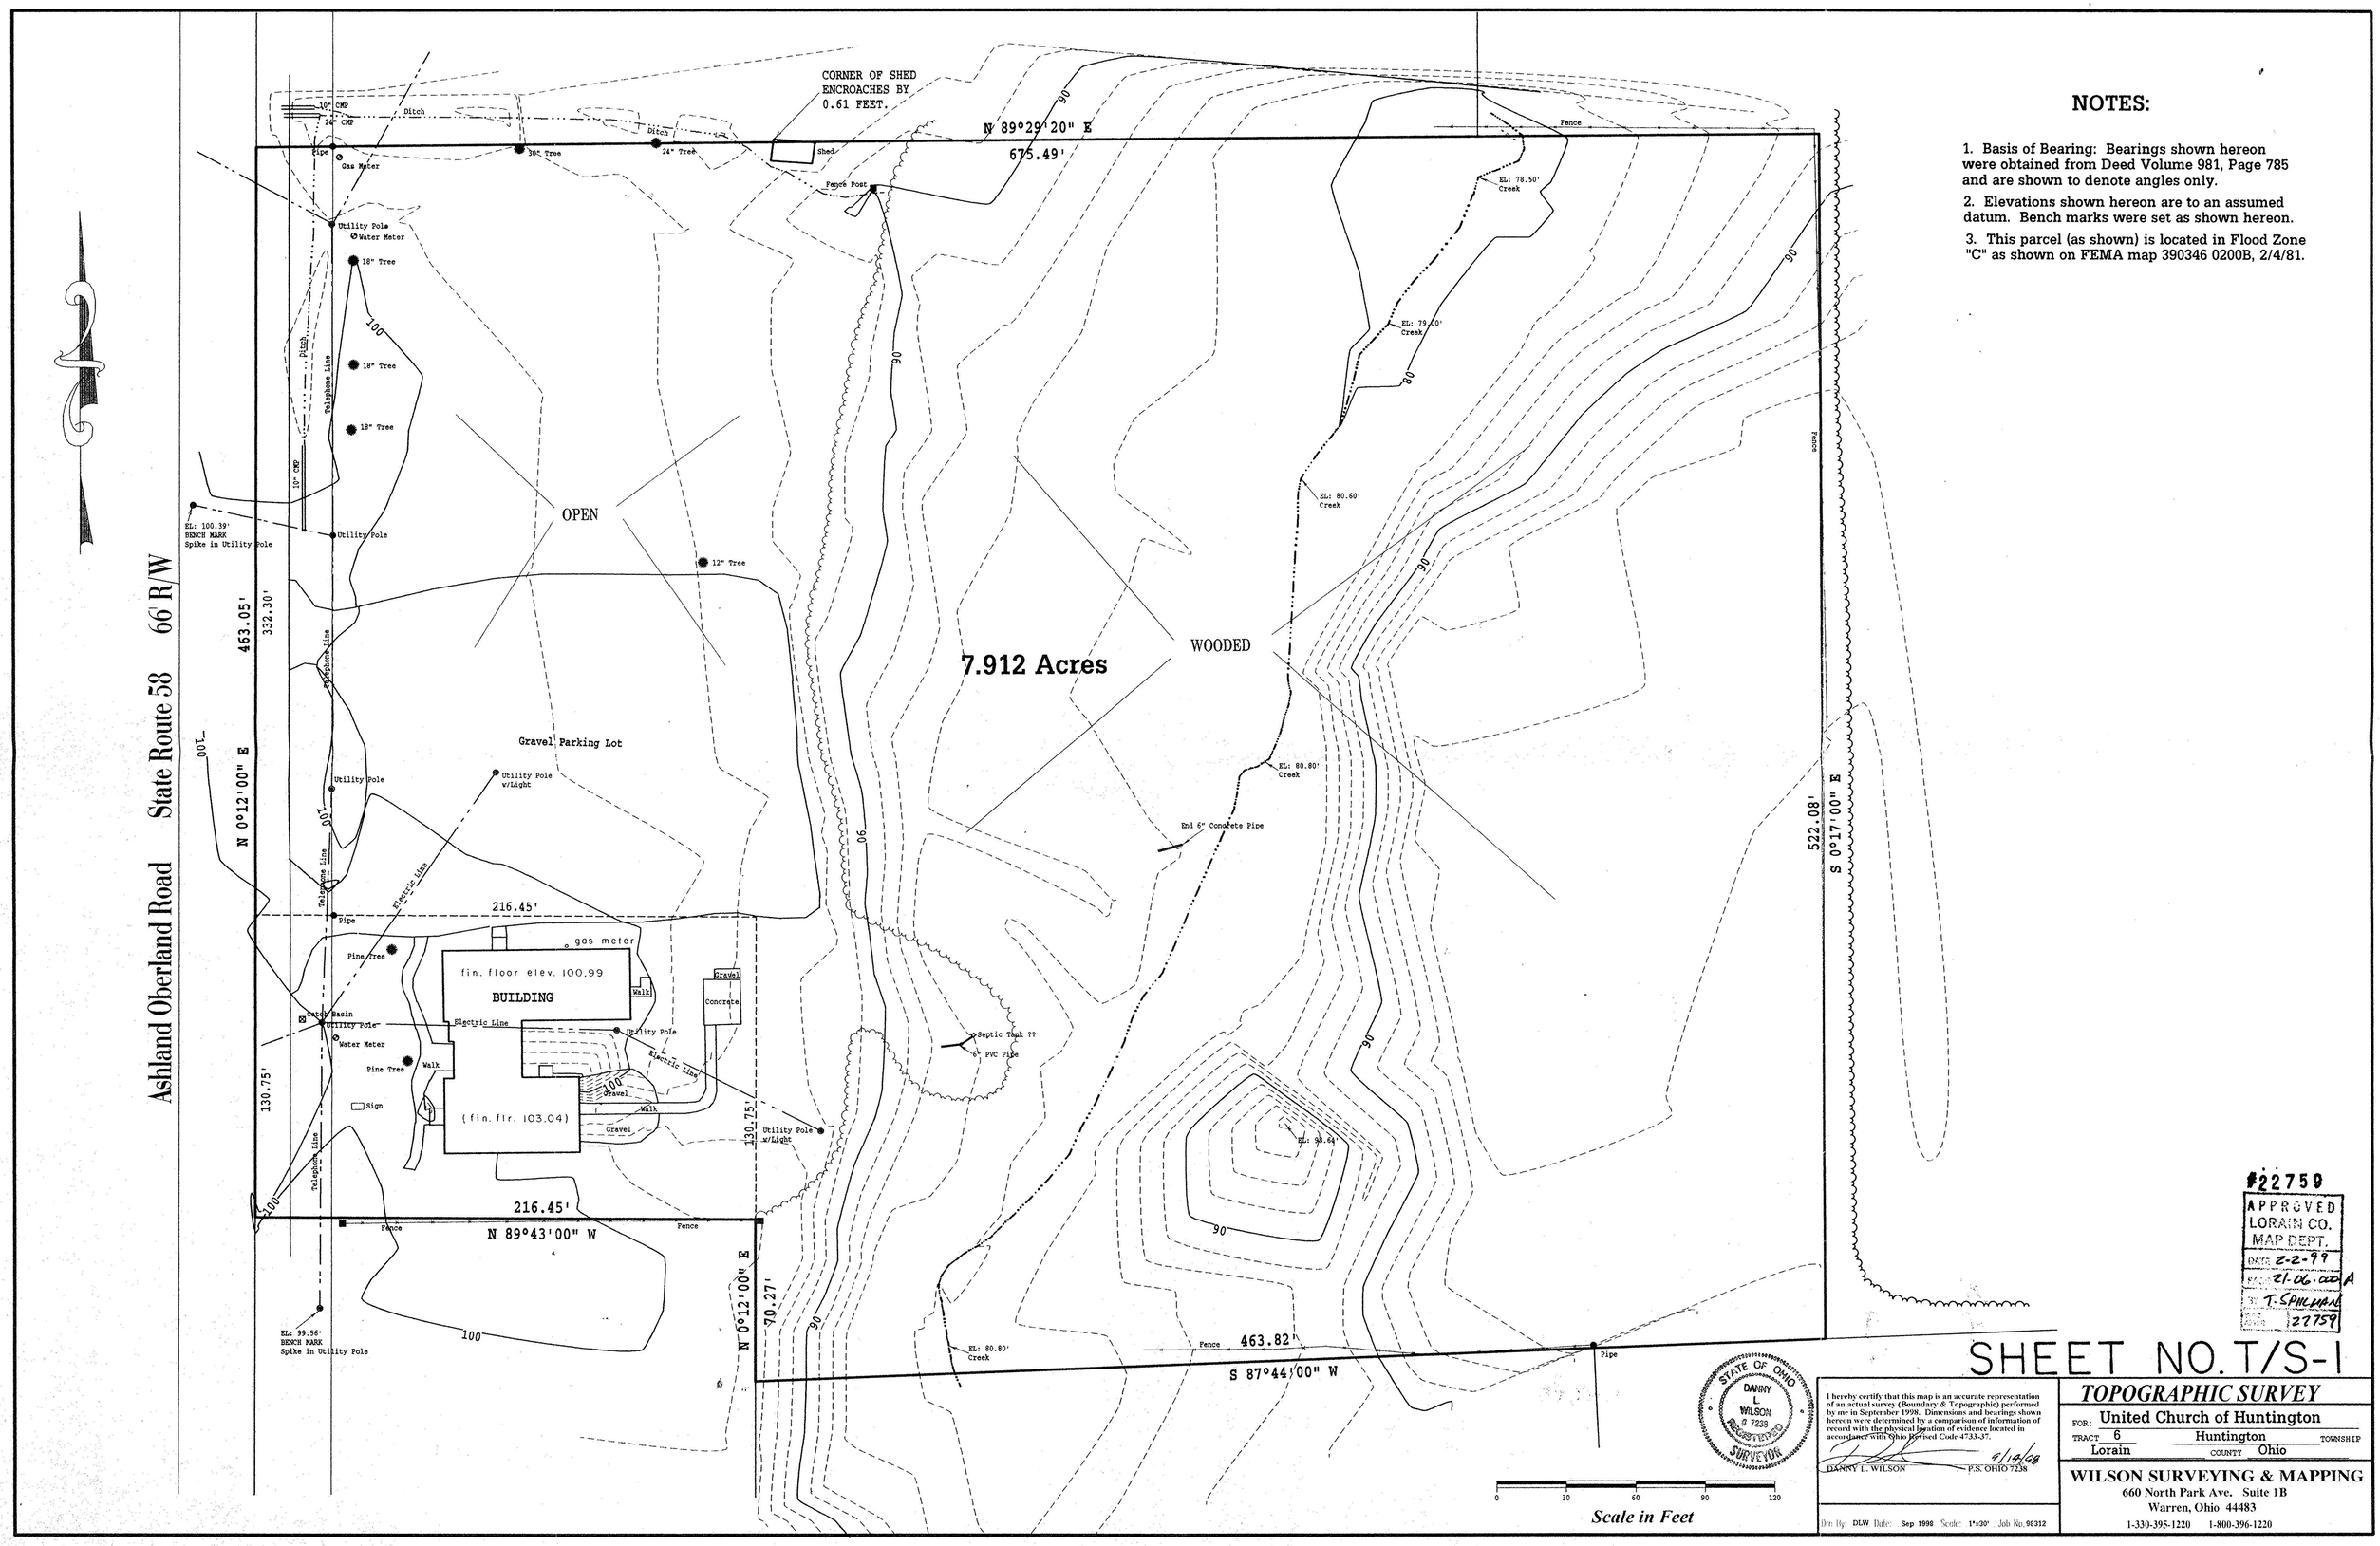

NOTES:

1. Basis of Bearing: Bearings shown hereon were obtained from Deed Volume 981, Page 785 and are shown to denote angles only.
2. Elevations shown hereon are to an assumed datum. Bench marks were set as shown hereon.
3. This parcel (as shown) is located in Flood Zone "C" as shown on FEMA map 390346 0200B, 2/4/81.

#22759
APPROVED
LORAIN CO.
MAP DEPT.
DATE 2-2-99
BY 21.06.000 A
T. SPALHAN
22759

SHEET NO. T/S-1

STATE OF OHIO
DANNY L. WILSON
7238
REGISTERED
SURVEYOR

I hereby certify that this map is an accurate representation of an actual survey (Boundary & Topographic) performed by me in September 1998. Dimensions and bearings shown hereon were determined by a comparison of information of record with the physical location of evidence located in accordance with Ohio Revised Code 4733-37.

DANNY L. WILSON — P.S. OHIO 7238 — 4/14/08

Drn By: DLW Date: Sep 1998 Scale: 1"=30' Job No. 98312

TOPOGRAPHIC SURVEY

FOR: United Church of Huntington

TRACT 6 — Huntington — TOWNSHIP

Lorain — COUNTY — Ohio

WILSON SURVEYING & MAPPING
660 North Park Ave. Suite 1B
Warren, Ohio 44483
1-330-395-1220 1-800-396-1220

#22759