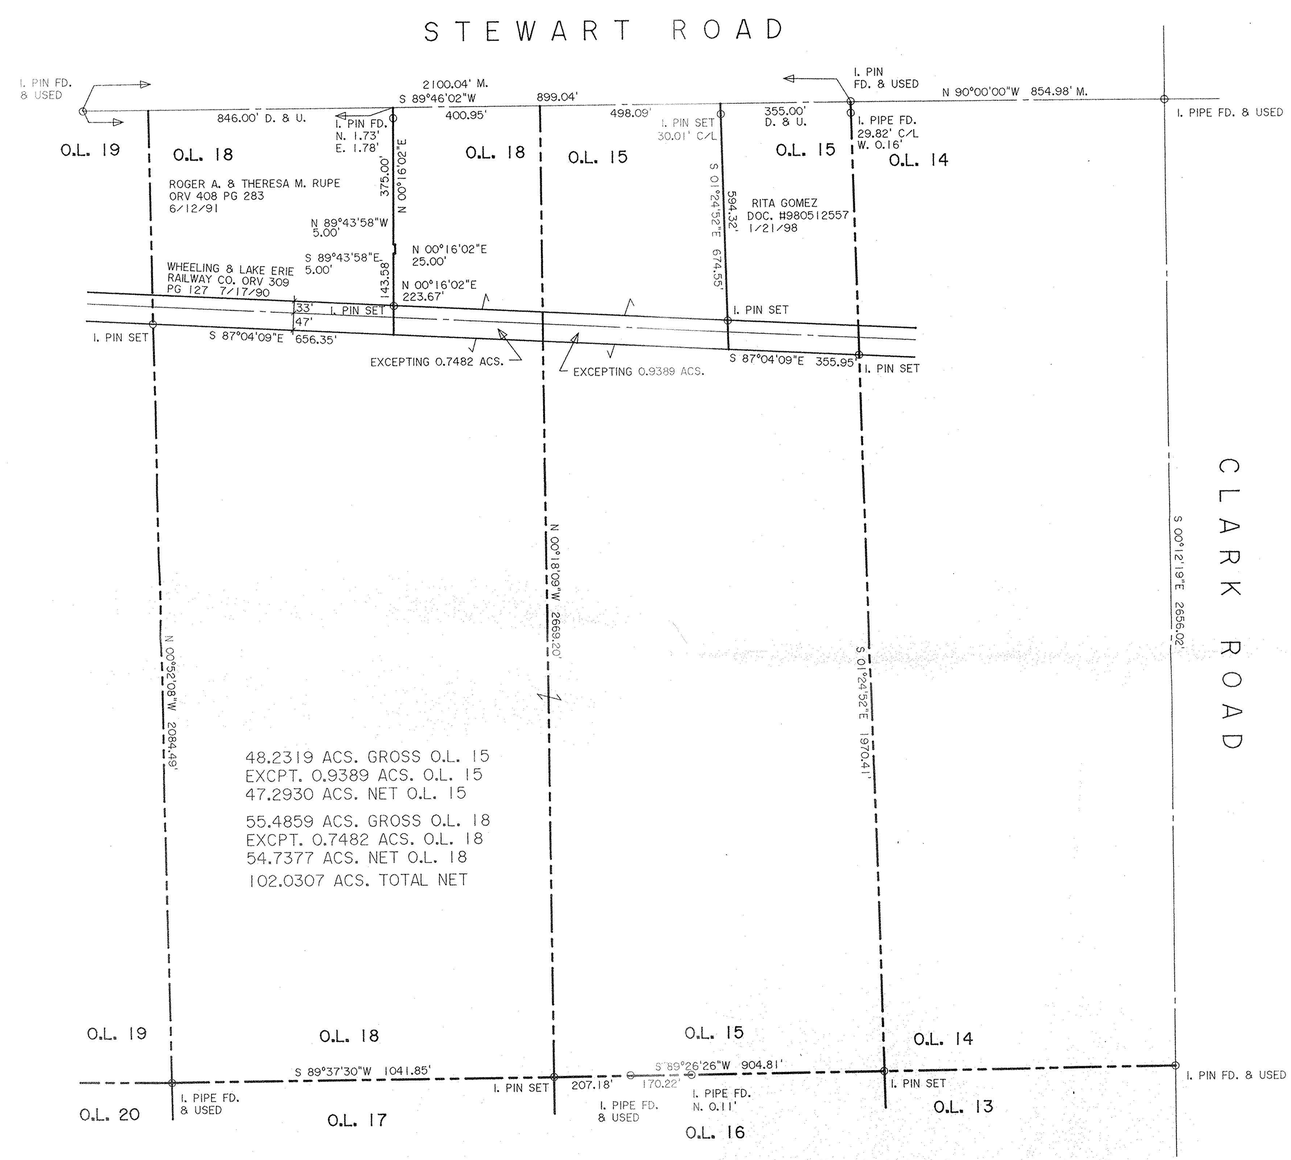

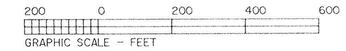

DIMENSIONS SHOWN ON THIS PLAT ARE EXPRESSED IN FEET AND DECIMAL PARTS THEREOF, ALL BEARINGS ARE TO AN ASSUMED MERIDIAN AND ARE USED TO INDICATE ANGLES ONLY. PERMANENT MONUMENTS WERE FOUND OR SET AT ALL POINTS INDICATED HEREON, ALL OF WHICH I CERTIFY TO BE CORRECT.

STATE OF OHIO THOMAS A. SIMON S-7775 REGISTERED PROFESSIONAL SURVEYOR

THOMAS A. SIMON
REG. PROFESSIONAL SURVEYOR
NO. S-7775

BASIS OF BEARINGS IS THE CENTERLINE OF STEWART ROAD (NORTH 90°00'00" WEST). IRON PINS SET ARE 5/8" DIAMETER 30" LONG WITH PLASTIC CAPS "T. SIMON, S-7775".

P.P.N. 21-02-018-015-000 008

№ 00718-A
APPROVED
LORAIN CO.
MAP DEPT.
DATE 6-4-02
PAGE 21-E
BY R. MAINES
VOID AFTER 02-00718-A

PLAT OF SURVEY
FOR
JAMES AND FRANCES ROLLIN

BEING KNOWN AS PARTS OF ORIGINAL LOT NOS. 15 AND 18
TRACT 2, HUNTINGTON TOWNSHIP

COUNTY OF LORAIN STATE OF OHIO

MAY, 2002 SCALE: 1" = 200'

THOMAS SIMON & ASSOCIATES, INC.
PROFESSIONAL LAND SURVEYORS

COBBLESTONE CORNER PROFESSIONAL CENTER
39049 CENTER RIDGE ROAD
NORTH RIDGEVILLE, OHIO 44039
(440) 327-2925
FAX 327-2964

JOB No. 2002-030