


AS THE UNDER-SIGNED OWNERS IN THE SIMPLE OF THE LAND SHOWN ON THIS PLAT, HEREBY DEDICATE TO PUBLIC USE AS A LEGAL HIGHWAY ALL THE LAND OWNED BY US LYING BETWEEN THE CENTERLINE OF BAKER ROAD AS EXISTING AND OCCUPIED BY THE TRACTS HEREIN SET FORTH PARALLEL THERETO AND 30 FEET THEREFROM.

Robert C Baumgartner Marsha M Baumgartner

Notary Public
My Commission Expires March 2, 1975

Witness
Harvey M Holcomb March
Lorain County Engineer

Witness
W. M. Sincere
Ed M. ...

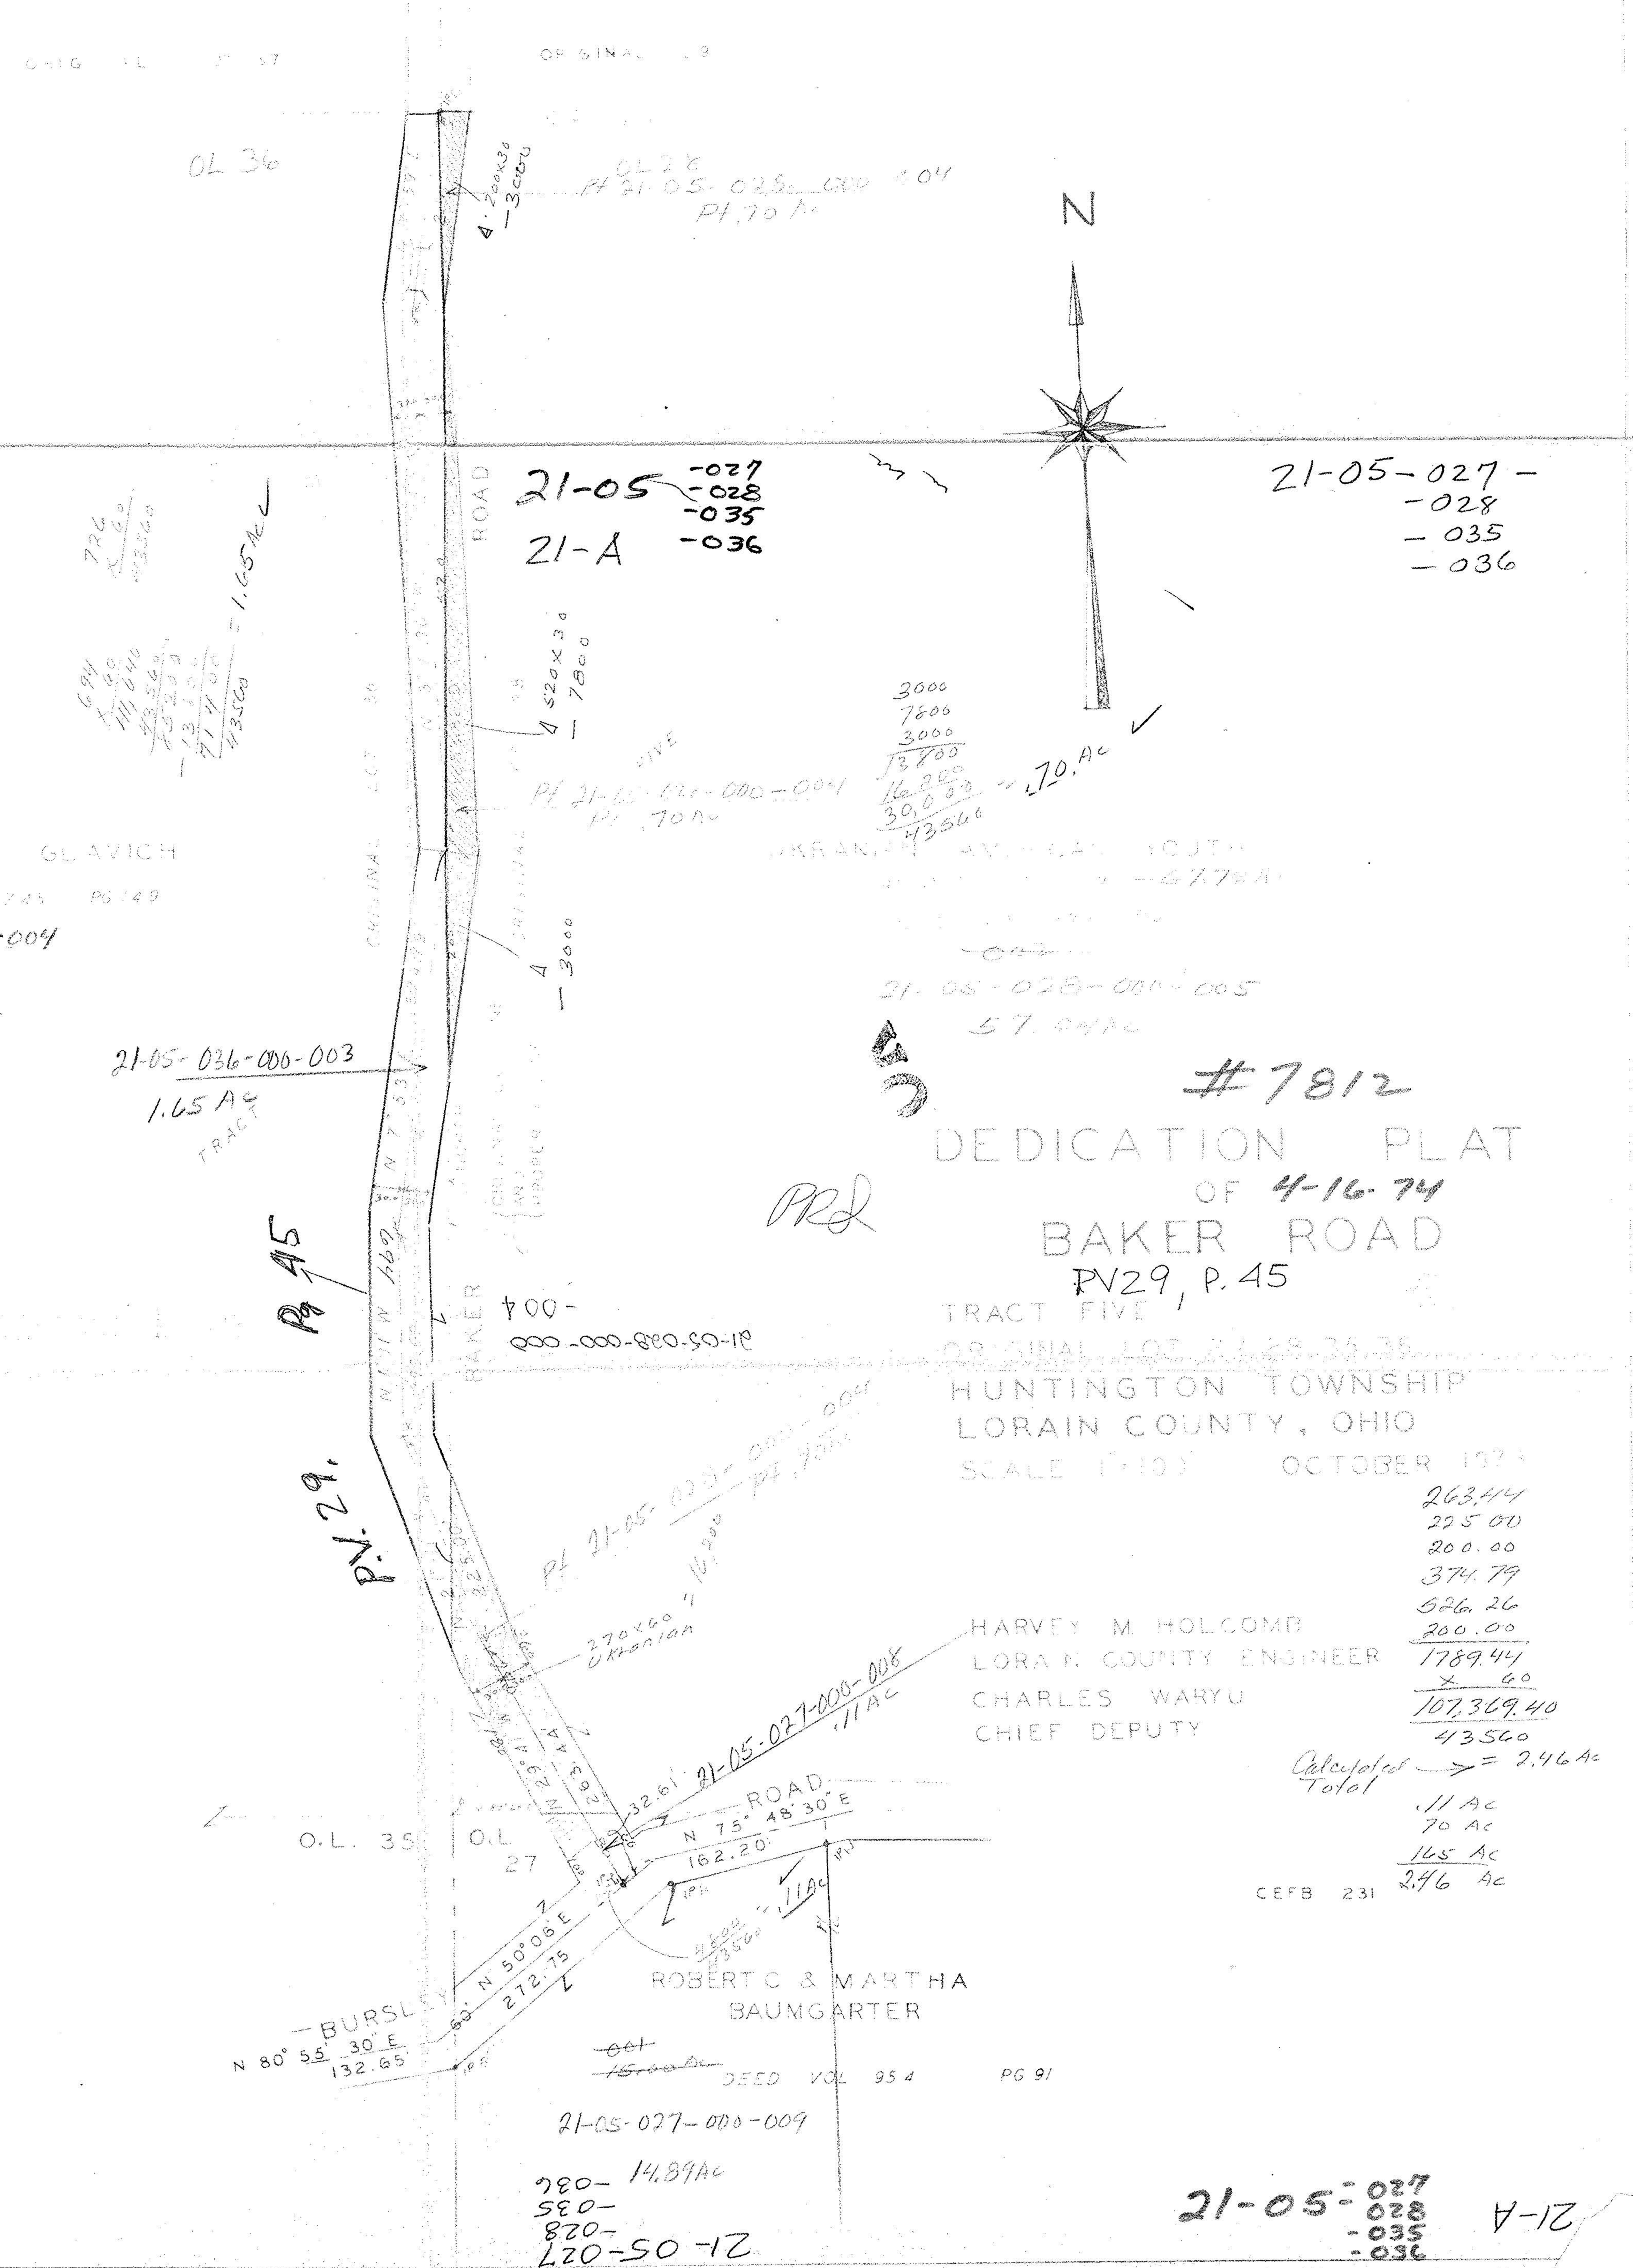

ANDREW & FAITH GLAVICH
DEED VOL 745 PG 149
-002-004
77.28
77.63 AC

#7812
DEDICATION PLAT
OF 4-16-74
BAKER ROAD
TRACT FIVE
ORIGINAL LOT 2, 3, 28, 36, 38
HUNTINGTON TOWNSHIP
LORAIN COUNTY, OHIO
SCALE 1"=100' OCTOBER 1974

HARVEY M HOLCOMB
LORAIN COUNTY ENGINEER
CHARLES WARYU
CHIEF DEPUTY

263.44
225.00
200.00
374.79
526.26
200.00
1789.44
2.60
107,369.40
43500
Calculated Total = 2.46 Ac
.11 Ac
.70 Ac
1.65 Ac
CEFB 231 2.46 Ac

ROBERT C & MARTHA BAUMGARTER
DEED VOL 954 PG 91

21-05-027
530-
820
720
21-05-50-12