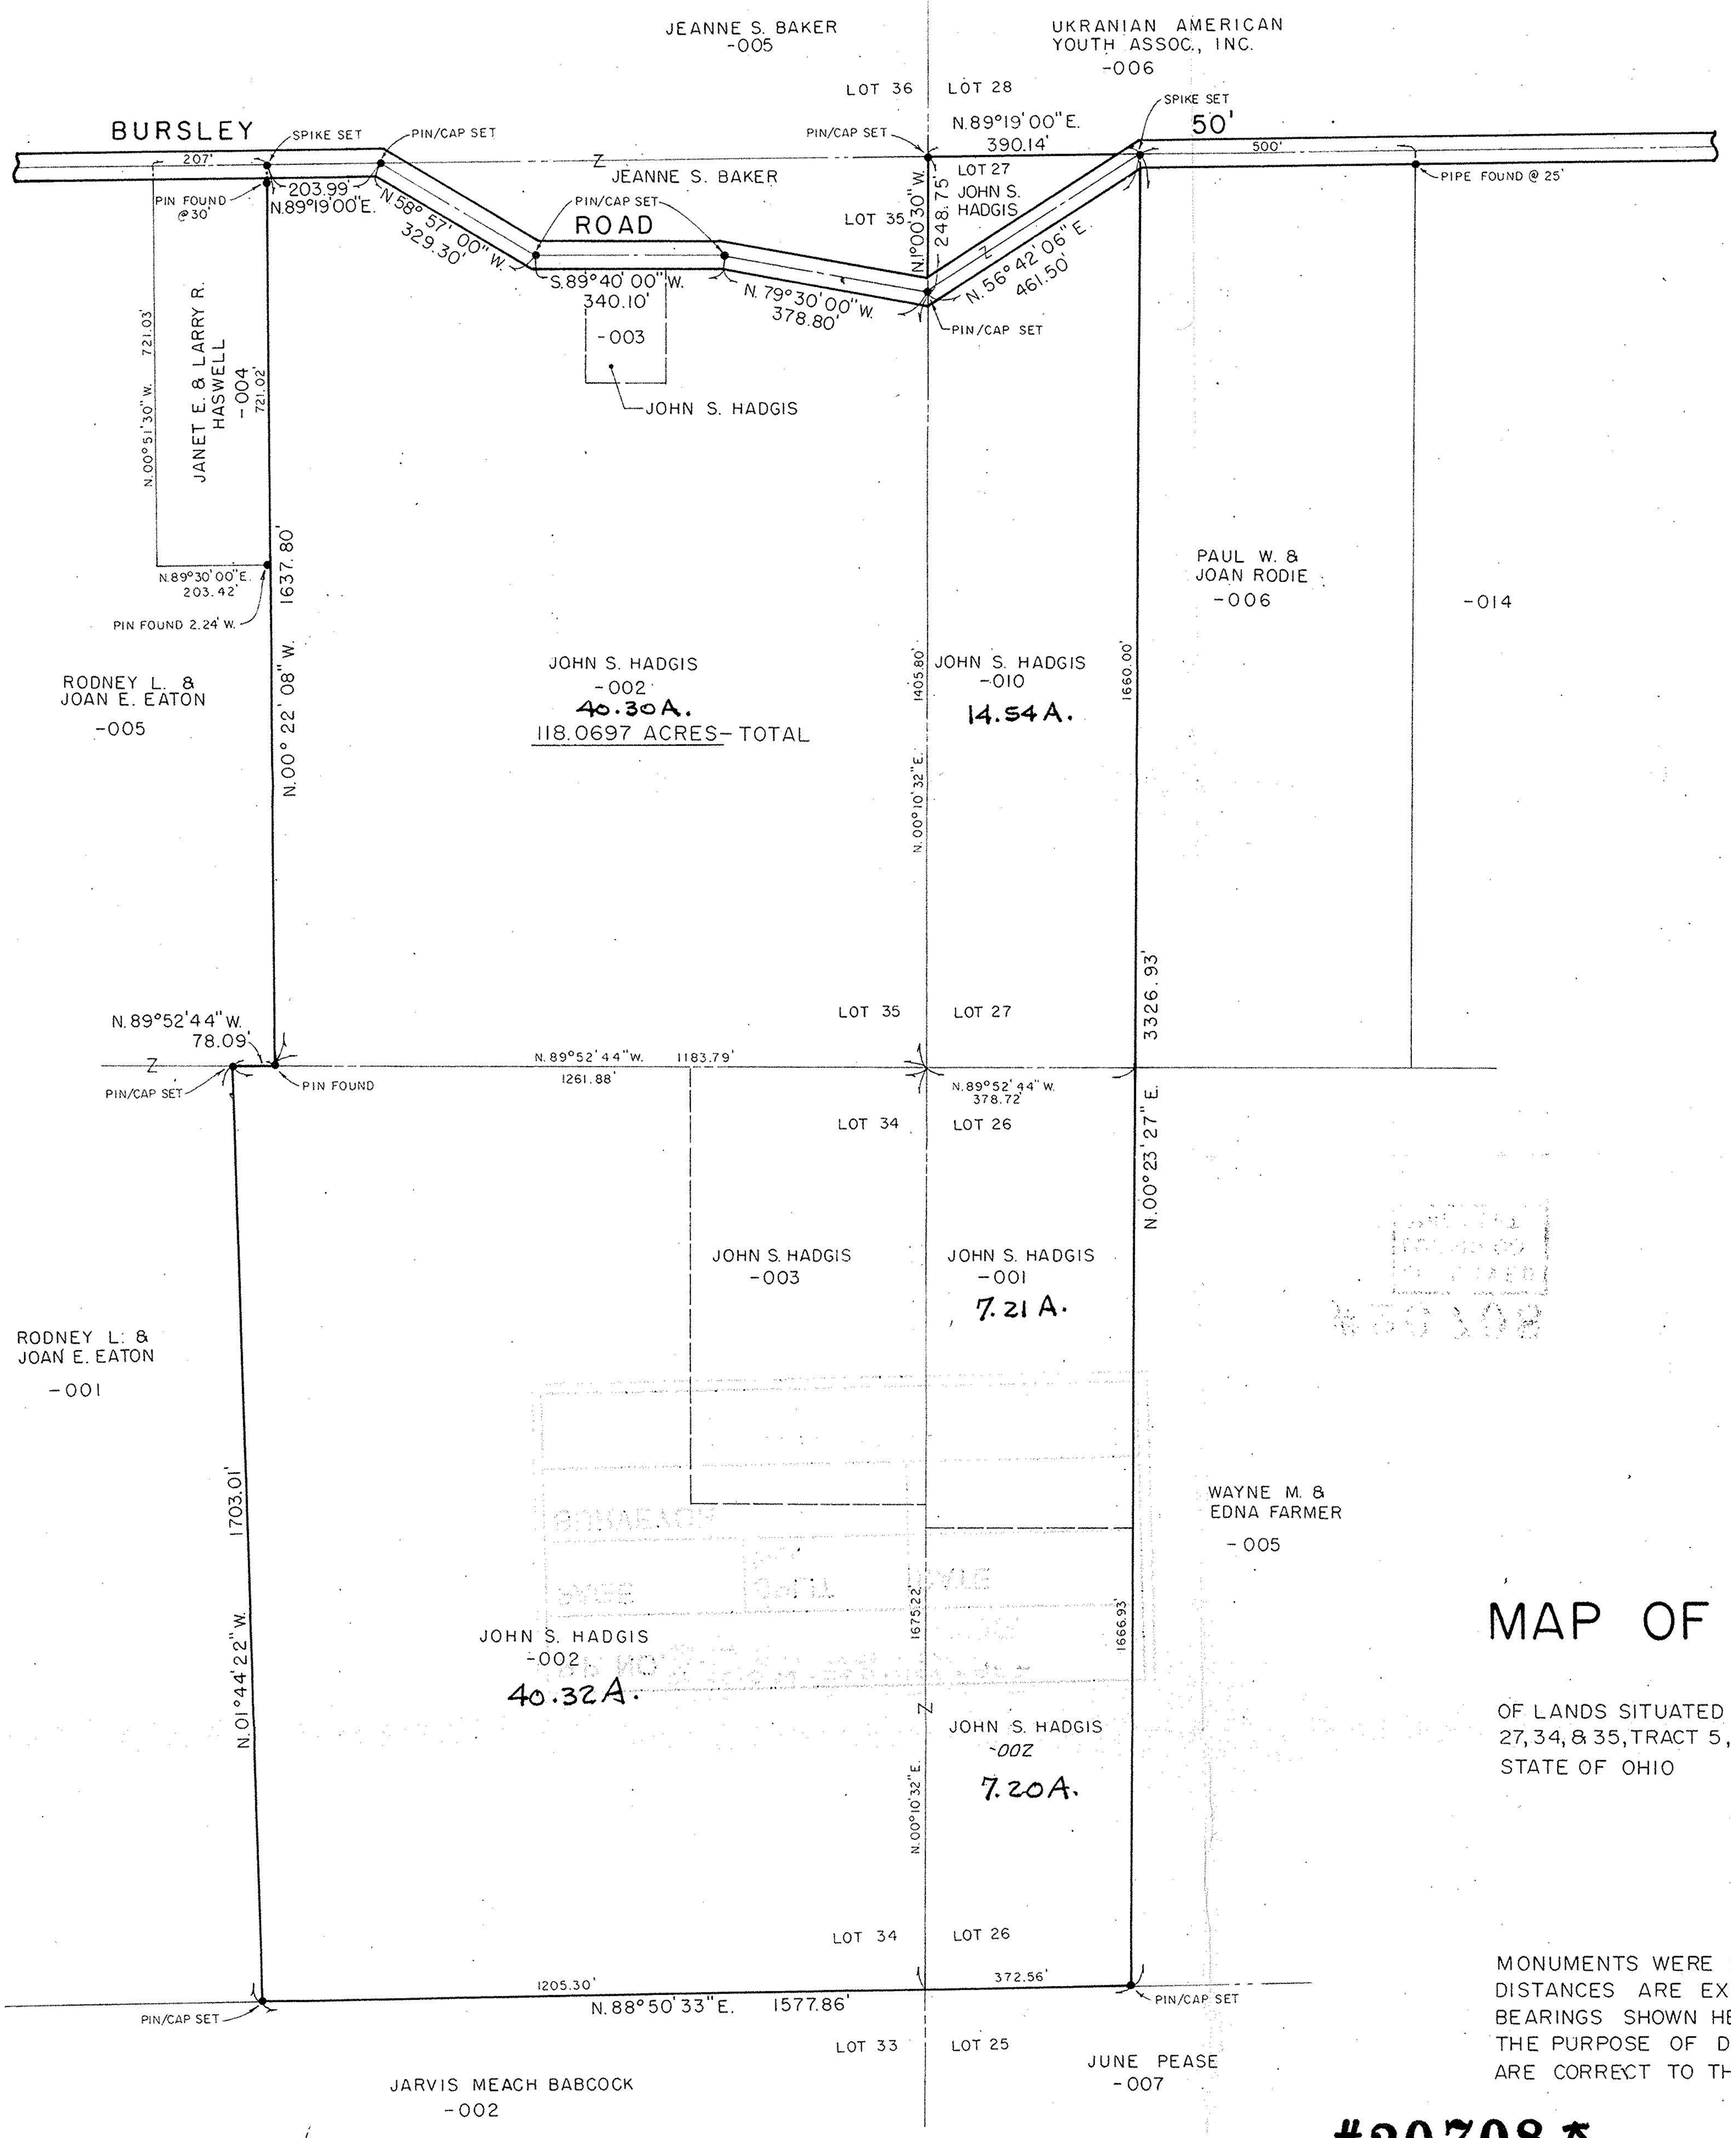

SCALE: 1" = 200'

MAP OF BOUNDARY SURVEY

OF LANDS SITUATED IN ORIGINAL HUNTINGTON TOWNSHIP LOTS 26, 27, 34, & 35, TRACT 5, TOWNSHIP 2N, RANGE 18W, COUNTY OF LORAIN, STATE OF OHIO

PREPARED FOR
JOHN S. HADGIS

MONUMENTS WERE FOUND OR SET AT POINTS AS INDICATED HEREON. DISTANCES ARE EXPRESSED IN FEET AND DECIMAL PARTS THEREOF. BEARINGS SHOWN HEREON ARE BASED ON AN ASSUMED MERIDIAN FOR THE PURPOSE OF DESCRIBING THE VARIOUS ANGLES, ALL OF WHICH ARE CORRECT TO THE BEST OF OUR KNOWLEDGE AND BELIEF.

#20708A

APPROVED
LORAIN CO.
MAP DEPT.
DATE 6-28-94
PAGE 21-A
BY
VOID AFTER 20708A

PREPARED BY

McCANN ASSOCIATES, INC.
CIVIL ENGINEERS & SURVEYORS
5539 RIDGE ROAD PARMA, OHIO 44129

DOUGLAS P. McLAUGHLIN, REG. SURVEYOR NO. 6688

NOVEMBER, 1993
REVISED DEC. 7, 1993

STATE OF OHIO
DOUGLAS P. McLAUGHLIN
6688
REGISTERED
SURVEYOR