


MON BOX QUARRY RD

OWIDE DRIVE ESM17

CRIGGS RD 60'

BAKER RD

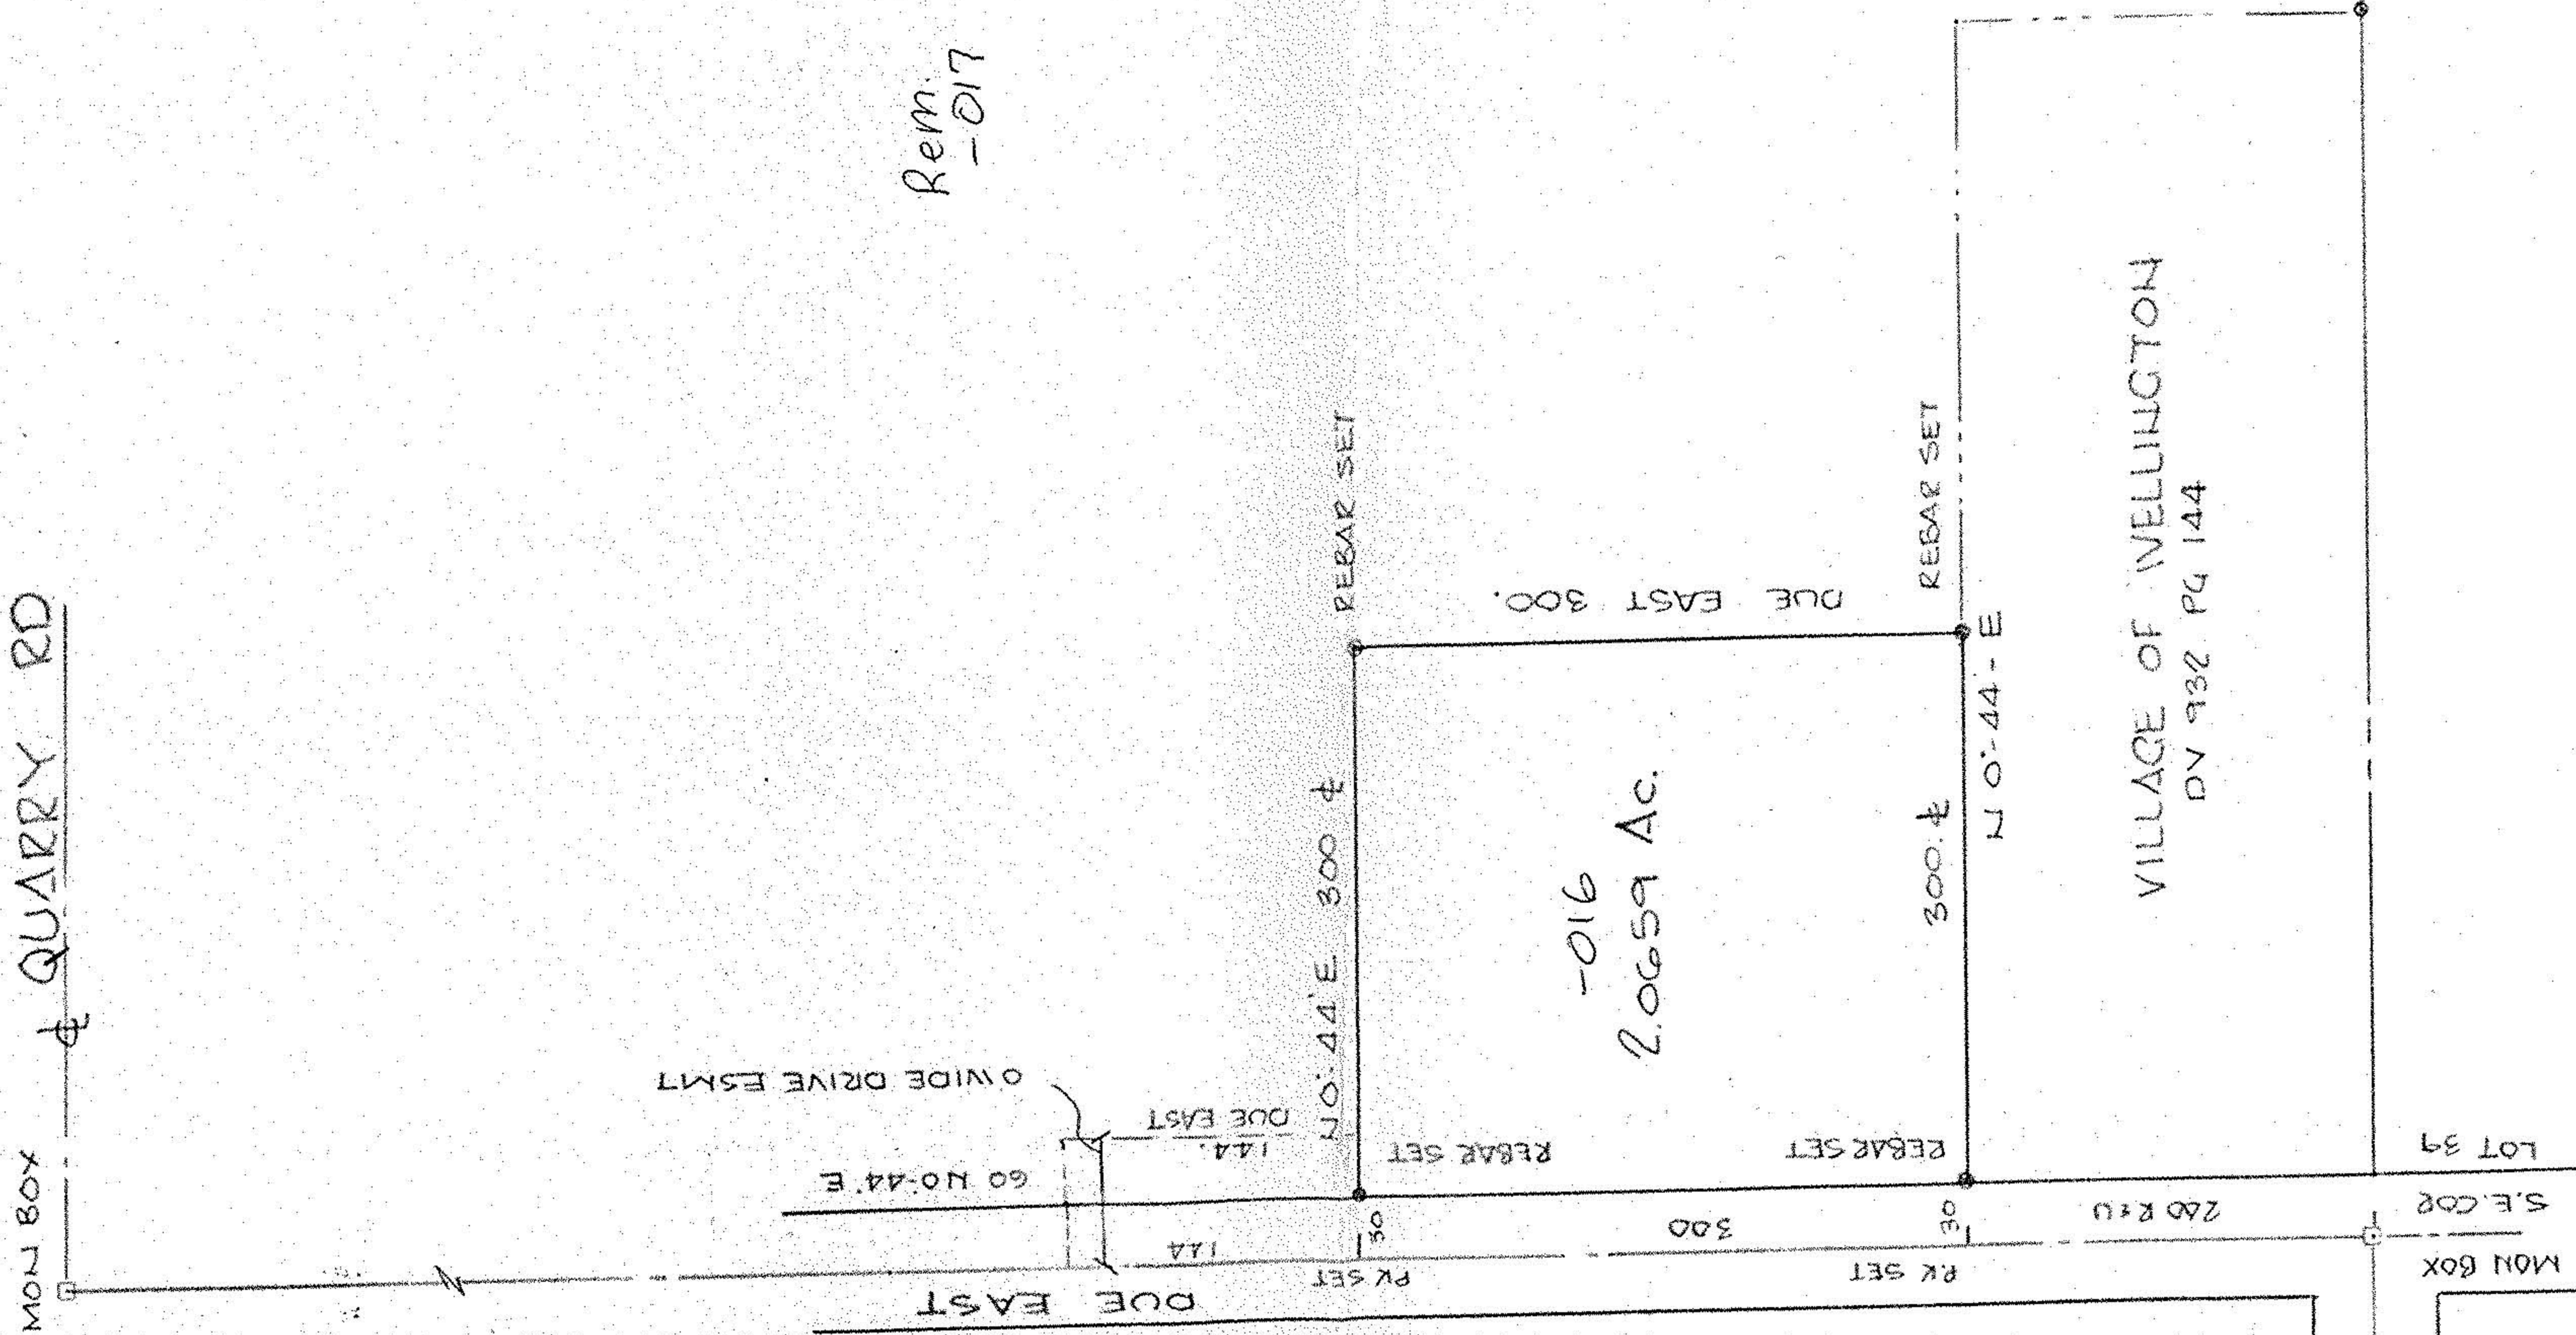


SURVEY
 OF PART OF
 ORIGINAL HUNTINGTON TWP.
 LOT 39 TRACT 5
 COUNTY OF LORAIN STATE OF OHIO

#22486

APPROVED
LORAIN CO.
MAP DEPT
DATE 3/30/98
PAGE 21-A
BY K. Colbert

PREPARED FOR:
 ROSS SPRINKLE
 48140 CRIGGS RD.
 WELLINGTON, OH.

PREPARED BY
 HAPONEK & ASSOC
 SURVEYORS
 N. RIDGEVILLE, OH.

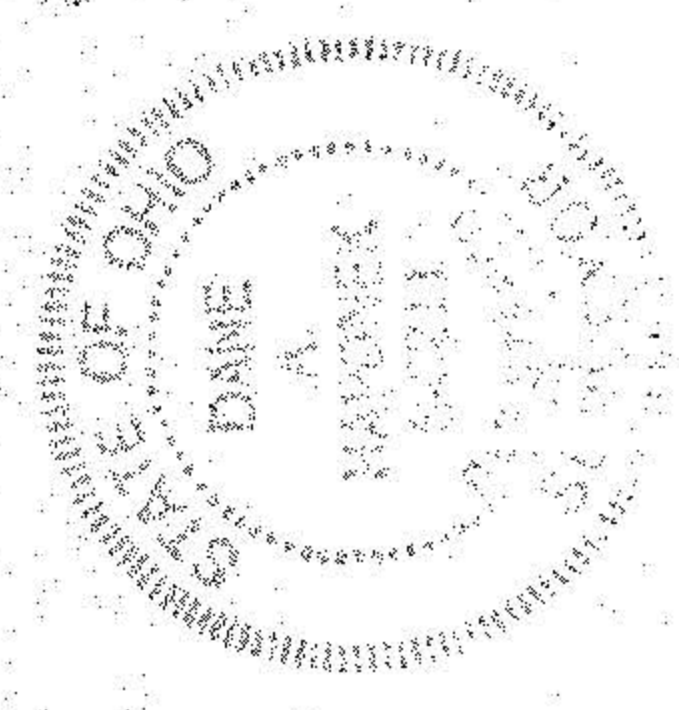

DATE: FEB. 1998
 SCALE: 1" = 100'

LOT 39
 WIRE FENCE PD
 3.30 FT W.
 LOT 31

LOT 40
 REBAR SET FOR
 OCCUPATION N 45
 WIRE FENCE PD
 4.50 FT W.
 LOT 32