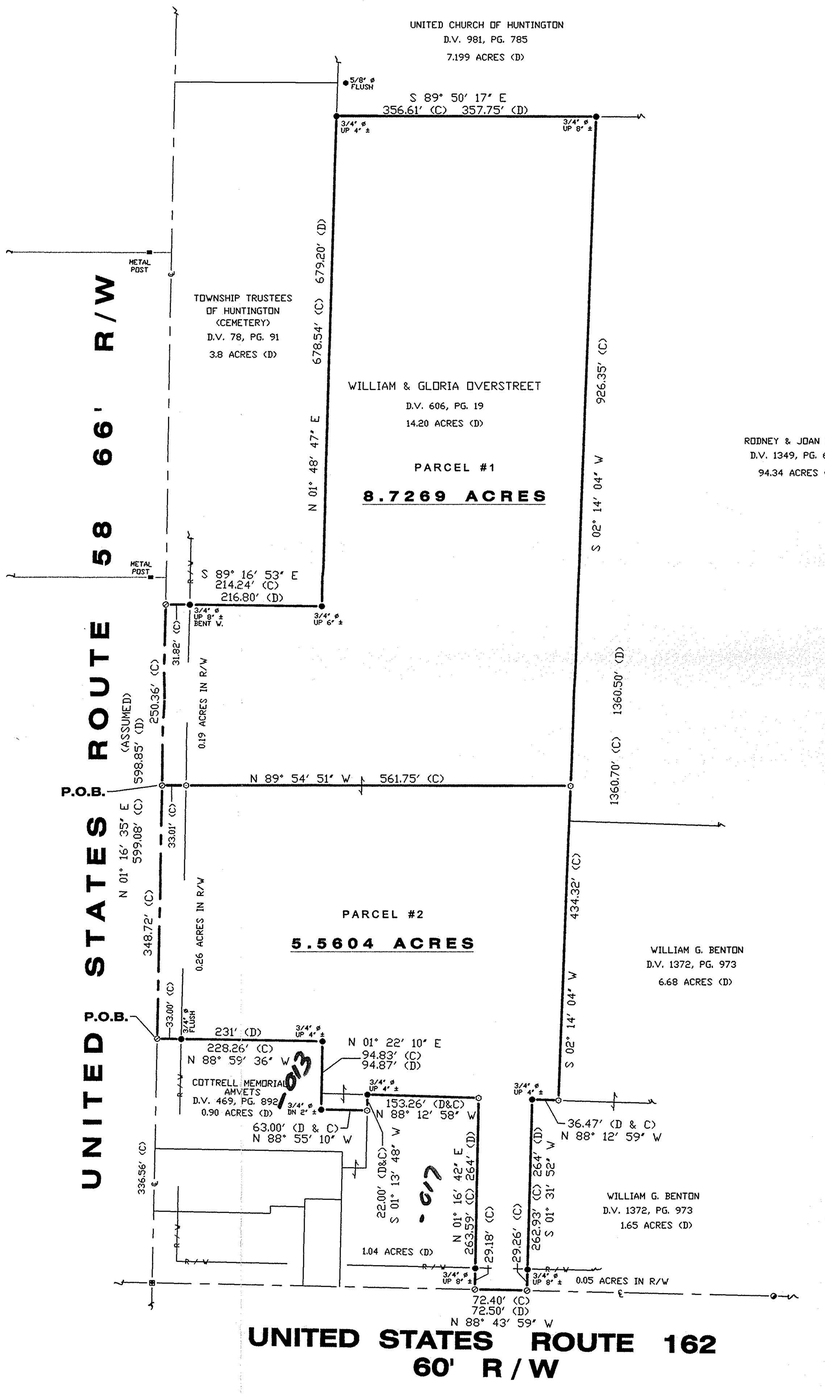

0 100' 200'
SCALE IN FEET

REFERENCES

DEED VOLUME AND PAGE AS SHOWN
ODOT CENTERLINE REFERENCES
SR. 162 ROAD PLANS

LEGEND

SET	FOUND	DESCRIPTION
		CONC. MONUMENT
		RAILROAD SPIKE
		NAIL
		IRON ROD
		DRILL HOLE
		STONE
		MONUMENT BOX
		IRON PIPE
		WOOD POST
		(D) DEED
		(P) PLAT
		(M) MEASURED
		(S) SURVEYED
		(C) CALCULATED

00805

APPROVED
LORAIN CO.
MAP DEPT
DATE 7-18-01
PAGE 21-06000-A
BY J.HATFIELD
XX 01-00805

NOTE:
ALL IRON ROD SET ARE 5/8" DIA. x 30" LENGTH WITH PERSONALIZED CAPS (HANK AND ASSOC.) DRIVEN FLUSH.

SURVEYOR'S STATEMENT

I HEREBY DECLARE THAT THE ABOVE PARCEL WAS SURVEYED DURING JUNE, 2001, PROPERTY LINES SHOWN ARE LOCATED FROM DEEDS ON RECORD AND ARE DEED LINES. BEARINGS ARE ASSUMED FOR ANGULAR MEASUREMENT ONLY. ALL INFORMATION SHOWN IS TRUE AND CORRECT TO THE BEST OF MY KNOWLEDGE AND BELIEF (PER CHAPTER 4733-37 OF THE OHIO REVISED CODE).

STATE OF OHIO
DANIEL JOSEPH NICHOLS
S-7460
REGISTERED PROFESSIONAL SURVEYOR

DANIEL J. NICHOLS, P.S. #7460 — DATE 06-2001

DRAWN BY:	CHECKED BY:	REVISIONS:
djn	DJN	
DATE: 06-04-2001	SCALE 1" = 100'	

SURVEY FOR: **WILLIAM OVERSTREET**

BEING PART OF TRACT 6, HUNTINGTON TOWNSHIP, T-2-N, R-18-W, LORAIN COUNTY, OHIO

HANK AND ASSOCIATES, INC.
ENGINEERING SURVEYING
137 SOUTH WASHINGTON STREET
TIFFIN, OHIO 44883
PHONE: (419) 447-4300 FAX: (419) 447-2076

JOB NO. 2011.163