WILLIAM B. BARTON
Reg. Land Surveyor No. 4438
188 PARKWOOD AVENUE
AVON LAKE, OHIO 44012
TELEPHONE (216) 933-6662

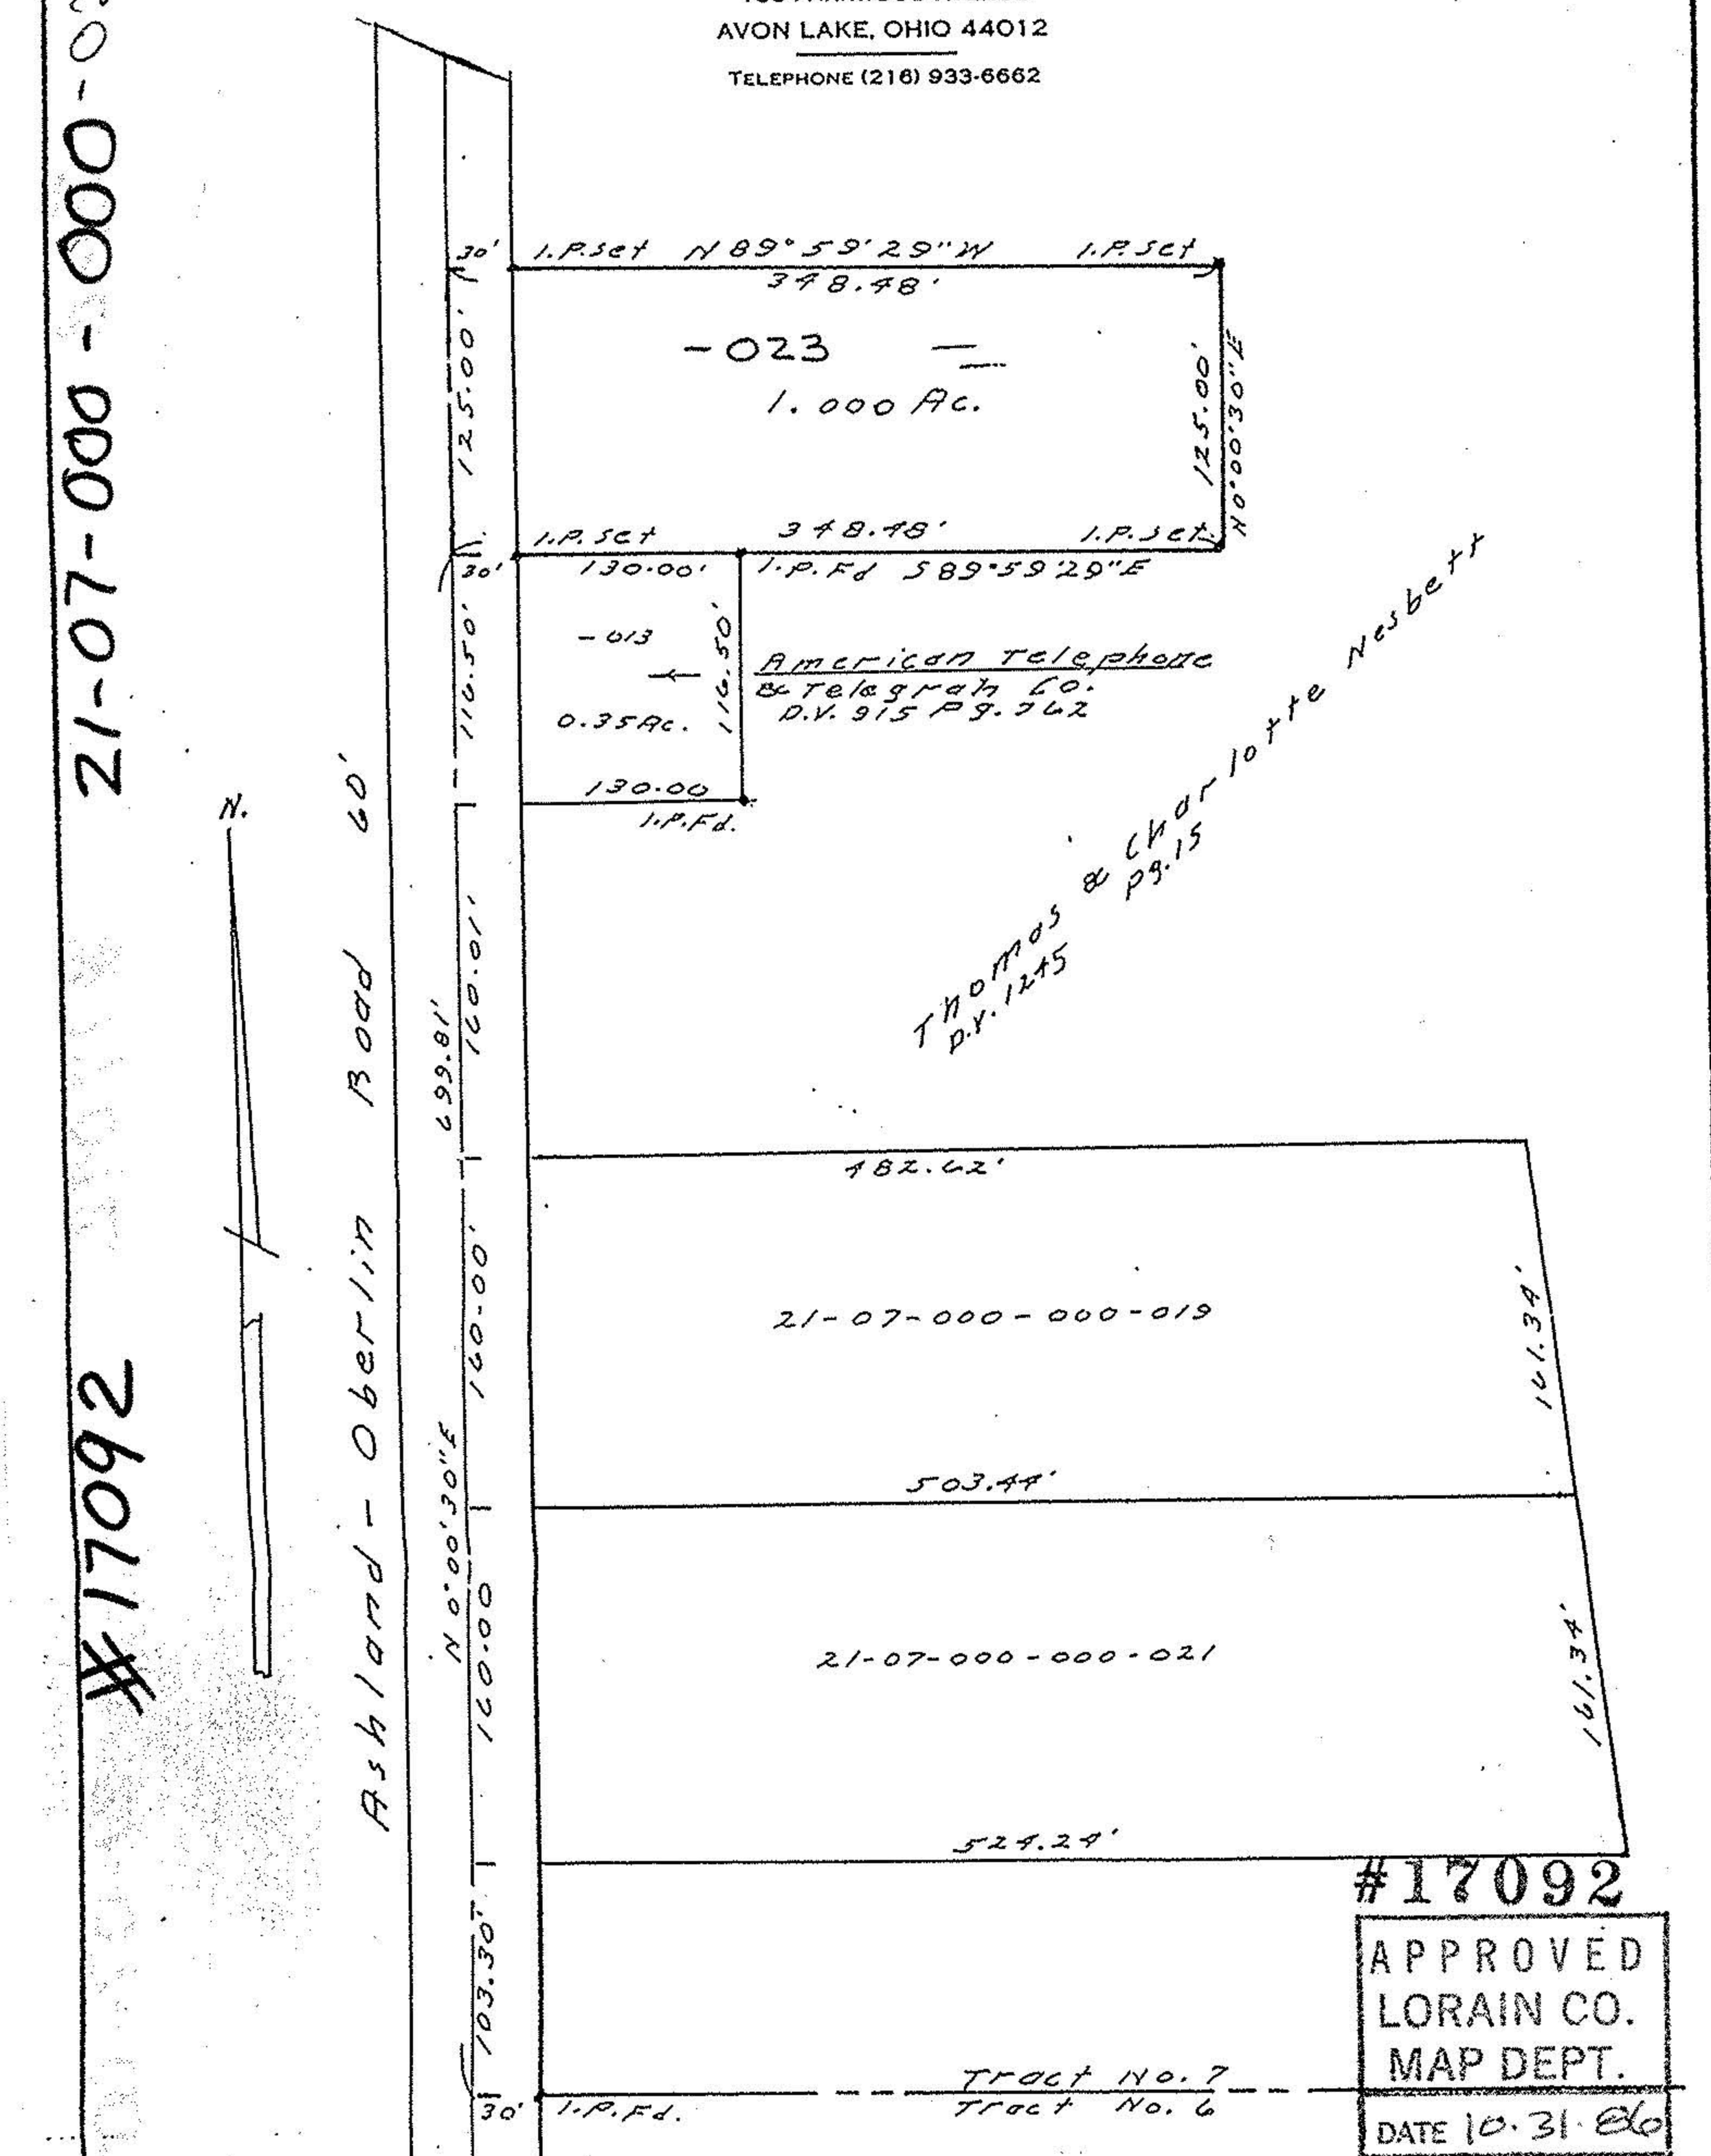

SURVEY
of
Part of Tract No. 7., Township of Wellington, county of Lorain, and state of Ohio. Scale 1"=100'
October 22, 1986

#17092

APPROVED
LORAIN CO.
MAP DEPT.
DATE 10-31-86
PAGE 21-C
BY T-McMain
VOID AFTER

STATE OF OHIO
WILLIAM B. BARTON
4438
REGISTERED SURVEYOR

21-C

(011)