




BEARING BASIS

THE CENTERLINE OF WEST ROAD (C.H. 38)
BEARING N 00°31'54" W AS RECORDED
IN RECORDING #779588

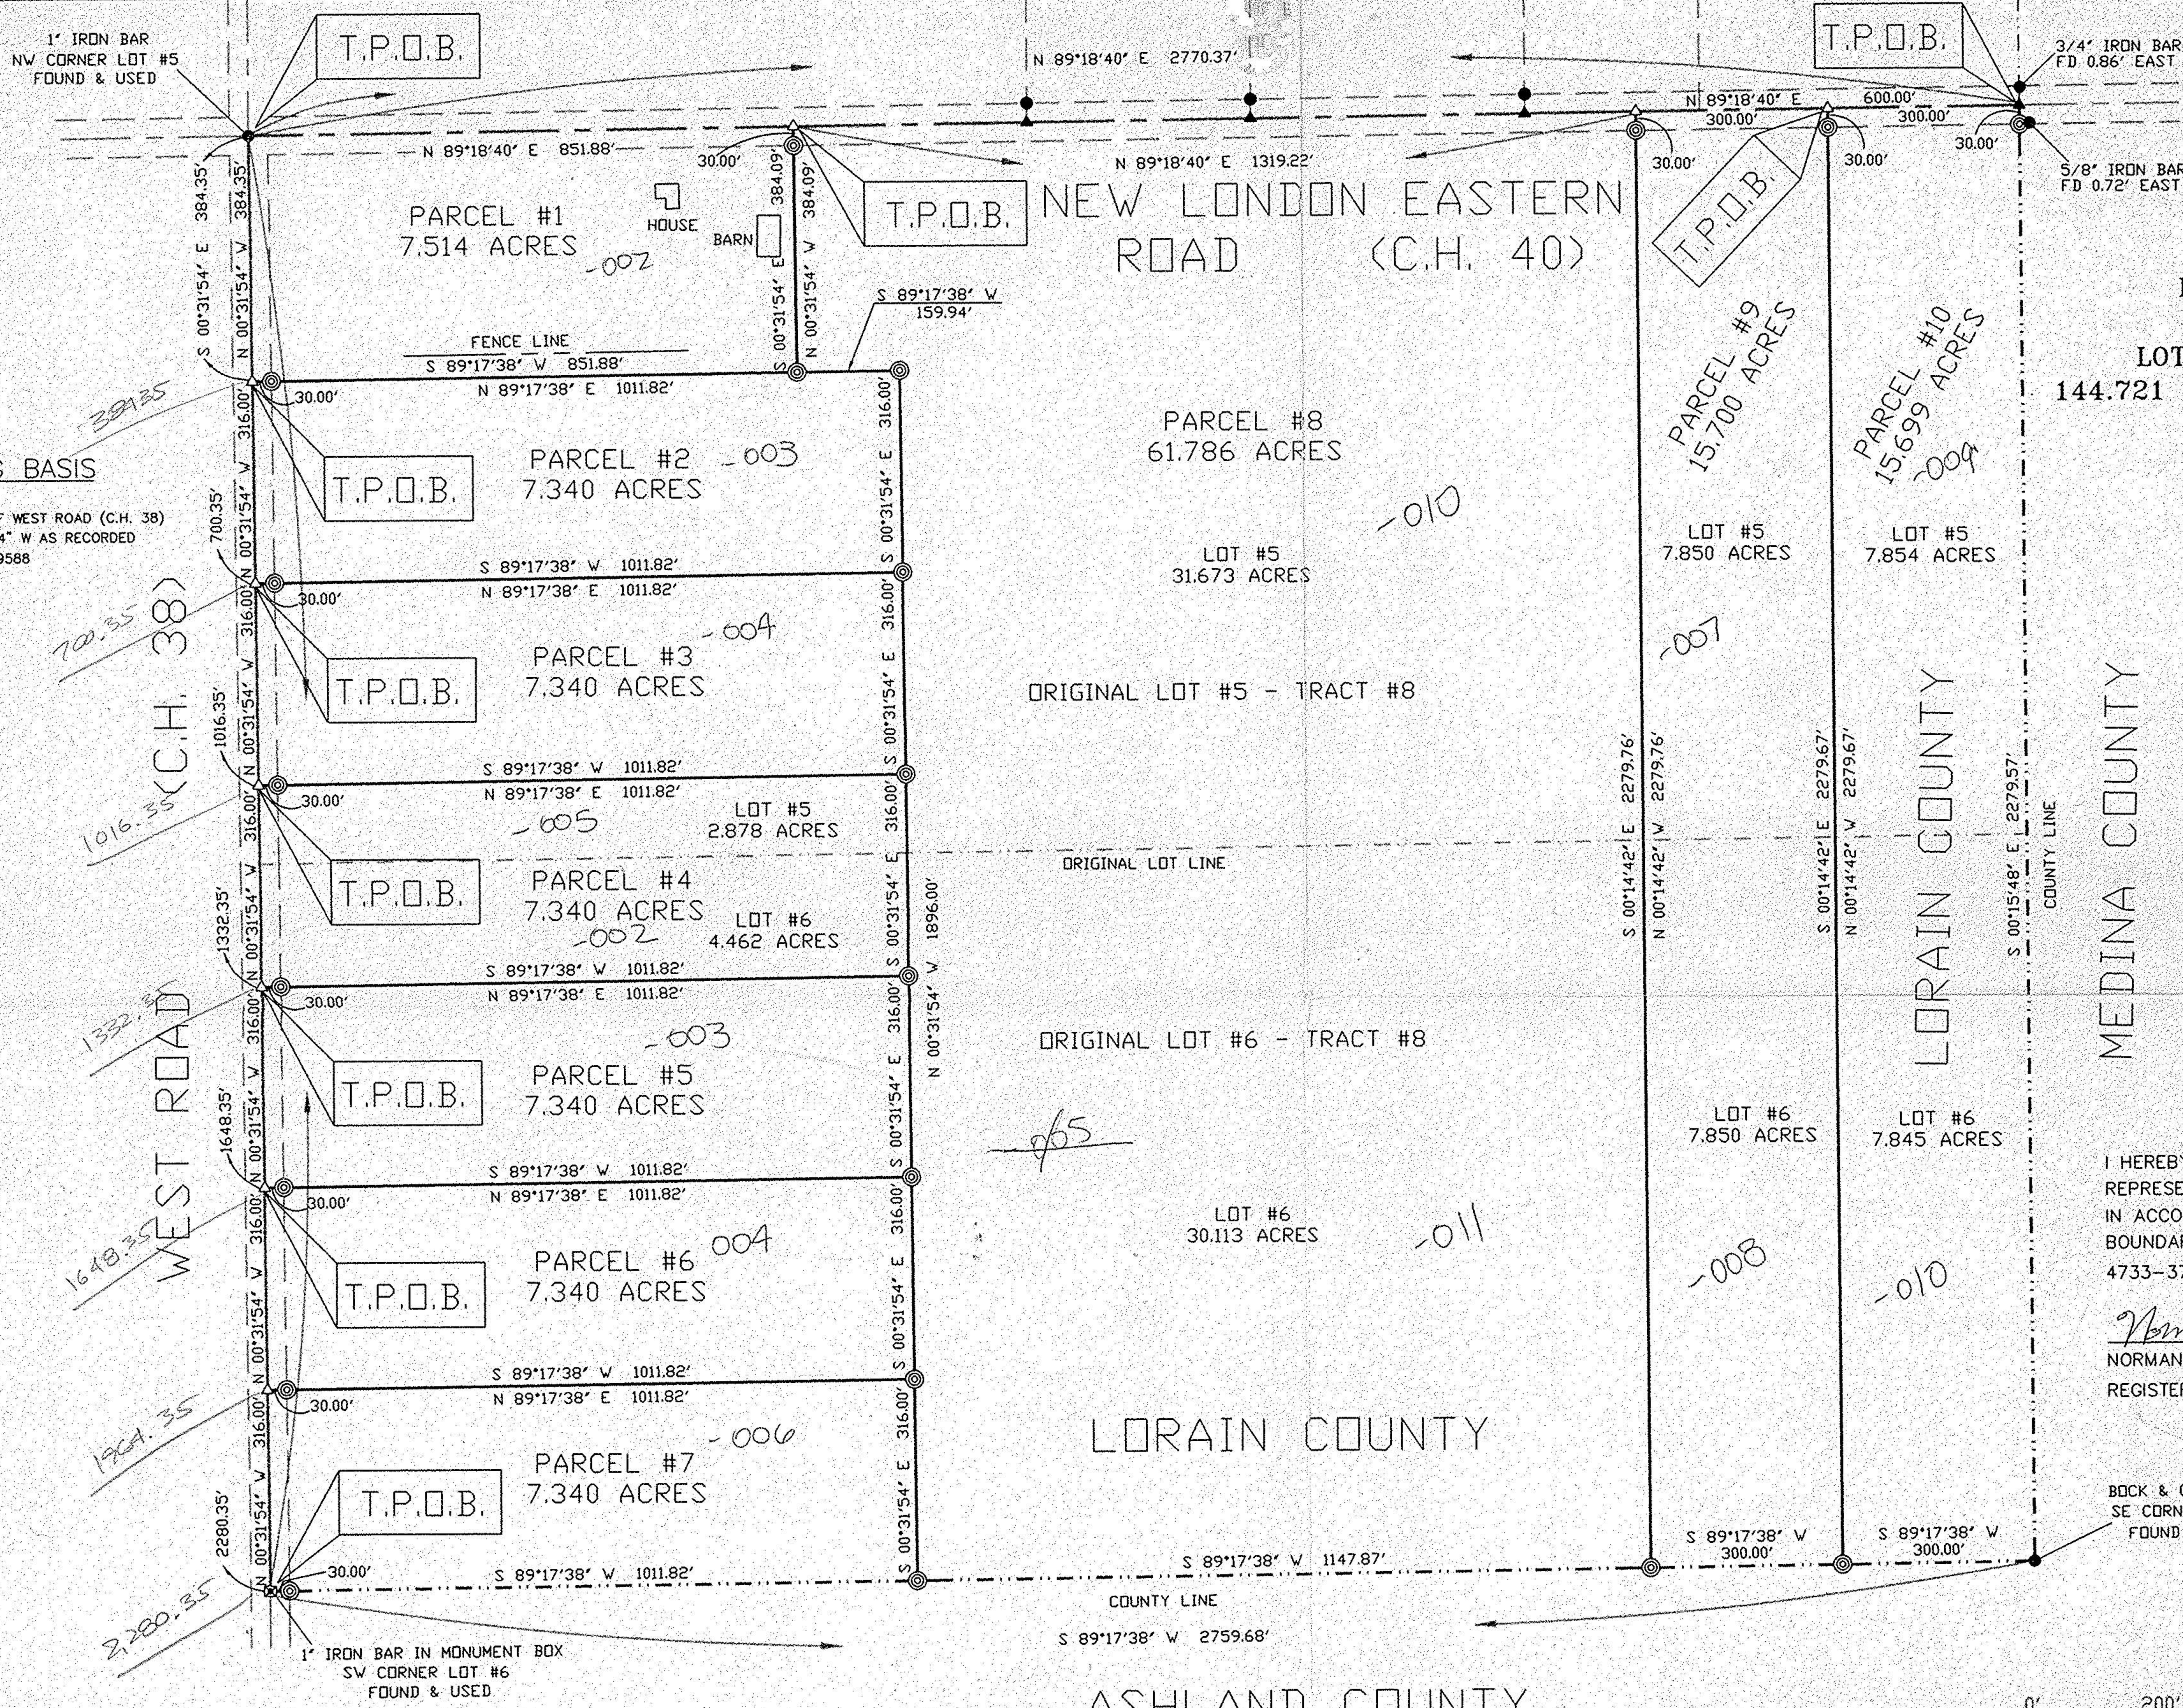


SURVEY PLAT
for
**DAVID L. HAWLEY &
ROSEMARIE A. HAWLEY**
located in
LOTS #5 & #6 - TRACT #8
144.721 ACRES - RECORDING #779588
HUNTINGTON TWP
LORAIN CO, OHIO
OCTOBER, 2001

No 00907
APPROVED
LORAIN CO
MAP DEPT
DATE 11-2-01
PAGE 21H
BY JHATFIELD
#01-00907



I HEREBY CERTIFY THIS PLAT ACCURATELY
REPRESENTS A SURVEY MADE UNDER MY SUPERVISION
IN ACCORDANCE WITH THE MINIMUM STANDARDS FOR
BOUNDARY SURVEYS IN OHIO, PUBLISHED IN CHAPTER
4733-37 OF THE OHIO ADMINISTRATIVE CODE.
Norman G. Nichols 10/18/01
NORMAN G. NICHOLS DATE
REGISTERED PROFESSIONAL SURVEYOR # 5586

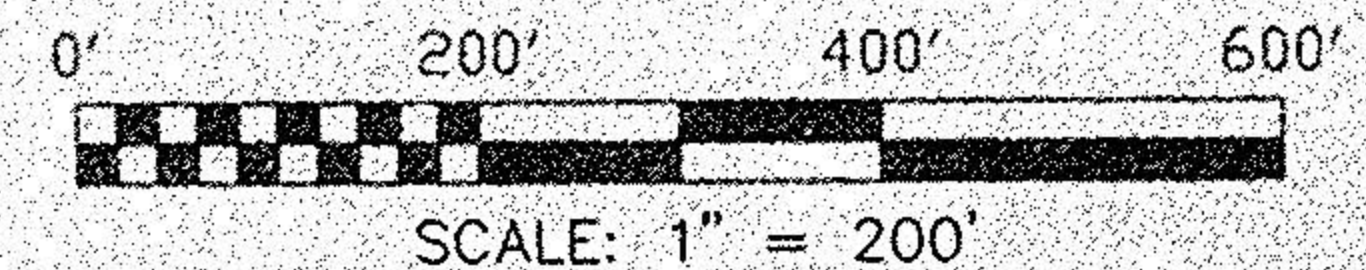

————— PROPERTY LINE
- - - - - COUNTY LINE/PROPERTY LINE

LEGEND	
● IRON BAR FOUND AS NOTED	△ PK NAIL SET
○ IRON PIPE FOUND	▲ PK NAIL FOUND
⊙ #5 REBAR W/NGN #5586 CAP SET	⊠ STANDARD COUNTY MONUMENT

NICHOLS FIELD SERVICES, INC.
1930 FREMONT PL SW
CANTON, OHIO 44706



TEL (330) 453-6688
FAX (330) 453-1764
E-MAIL NFSI2000@AOL.COM

NFSI 2122