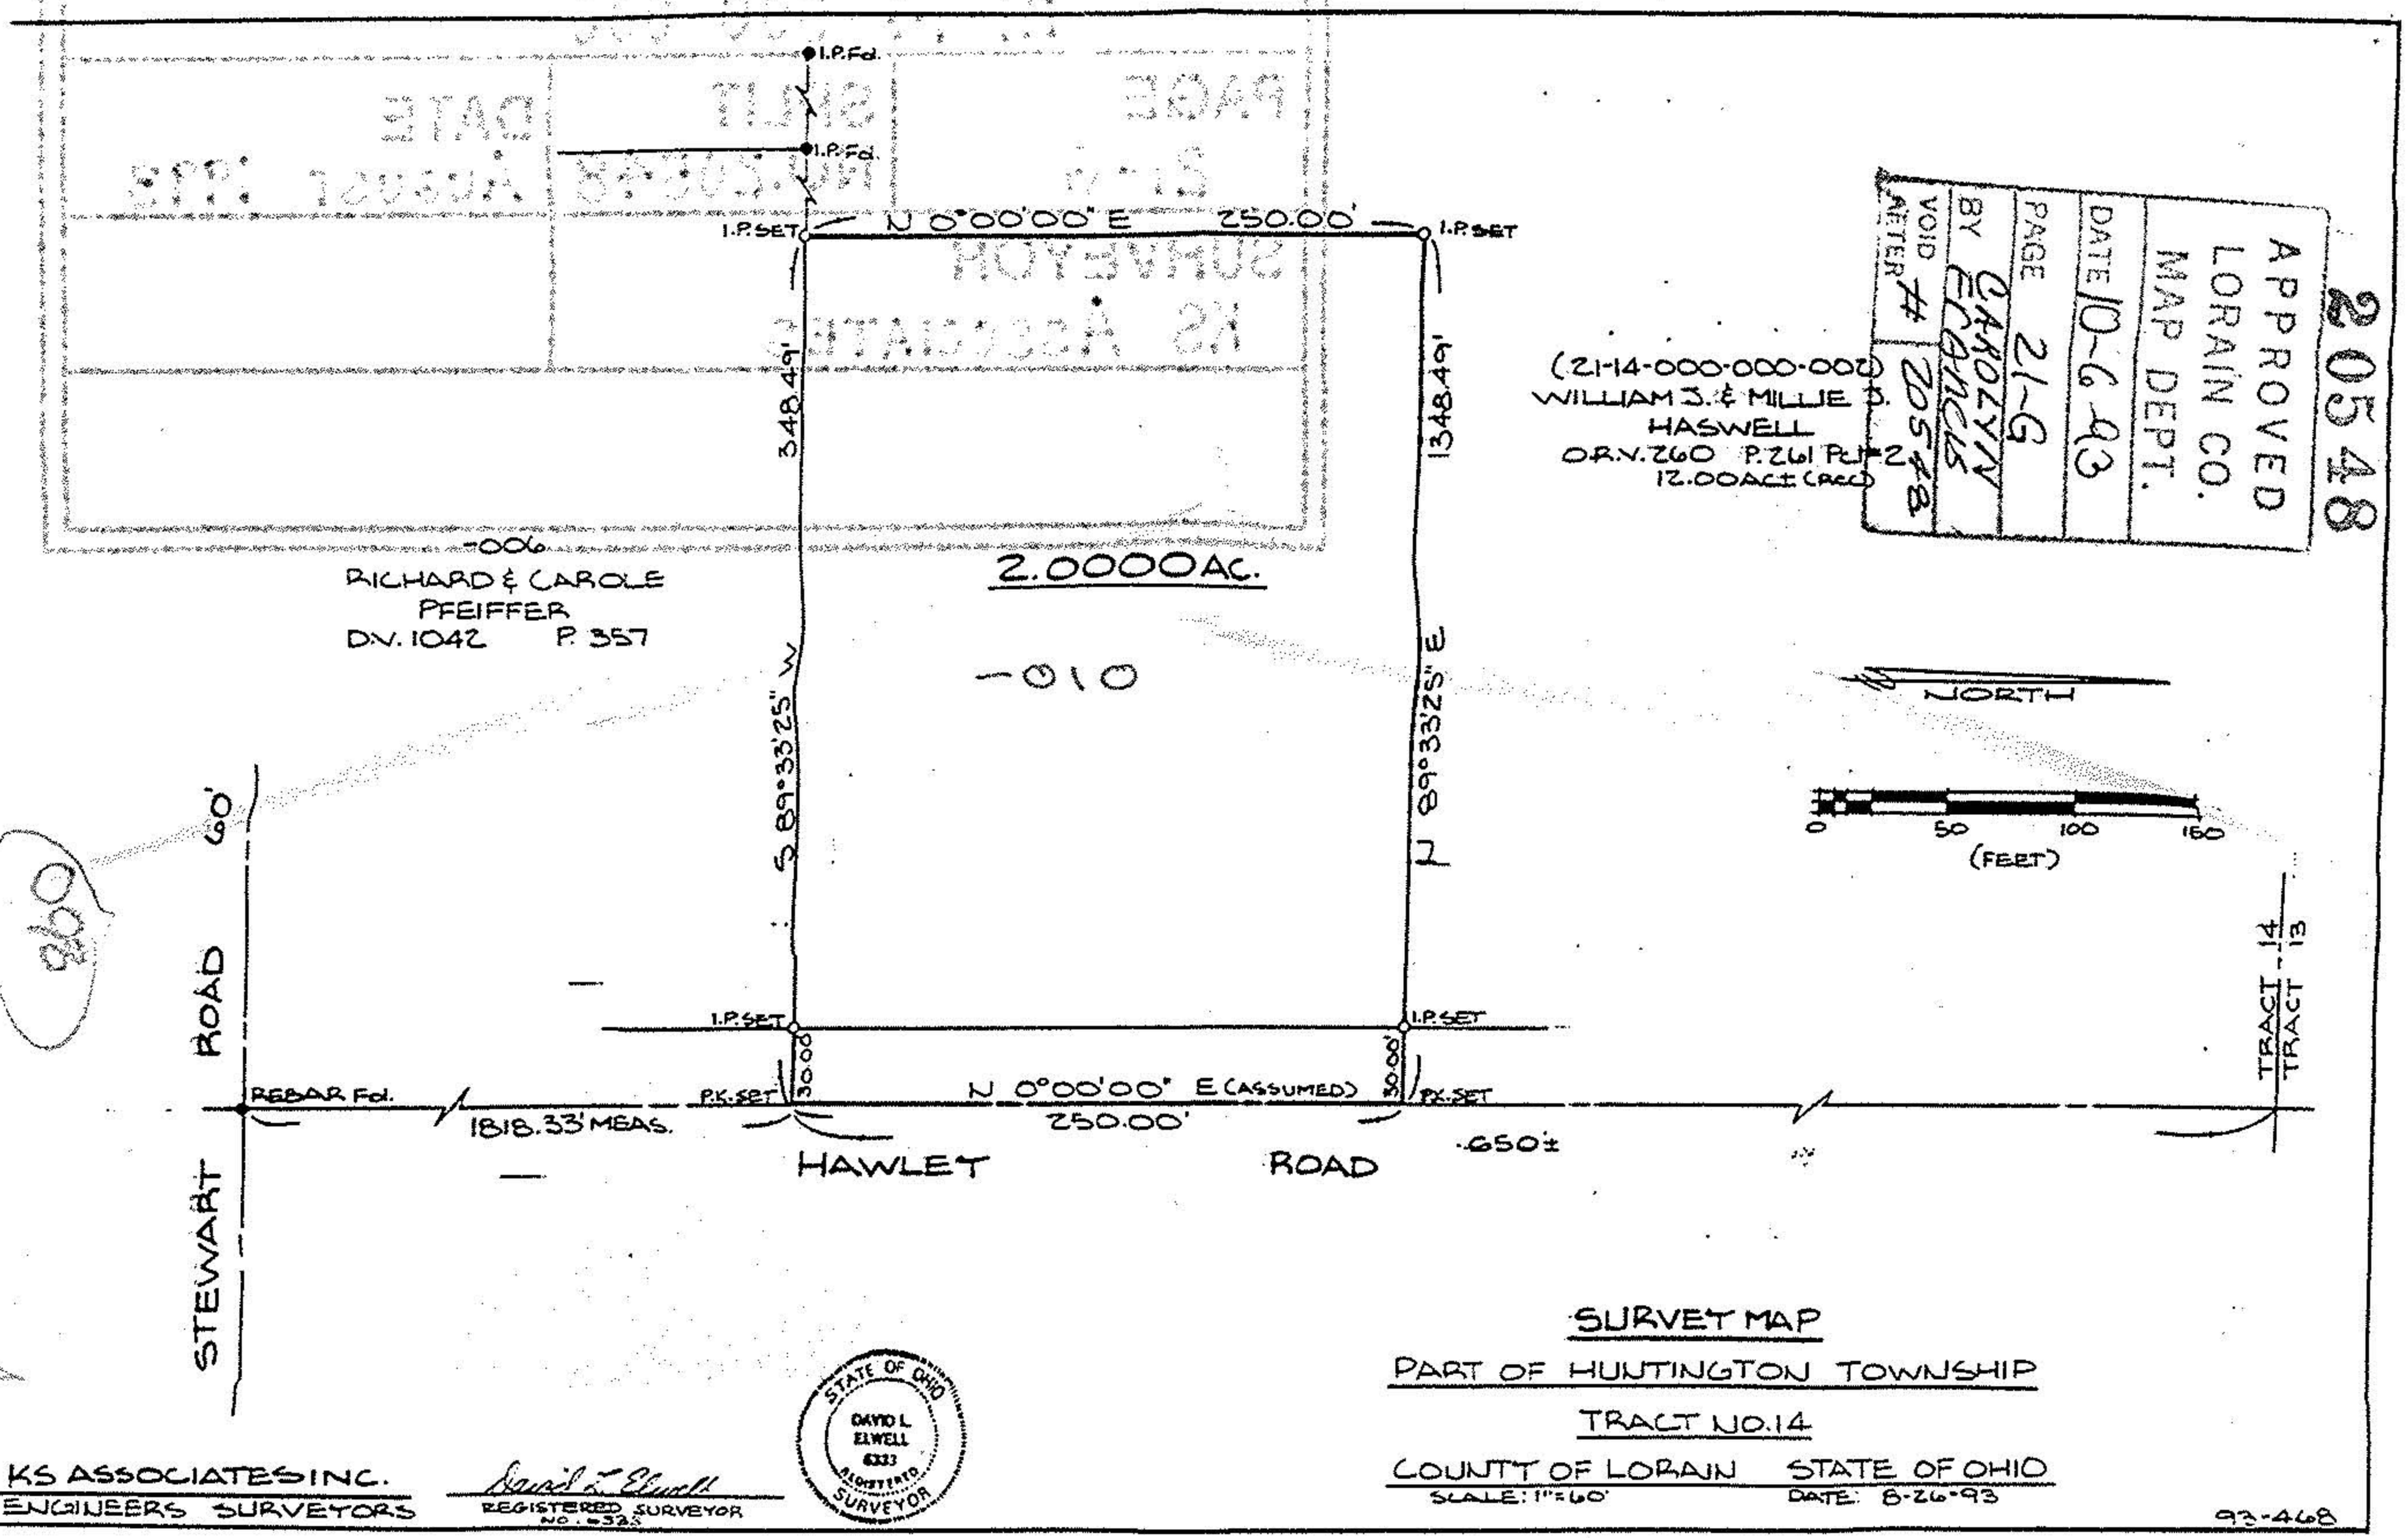

SURVEY MAP

PART OF HUNTINGTON TOWNSHIP

TRACT NO.14

COUNTY OF LORAIN STATE OF OHIO

SCALE: 1"=60' DATE: 8-26-93

KS ASSOCIATES INC.
ENGINEERS SURVEYORS

David L. Elwell
REGISTERED SURVEYOR
NO. 6333

STATE OF OHIO
DAVID L. ELWELL
6333
REGISTERED
SURVEYOR

93-468