



01-00-002-102-025
 01-00-002-102-026
 01-00-002-102-057
 1-00-002-B

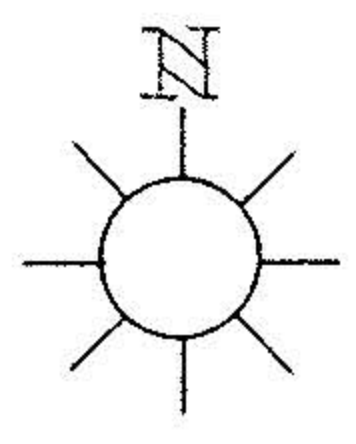

LAKE

ERIE

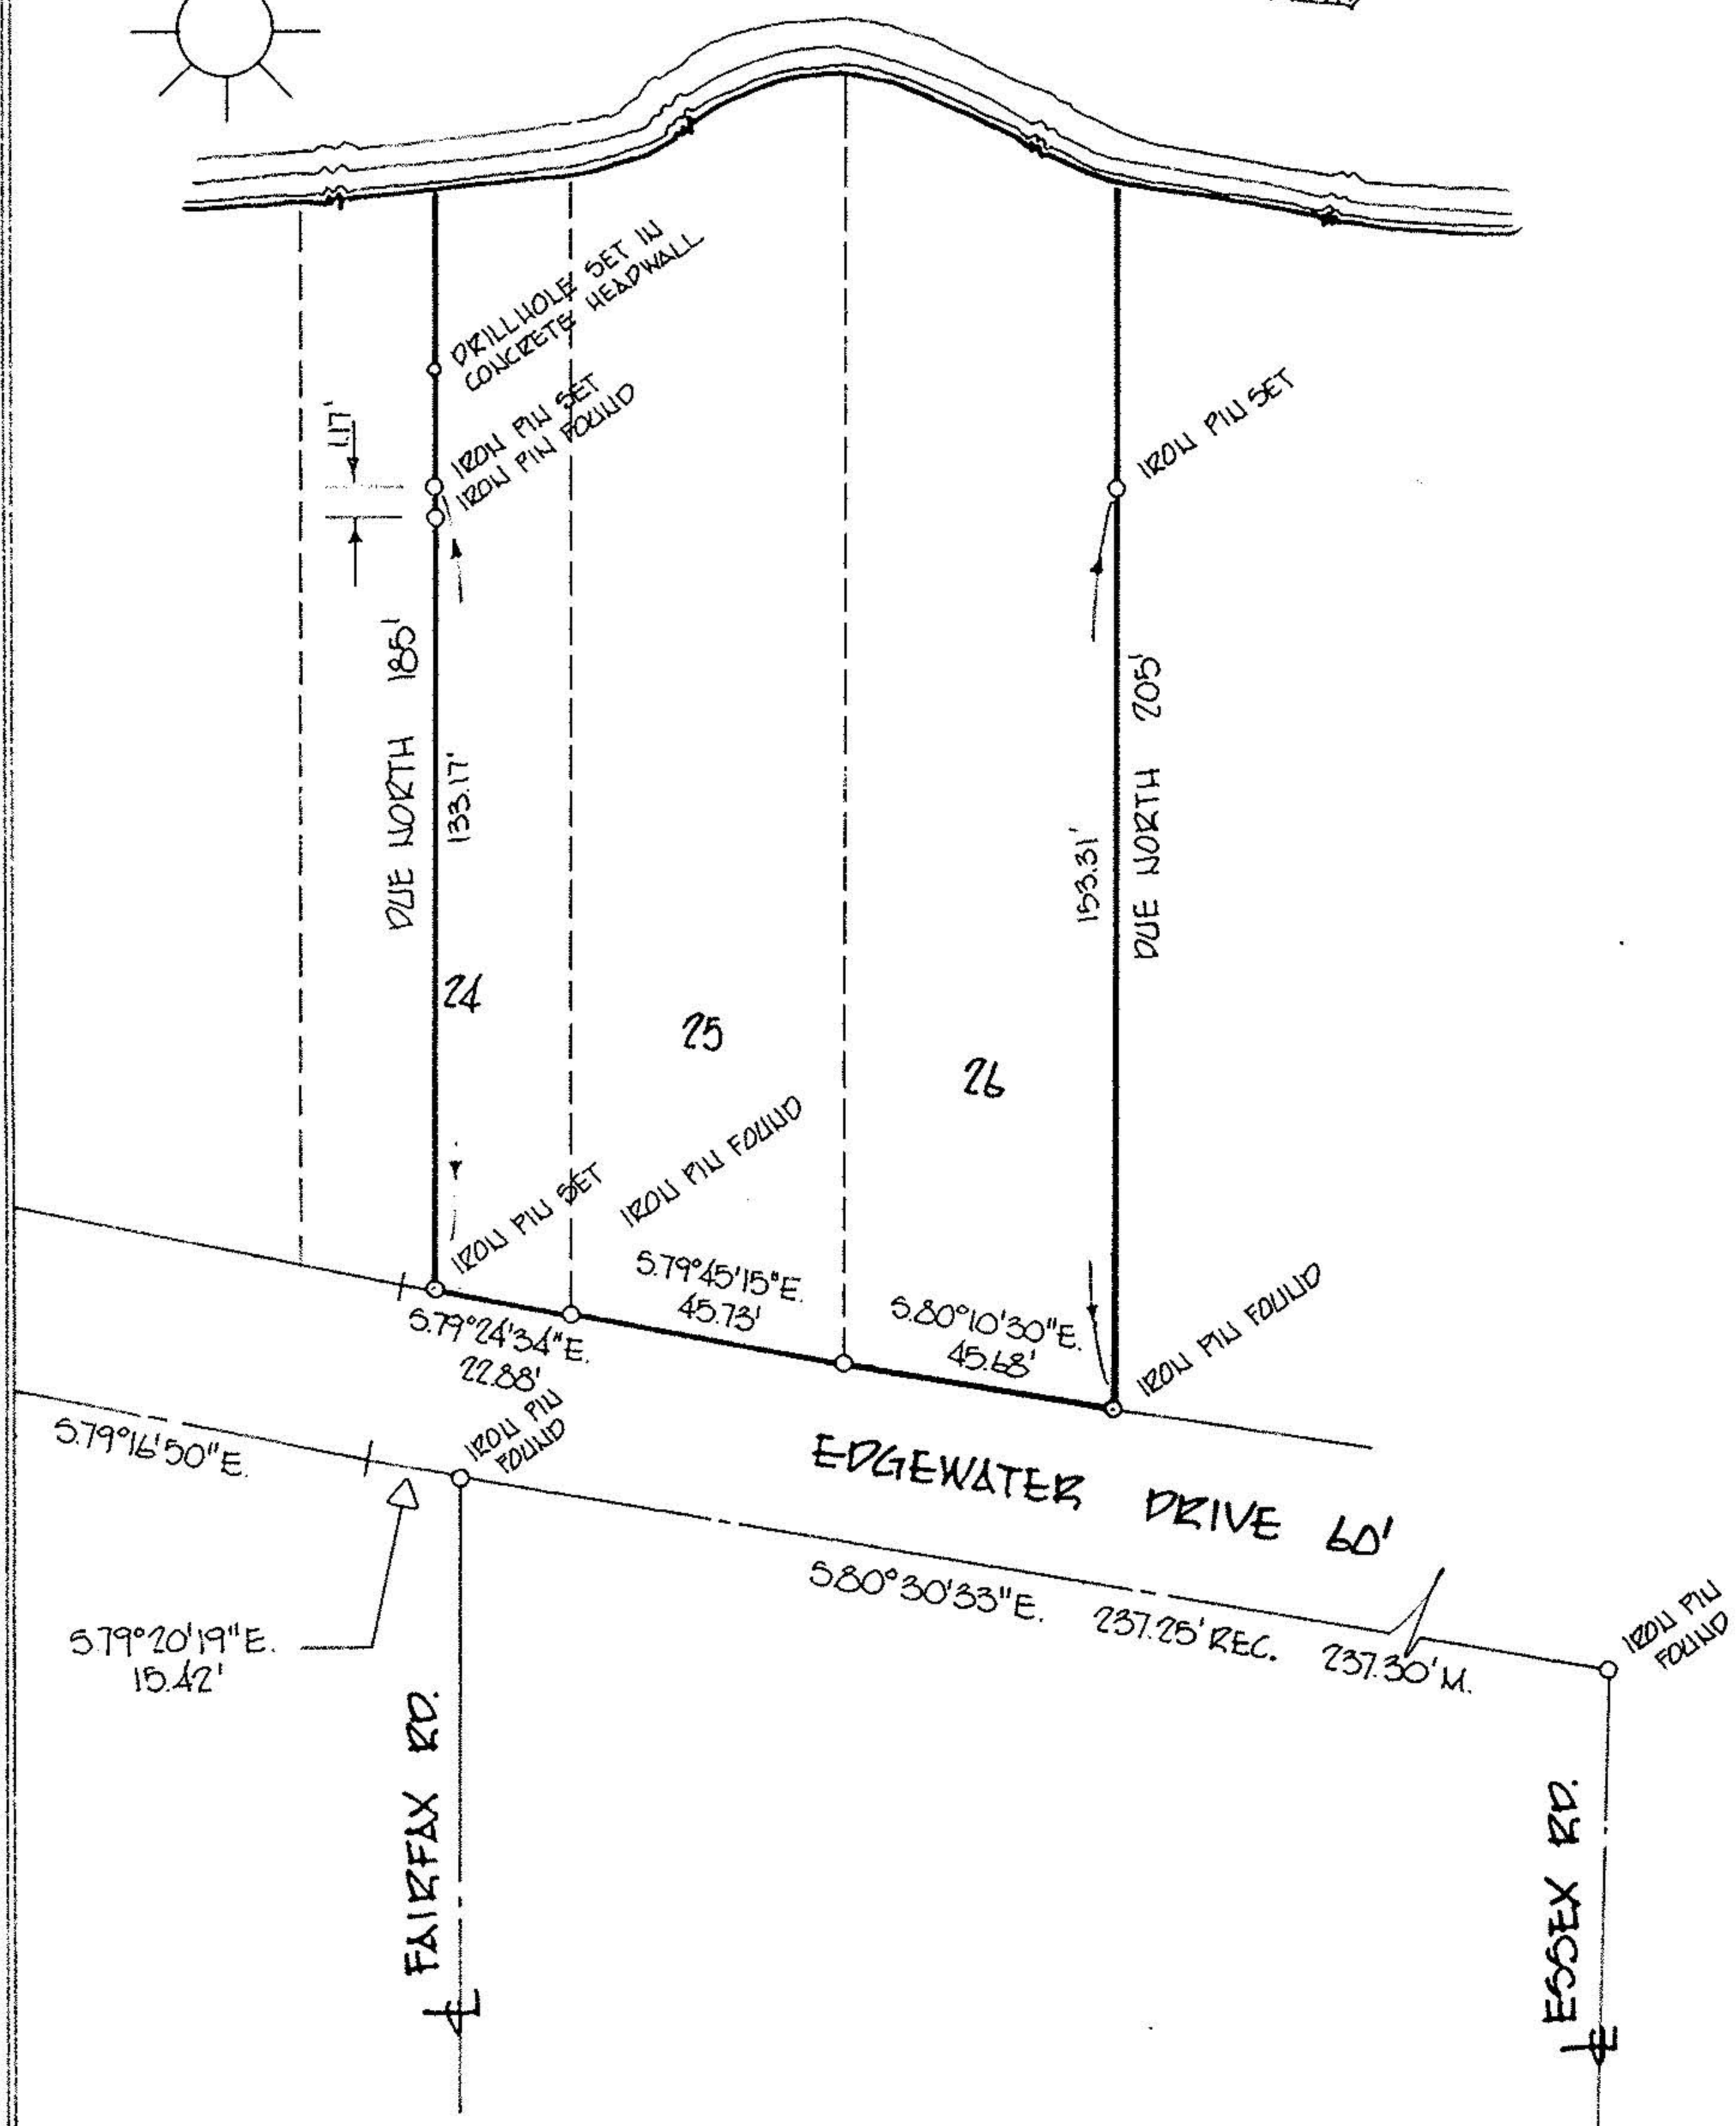

PERIMETER SURVEY
 perm. parcel _____
 acreage _____

MICHAEL G. HURA & ASSOCIATES
 3409 LIBERTY AVE. VERMILION, OHIO

drawn FAZ
 date 4.6.81
 scale 1" = 40 ft

SUBLOT $\frac{1}{2}$ of 24, ALL of 25, 26 of VERMILION-ON-THE-LAKE
 as recorded in Plat Vol. 16 Page 32, 33

PART of Original Lot _____, Tract _____ Section _____ of
 _____ Township _____ County _____

City of VERMILION
 OHIO

