


02-01-003-114-015  
2-01-003-B

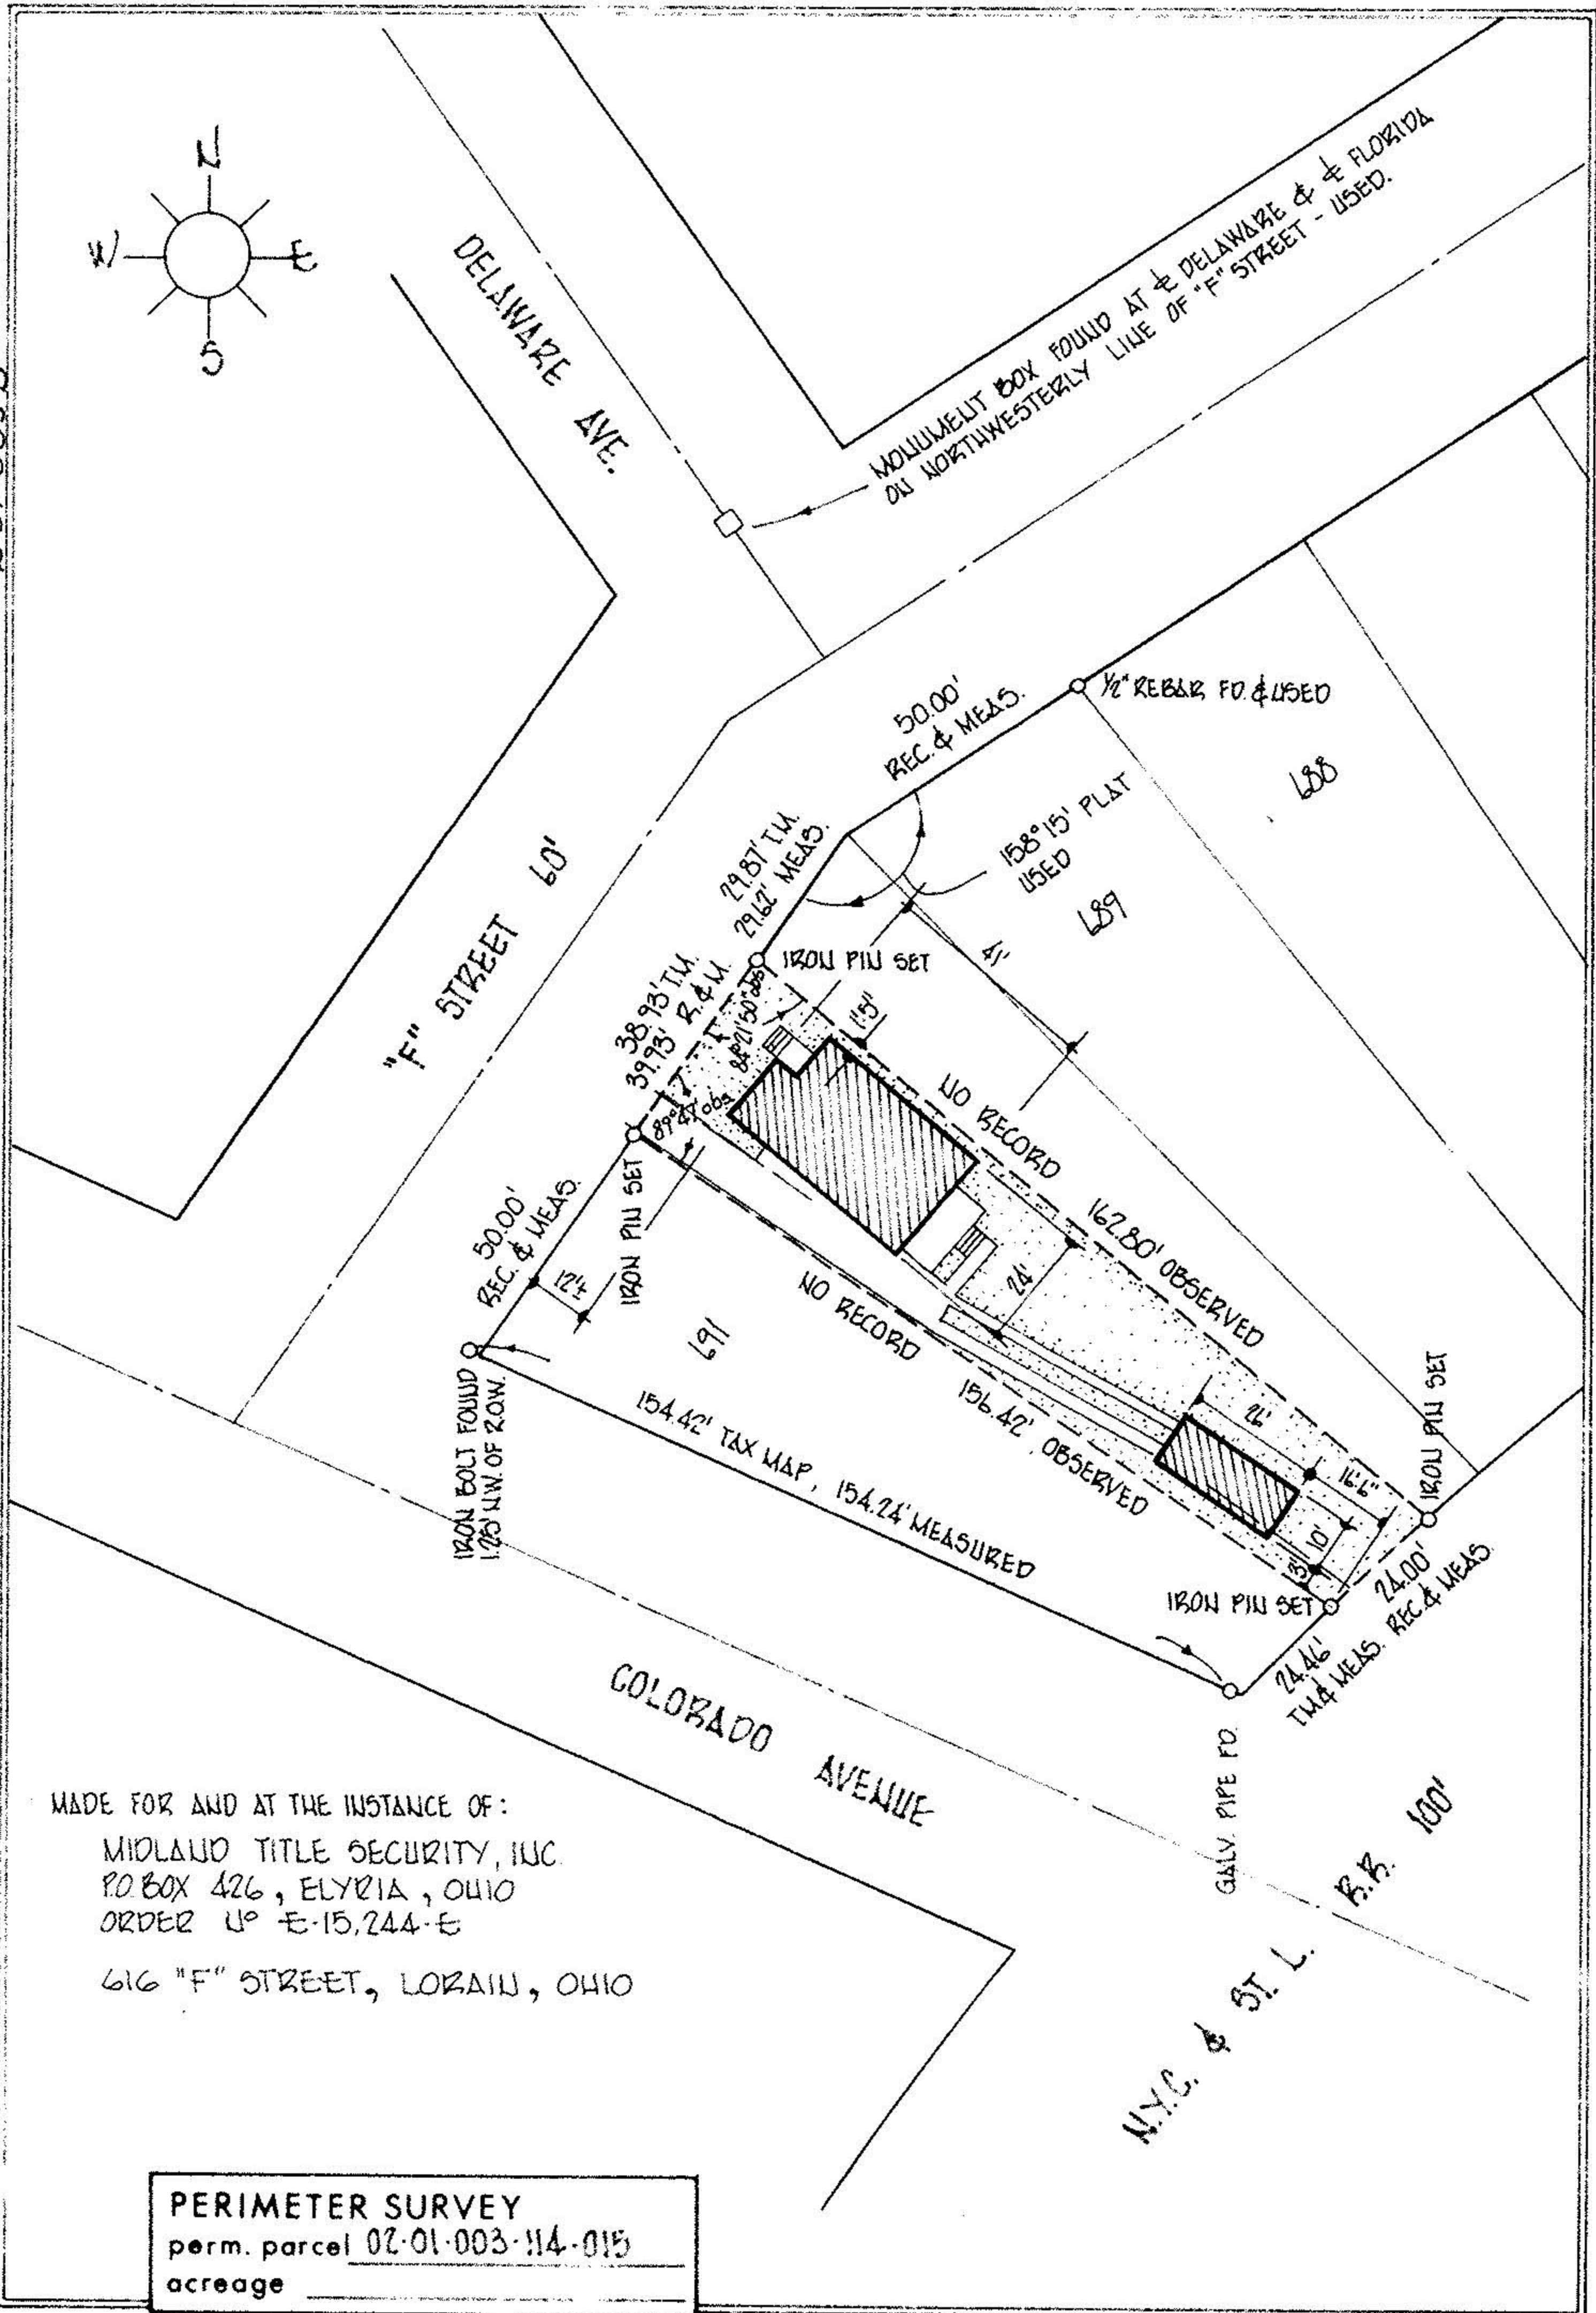

MADE FOR AND AT THE INSTANCE OF:  
 MIDLAND TITLE SECURITY, INC.  
 P.O. BOX 426, ELYRIA, OHIO  
 ORDER UP E-15,244-E  
 616 "F" STREET, LORAIN, OHIO

**PERIMETER SURVEY**  
 perm. parcel 02-01-003-114-015  
 acreage \_\_\_\_\_

<b>MICHAEL G. HURA &amp; ASSOCIATES</b> 3409 LIBERTY AVE. VERMILION, OHIO		drawn p.a.r. date 12-16-80 scale 1" = 40 ft	
SUBLOT PARTS - 690 & 691 of C.A. STURTEVANT'S FAIRHOME ALLOTMENT as recorded in Plat Vol. 4 Page 13			
PART of Original Lot <u>3</u> , Tract <u>1</u> Section _____ of <u>BLACK RIVER</u> Township <u>LORAIN</u> County		City of <u>LORAIN</u> _____ OHIO	