02-01-006-155-012
2-01-006-F

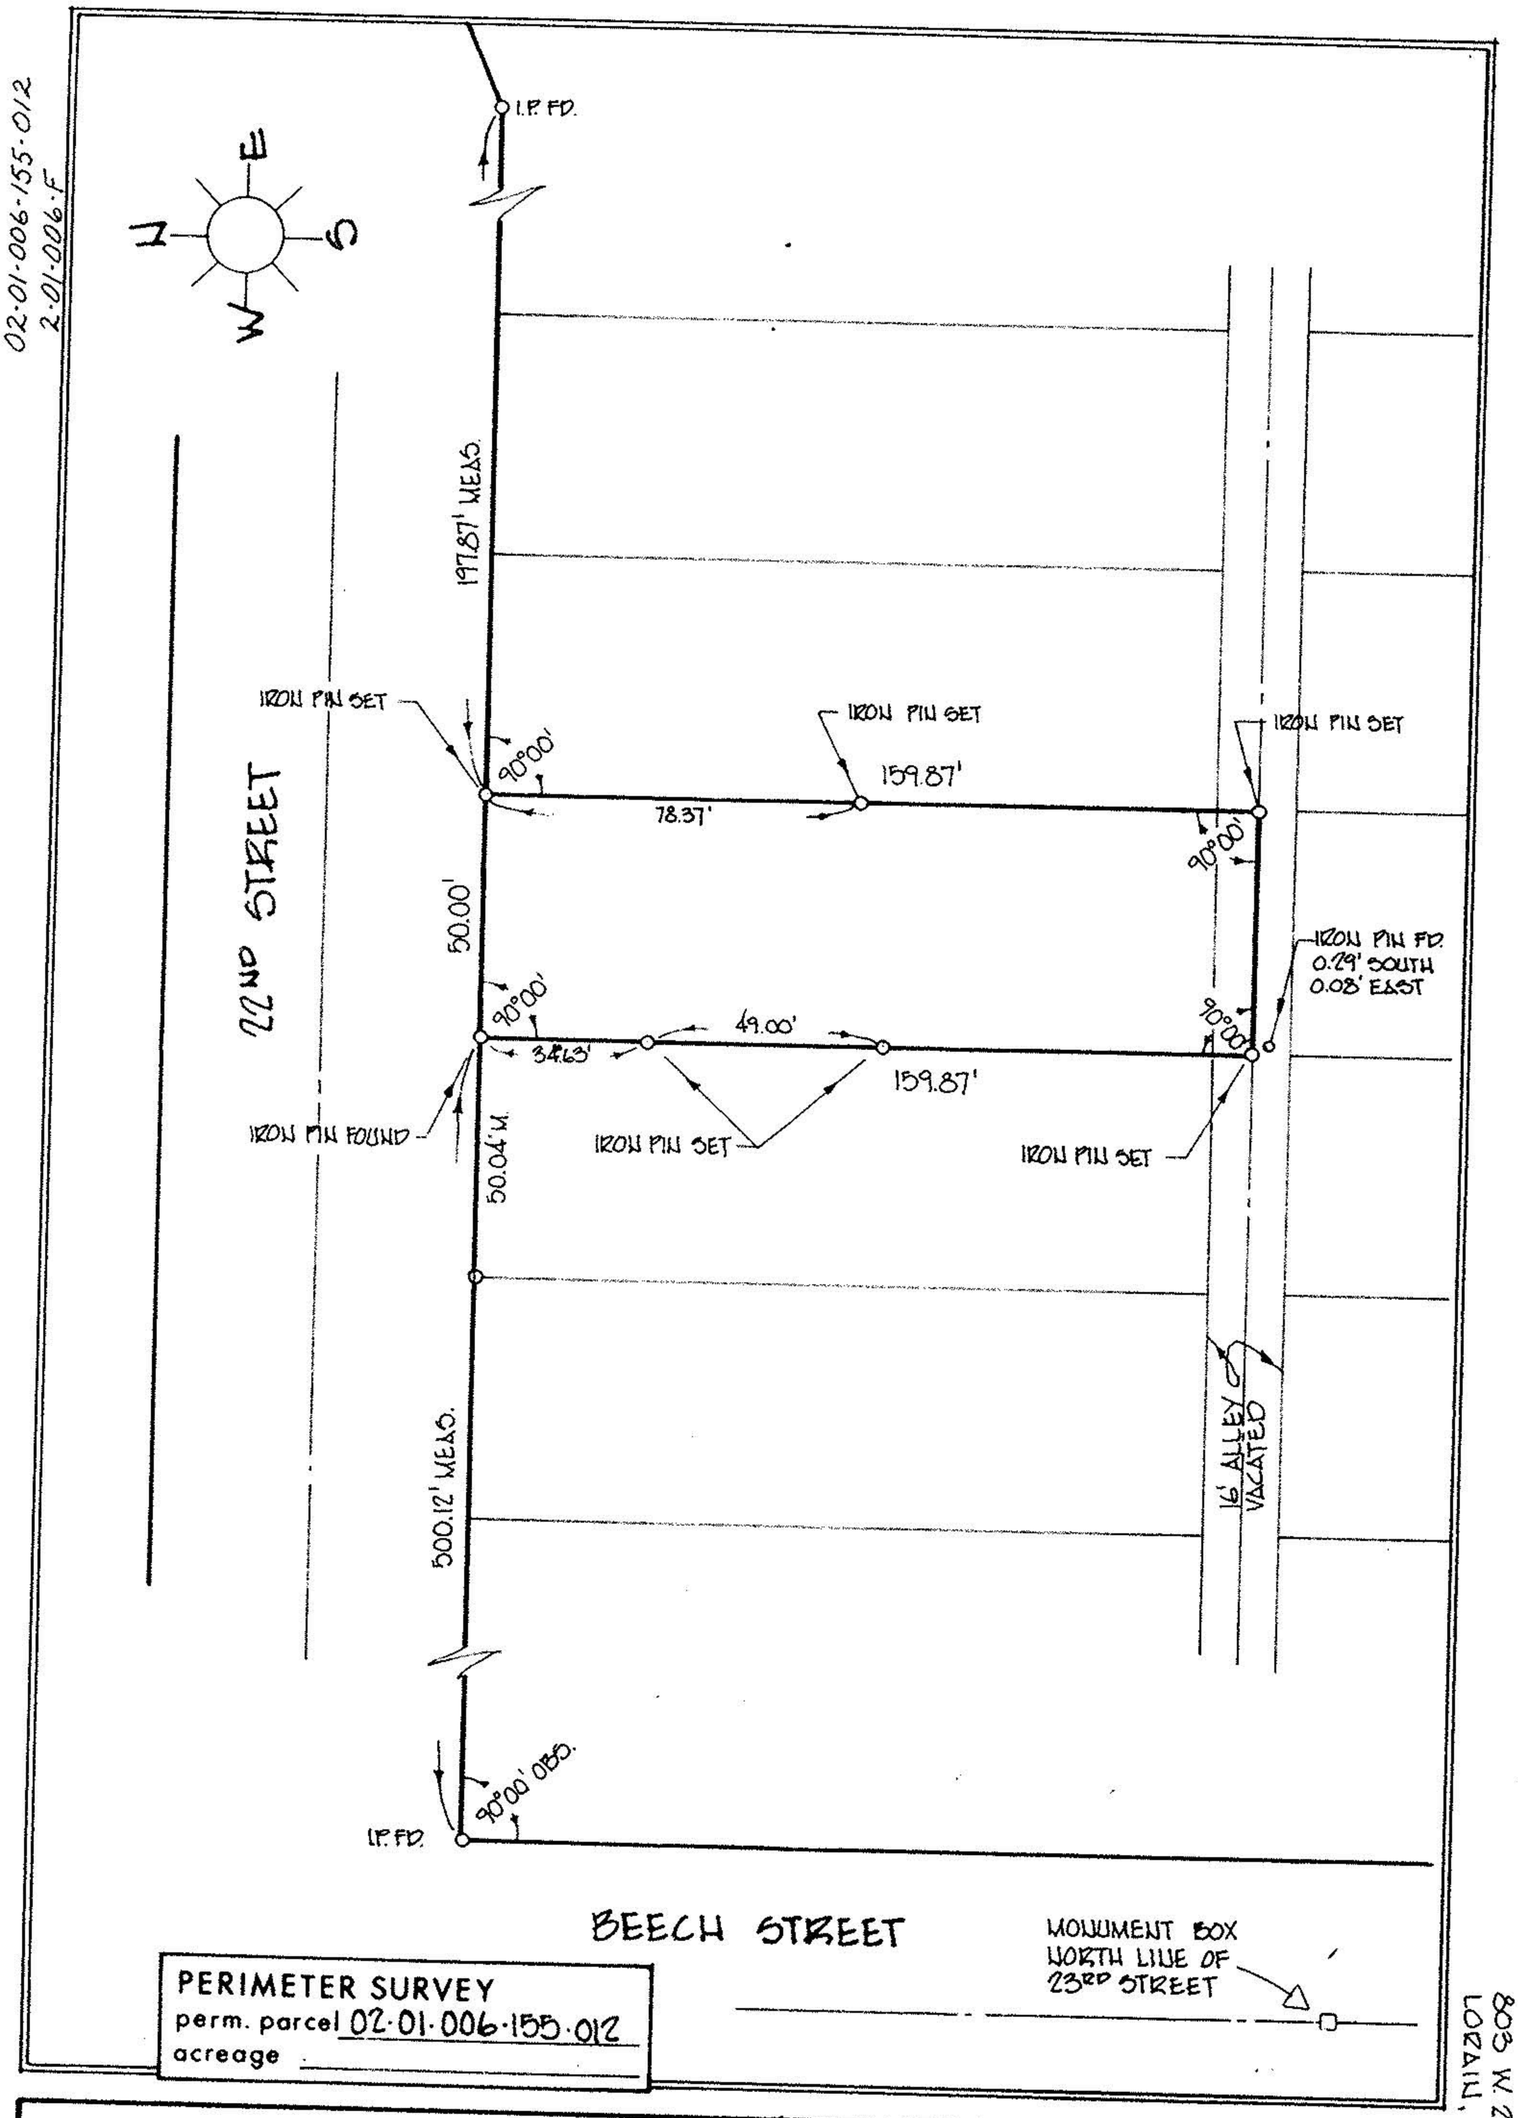

PERIMETER SURVEY
perm. parcel 02-01-006-155-012
acreage

RAYMOND DELGADO JR.
803 W. 22ND STREET
LORAIN, OHIO
246-2646

MICHAEL G. HURA & ASSOCIATES
3409 LIBERTY AVE. VERMILION, OHIO

drawn P.A.R.
date 4-20-81
scale 1" = 40' ft

SUBLOT 51 of STANG'S 2ND SUB.
as recorded in Plat Vol. 4 Page 18

PART of Original Lot 6, Tract 01 Section ____ of BLACK RIVER Township LORAIN County

City of LORAIN OHIO

STATE OF OHIO
PHILLIP A. ROSEBECK
No. 6696
REGISTERED SURVEYOR