


02-02-023-111-032
2-02-023-B

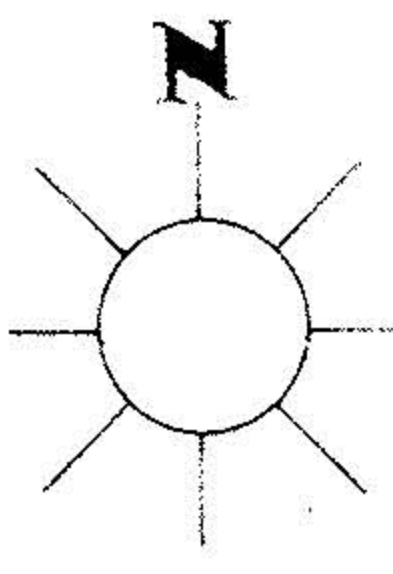

IRON PIN FOUND
004'S, 002'E

IRON PIN FOUND
011'N, 003'E

IRON PIN SET

IRON PIN FOUND
004'E

IRON PIN FOUND

40' RECORD
39.96' MEAS

110' RECORD
109.98' MEAS

90° obs

40.00' USED

109.96' MEAS
110' RECORD

90° obs

379

378

377

376

375

374

382

381

LEAVITT ROAD 66'

PERIMETER SURVEY

Scale 1" = 40'
Acreage

SUBLOT 379 of _____
LAKEVIEW ALLOTMENT
Plat Vol 6 Page 9, 10
Part of O.L. 23 Section _____
Tract 2 BLACK RIVER TWP
City of LORAIN
LORAIN Co., Ohio

Michael G. Hura & Associates
4560 Liberty Ave. Vermilion, Ohio
drawn par
date 4 22 80
scale 1" = 40'
field book 14

PERMANENT
PARCEL NUMBER
JAY METZGER
02 02 023 111 032