


02-02-027-106-022

2-02-027

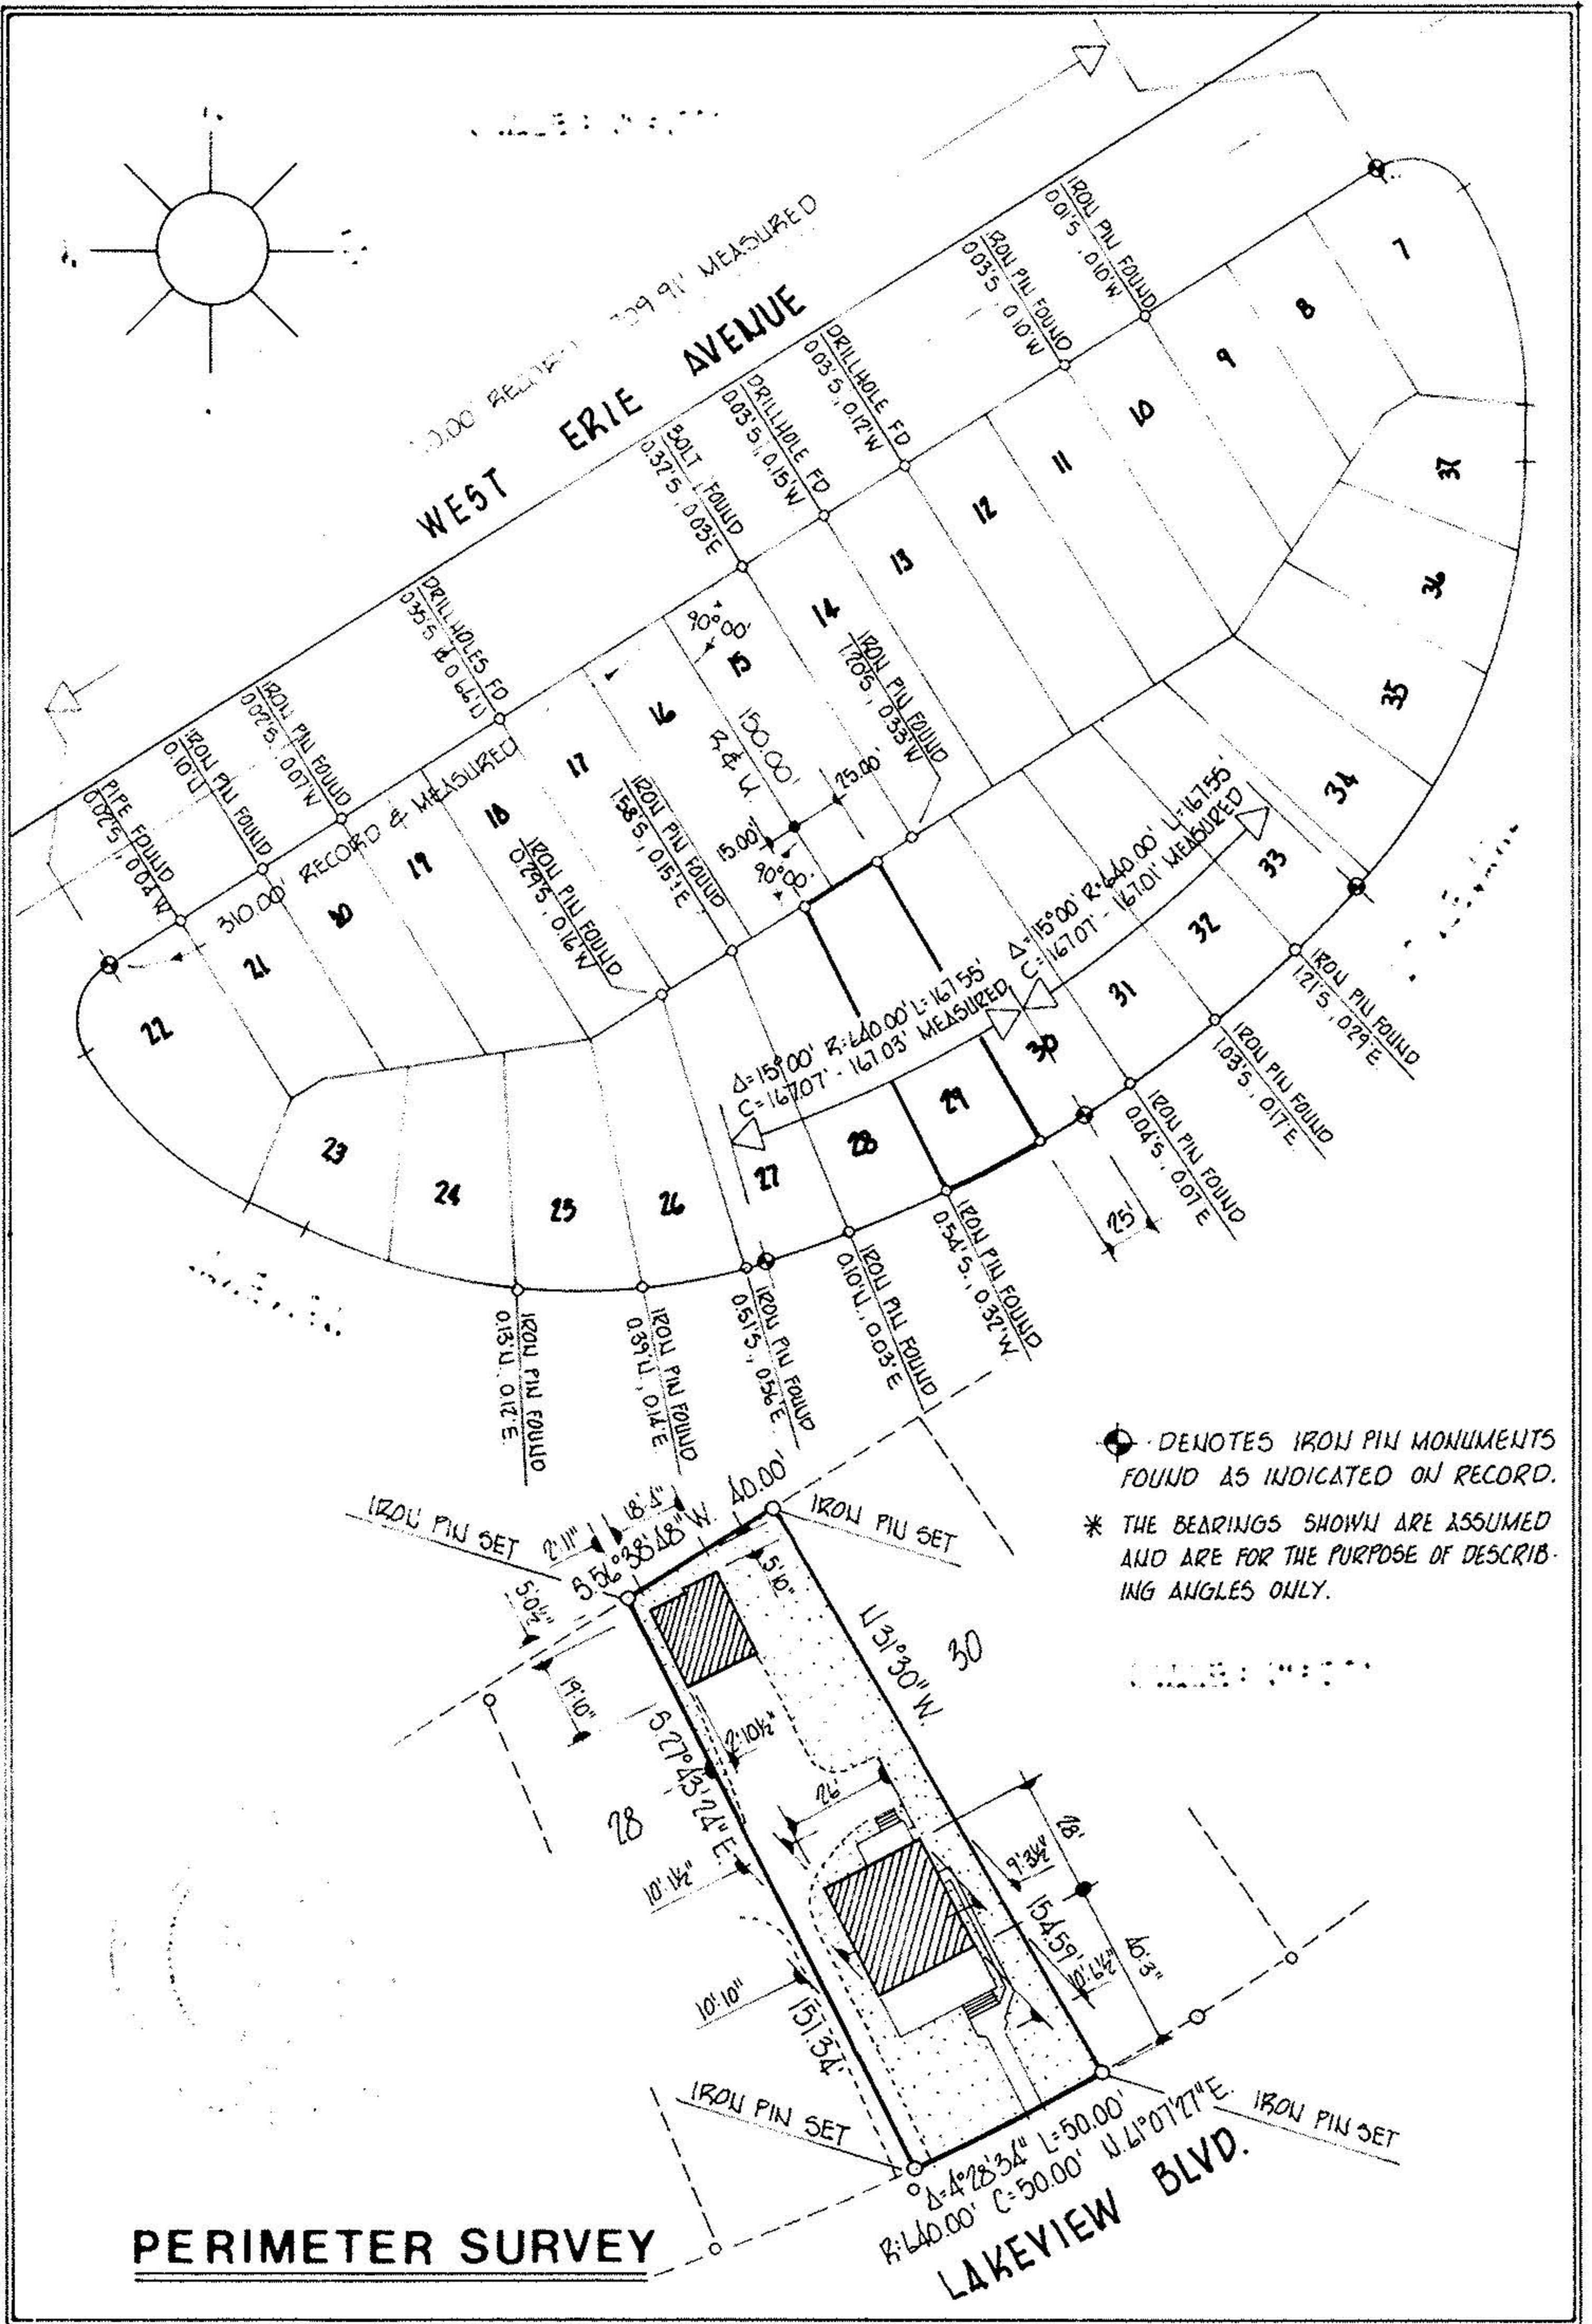

SUBLOT 27 of 35 Sublots

Plat Vol 7 Page 1

Part of O.L. Section

Tract TWP

City of Co., Ohio

Michael G. Hura & Associates

4560 Liberty Ave. Vermilion, Ohio

drawn

date

scale

field book

PERMANENT
PARCEL NUMBER