



3-00-032-104-013  
3-00-032-A

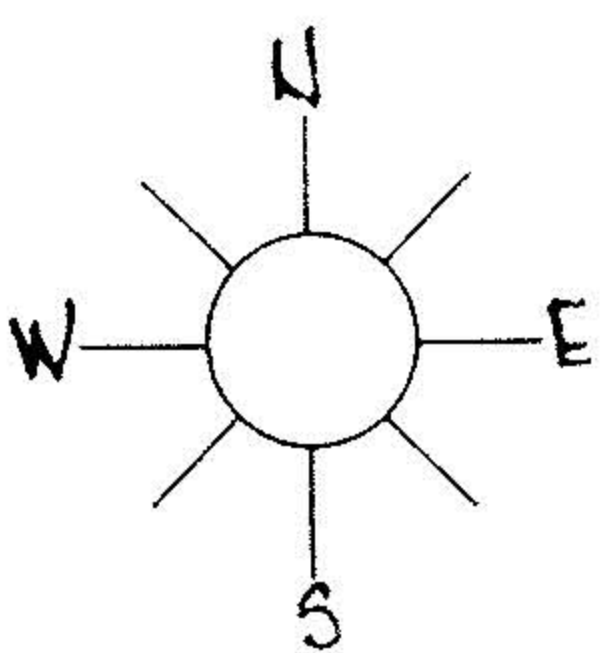

LYNNE DRIVE

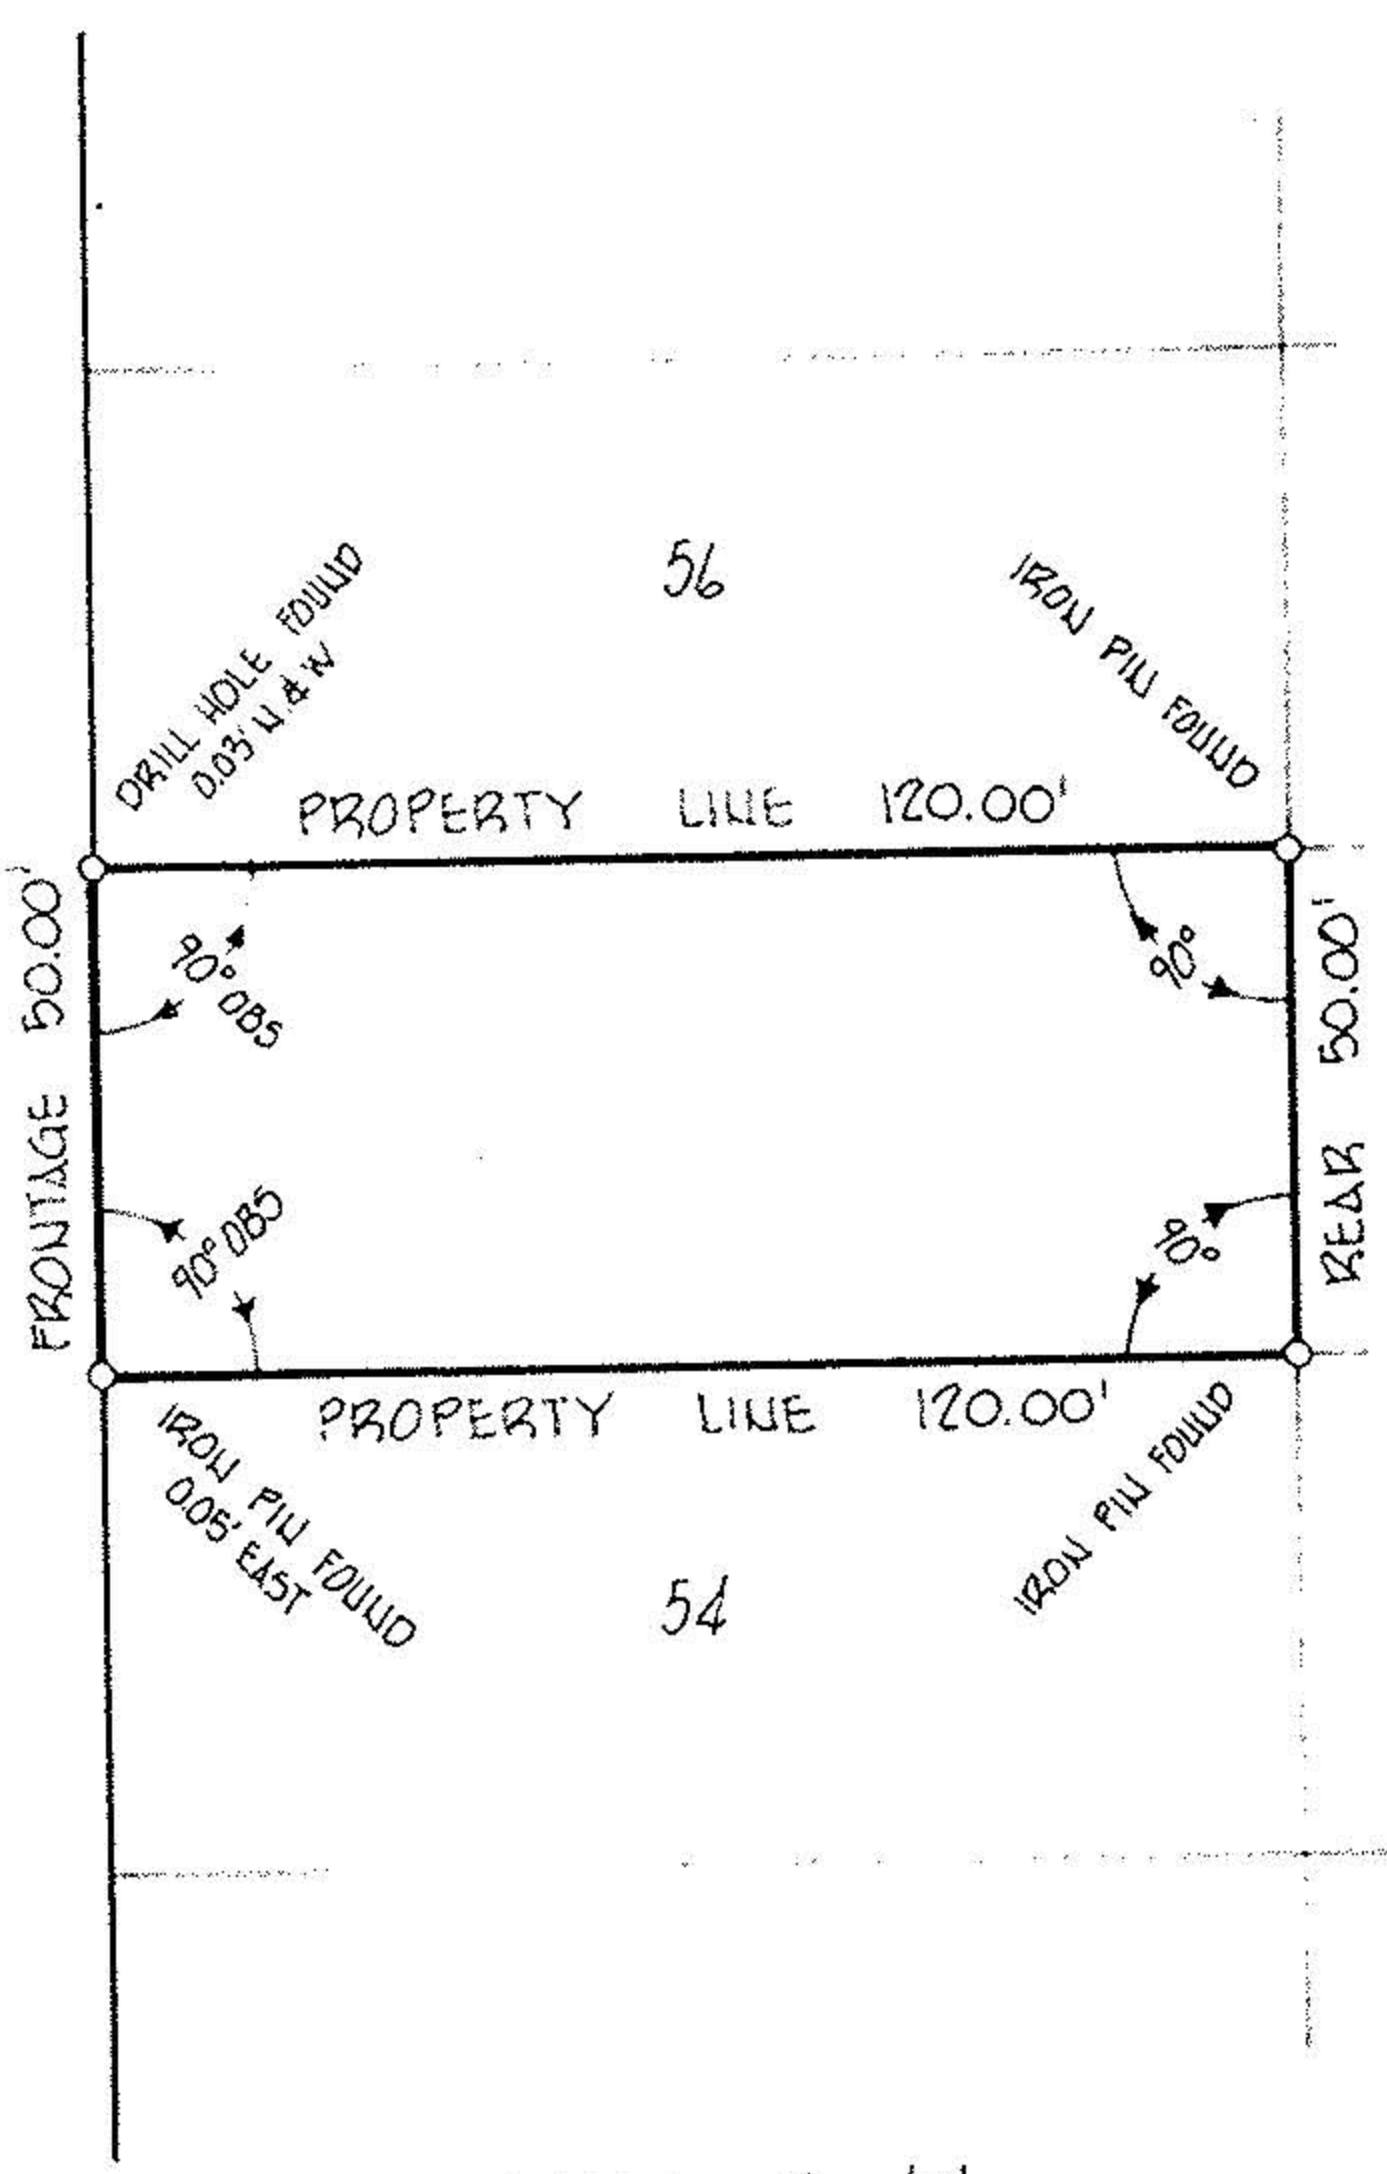

SCALE: 1" = 40'

**PERIMETER SURVEY**

120' P.I.U. FOUND  
MONUMENT BOX

HAWTHORNE AVENUE


DRIVE

LYNNE

WALKER ROAD

MONUMENT BOX  
120' P.I.U. FOUND

154168 RECORD 154166 MEASURED  
151835 RECORD 151829 MEASURED

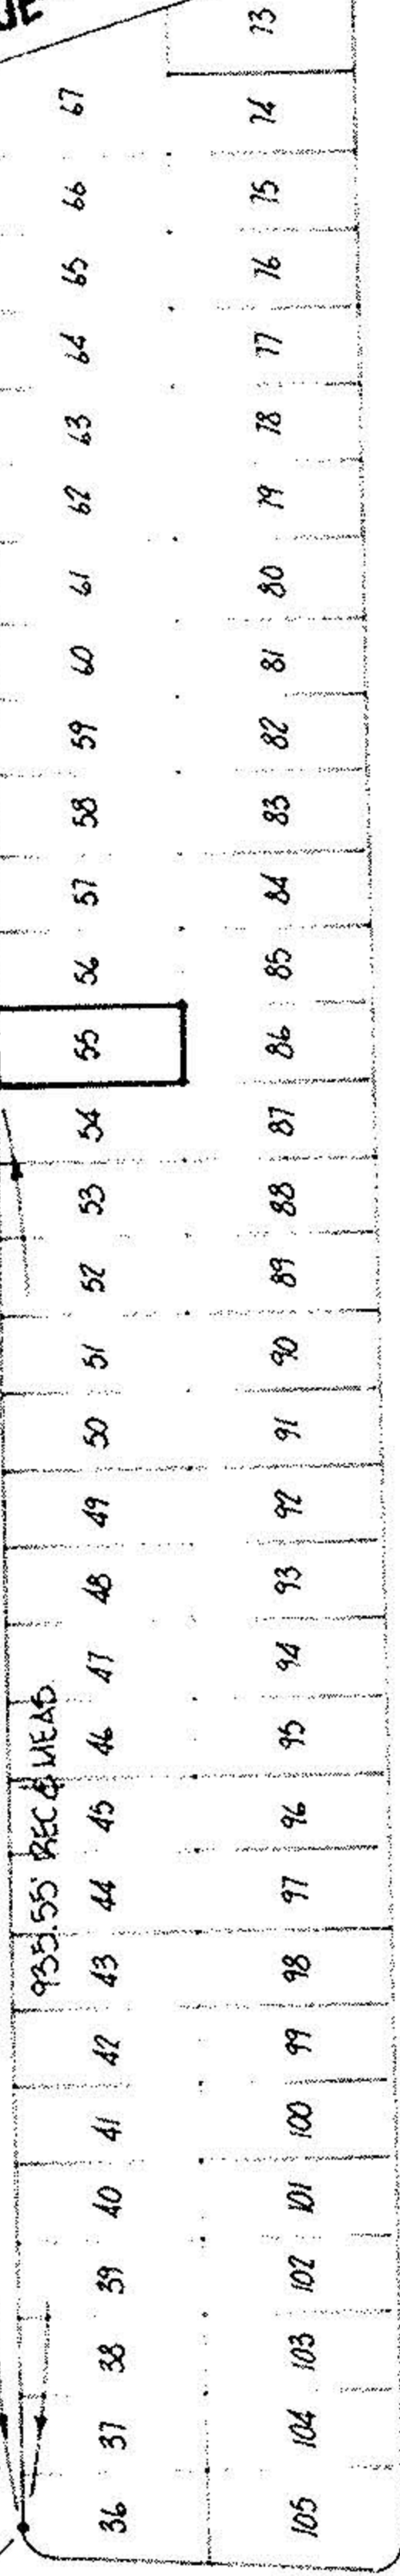

SCALE: 1" = 200'

Scale 1" : \_\_\_\_\_  
Acreage \_\_\_\_\_

SUBLOT 55 of WEST 1/4  
Plat Vol 20 Page 40  
Part of O.L. 32 Section \_\_\_\_\_  
Tract SHEFFIELD TWP  
City of SHEFFIELD LAKE  
LORAIN Co., Ohio

**Michael G. Hura & Associates**  
4560 Liberty Ave. Vermilion, Ohio  
drawn \_\_\_\_\_  
date 9-12-80  
scale \_\_\_\_\_  
field book \_\_\_\_\_

PERMANENT  
PARCEL NUMBER  
03-00-032-104-013