


03-00-036-101-001

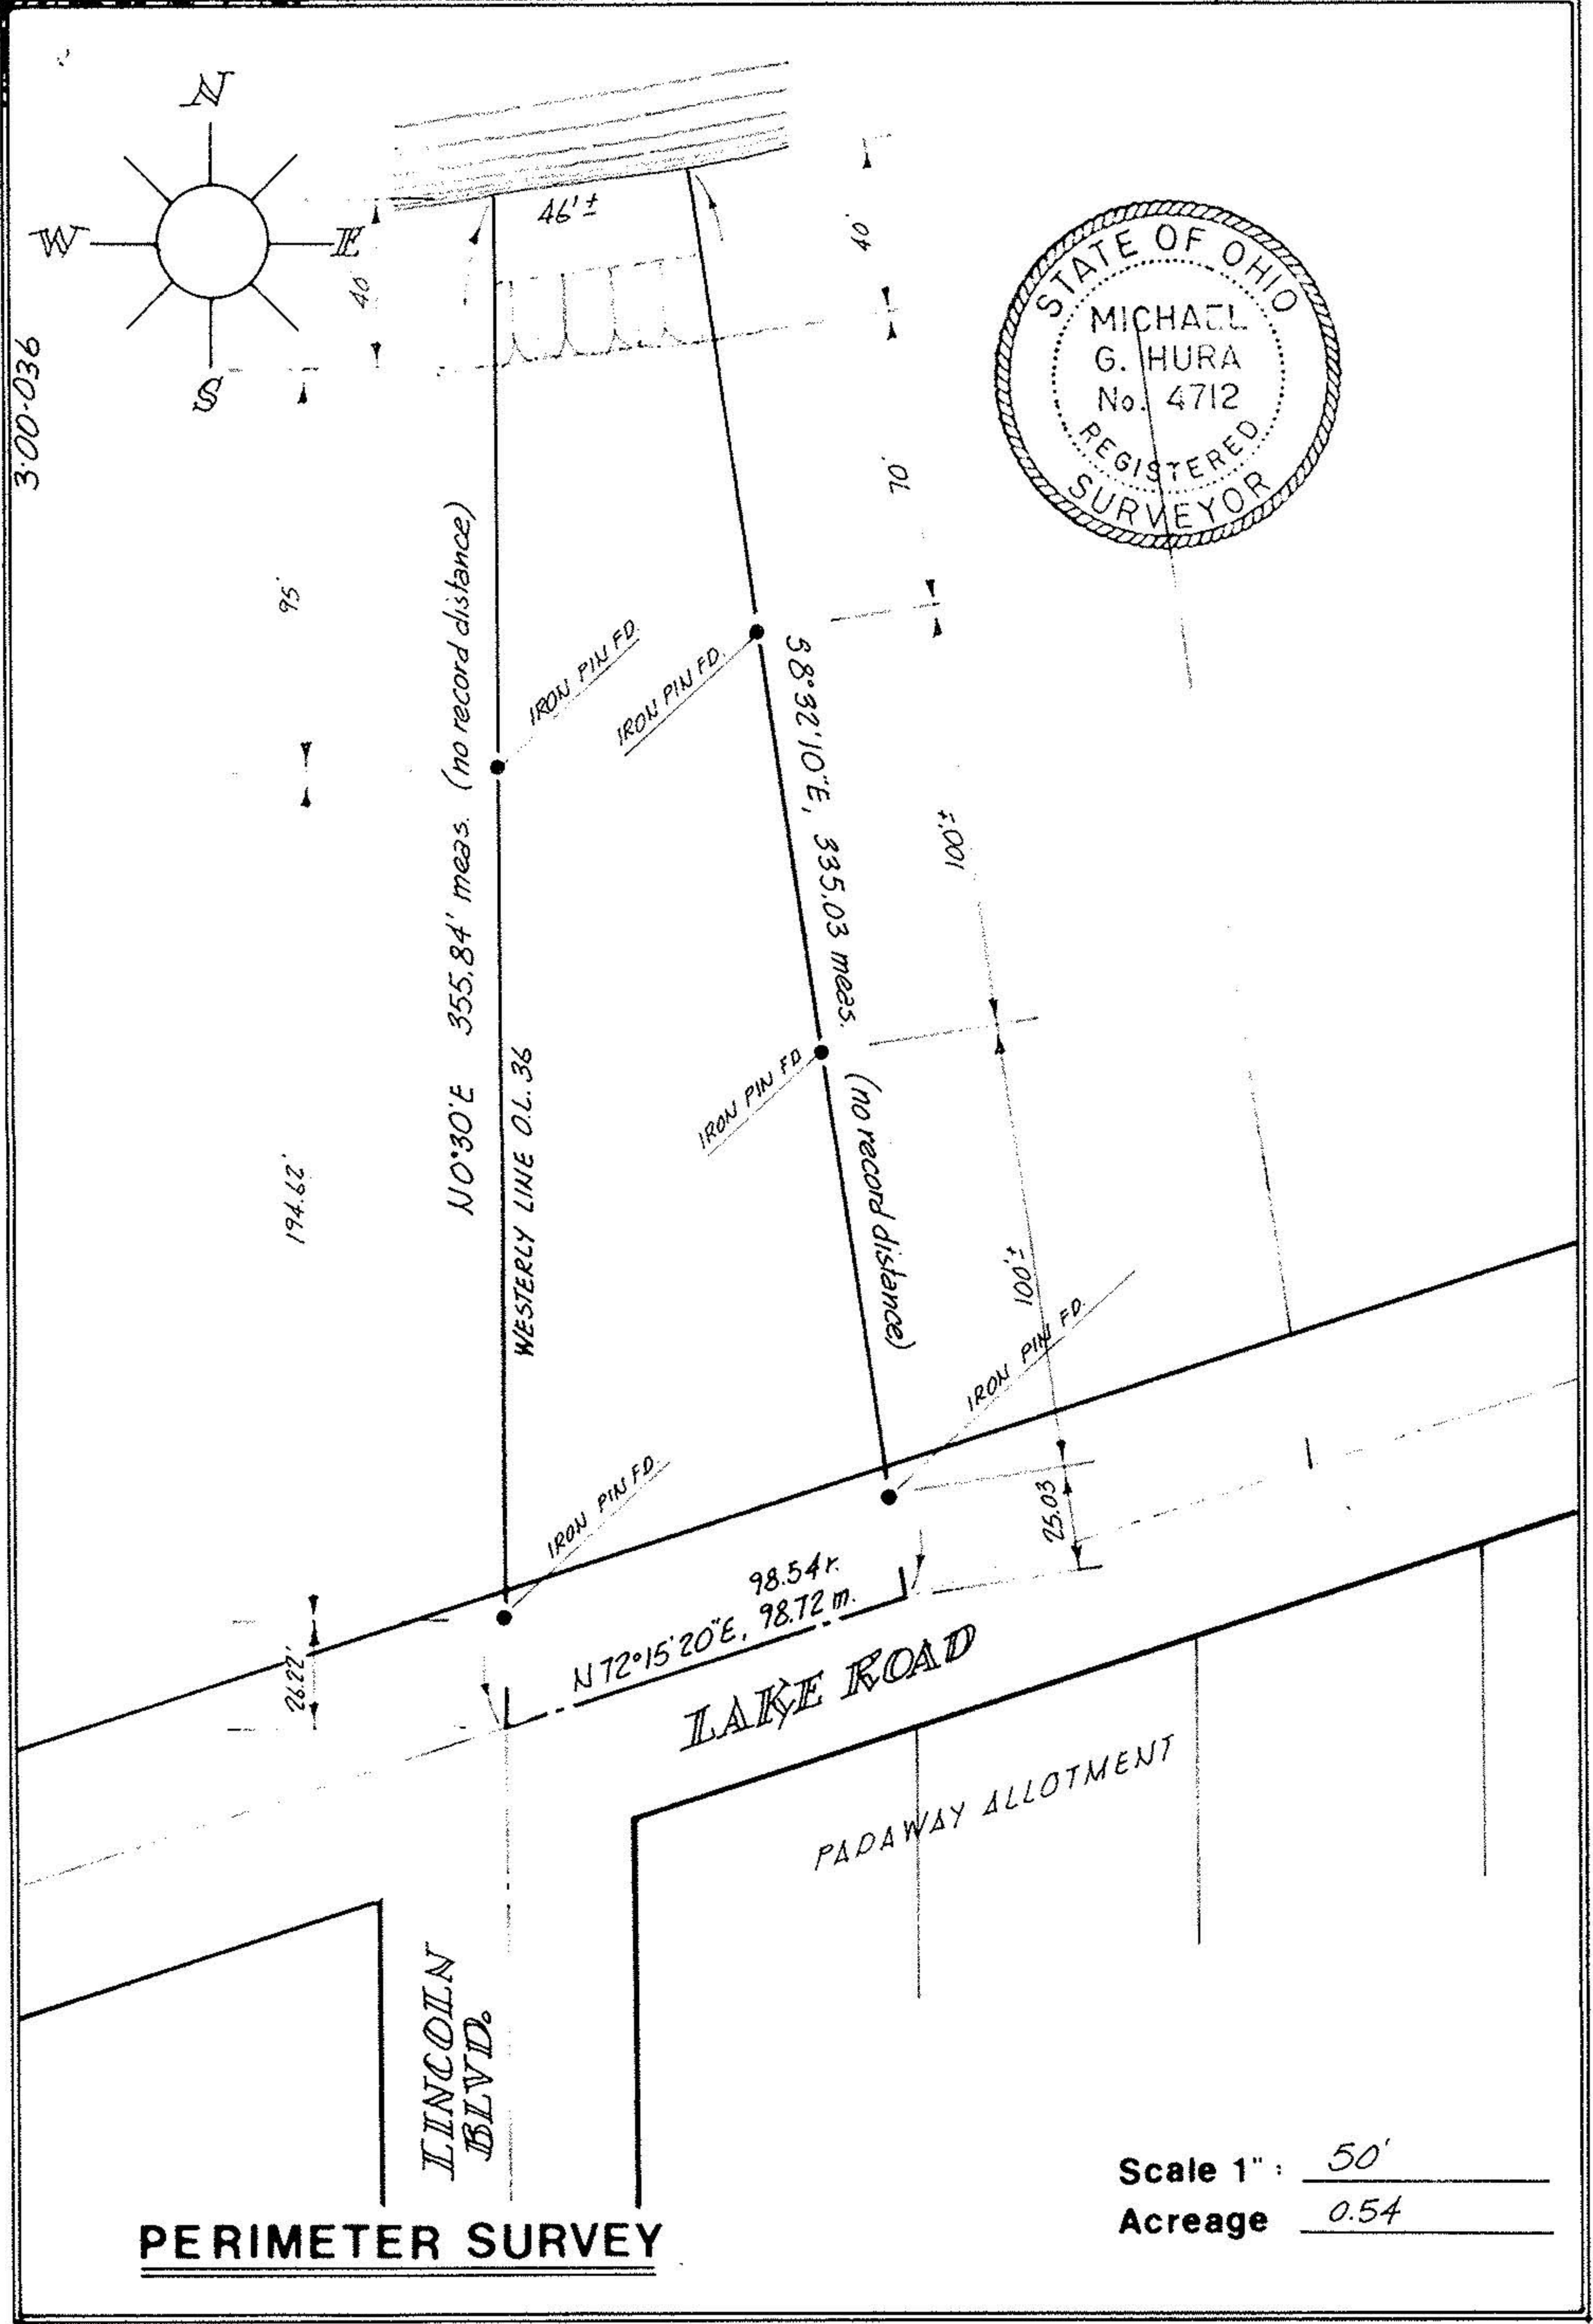

**PERIMETER SURVEY**

Scale 1" = 50'  
Acreage 0.54

SUBLOT \_\_\_\_\_ of \_\_\_\_\_  
 Plat Vol \_\_\_\_\_ Page \_\_\_\_\_  
 Part of O.L. 36 Section \_\_\_\_\_  
 Tract SHEFFIELD TWP \_\_\_\_\_  
 City of SHEFFIELD LAKE  
LORAIN Co., Ohio

**Michael G. Hura & Associates**  
 4560 Liberty Ave. Vermilion, Ohio  
 drawn MGH  
 date 06-05-80  
 scale 1" = 60  
 field book \_\_\_\_\_

PERMANENT  
 PARCEL NUMBER  
 03-00-036-101-001