


03-00-036-101-001

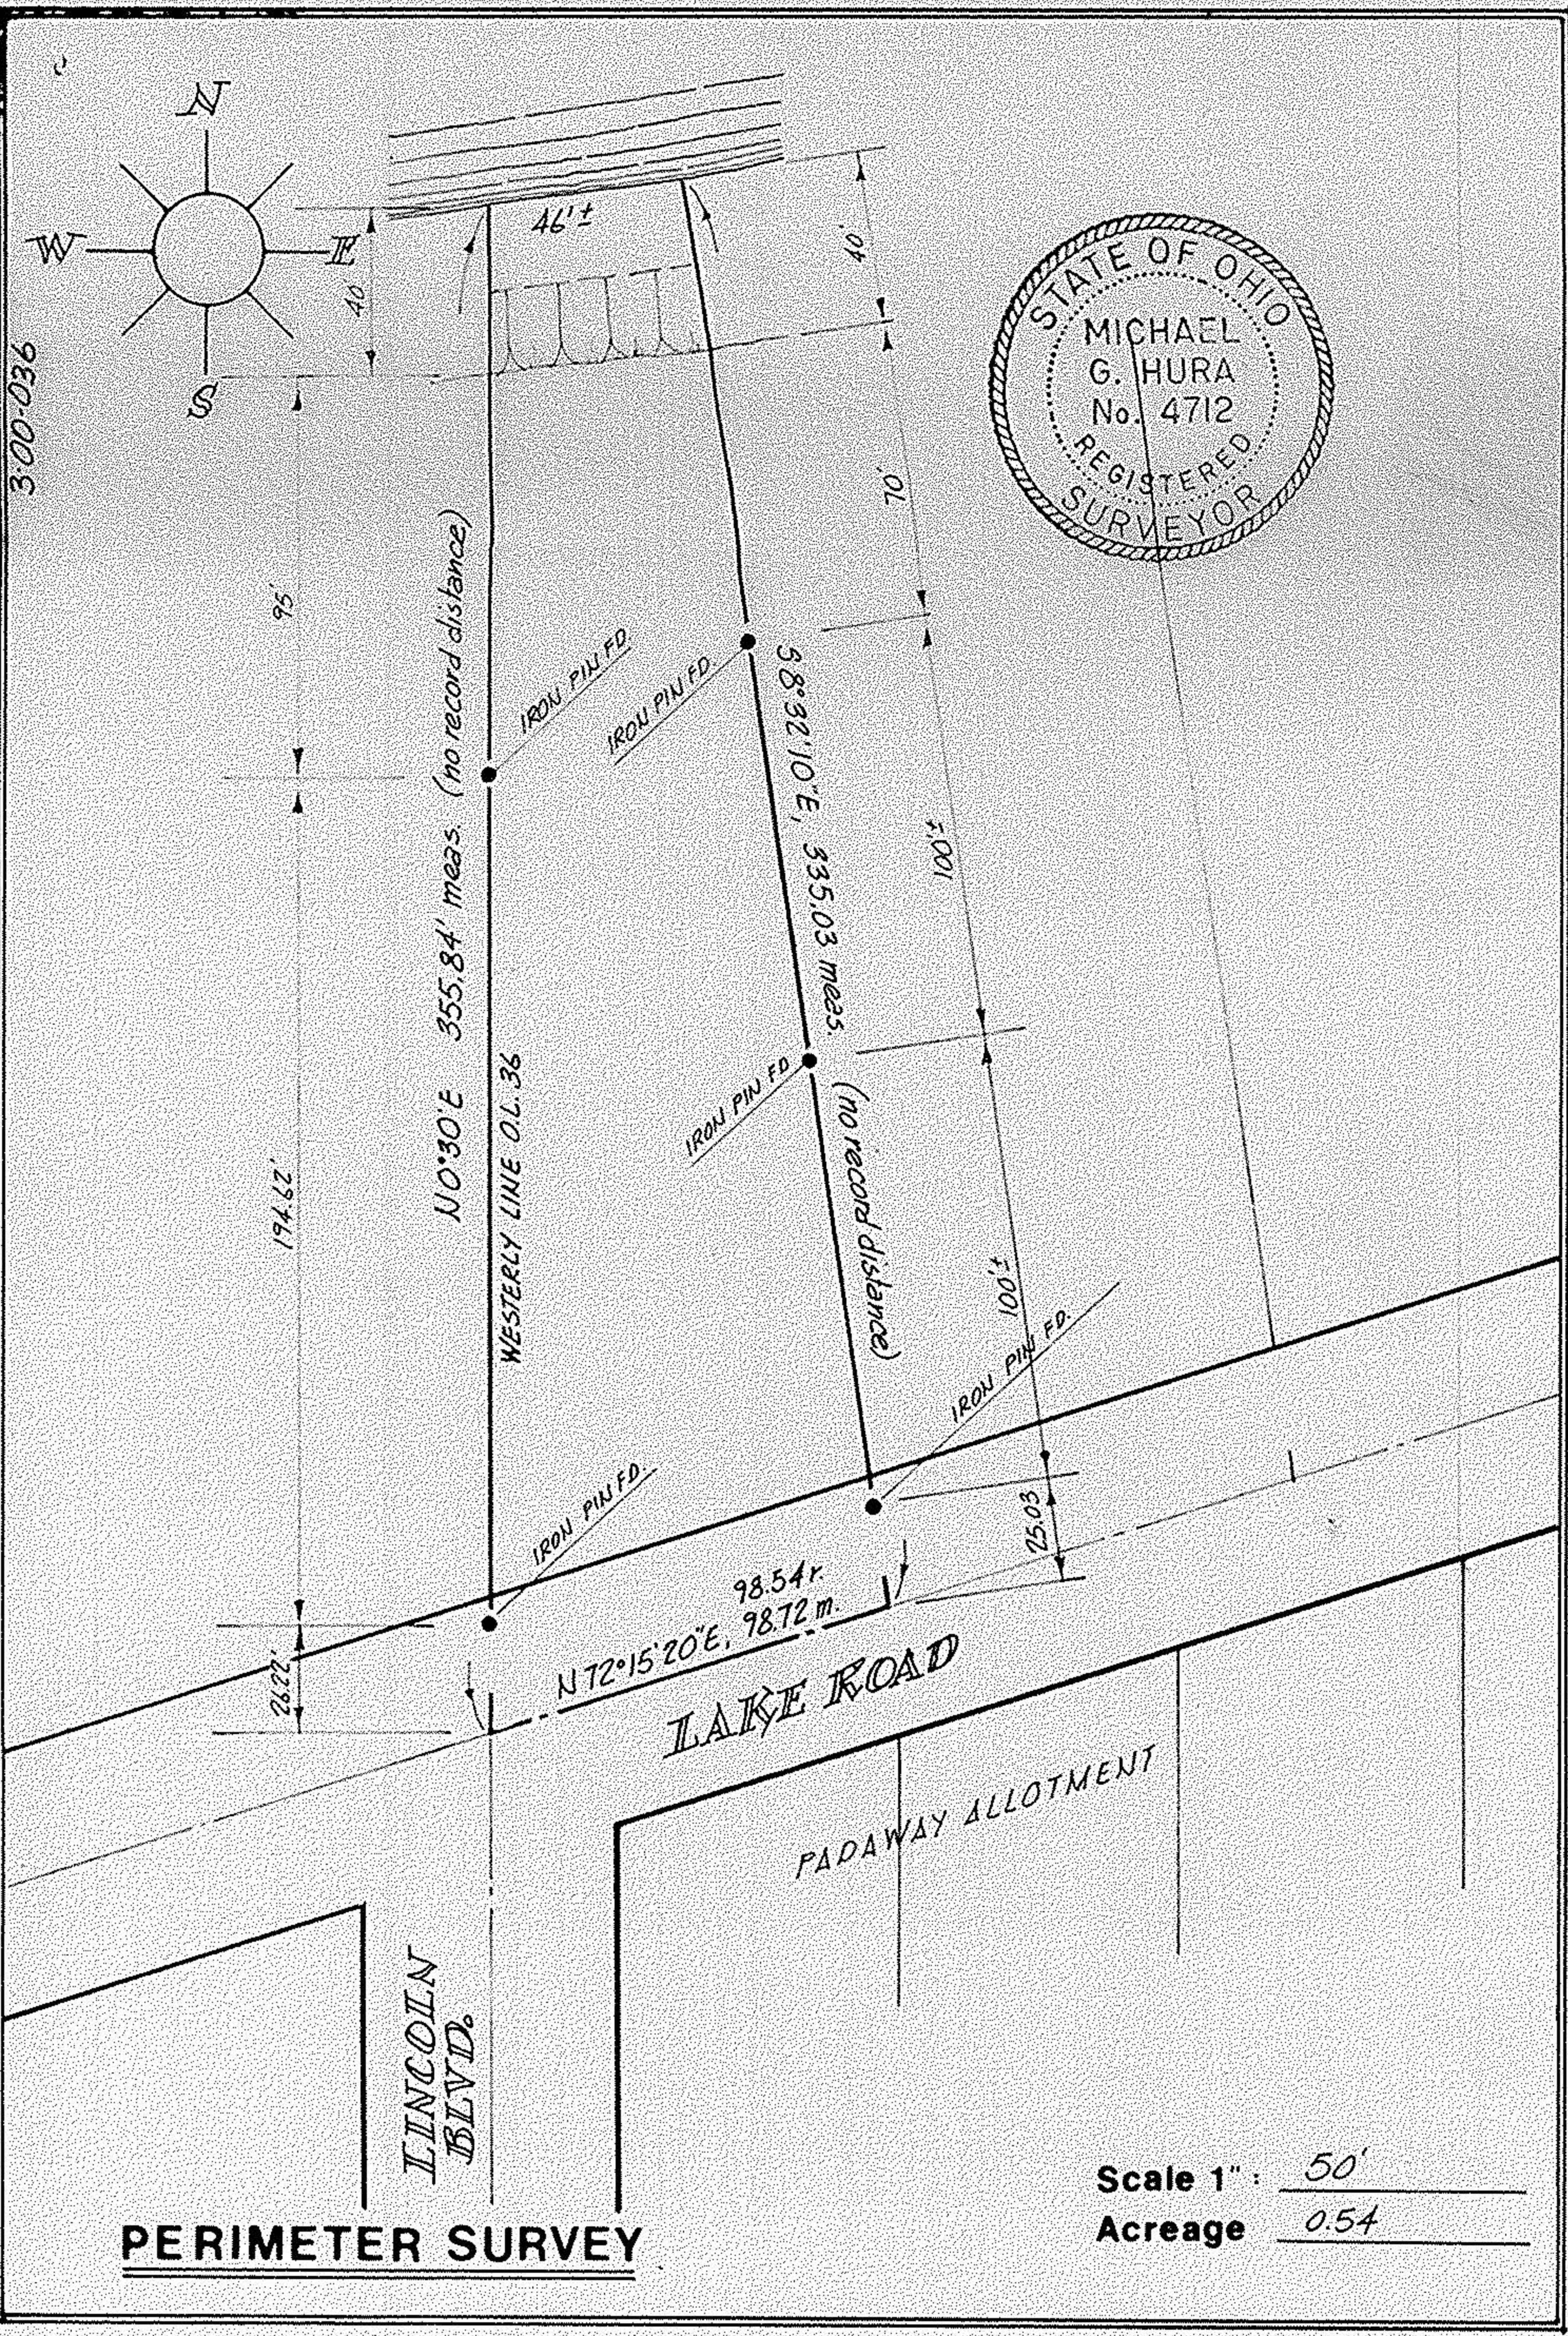

PERIMETER SURVEY

Scale 1" : 50'
Acreage 0.54

SUBLOT _____ of _____
 Plat Vol _____ Page _____
 Part of O.L. 36 Section _____
 Tract SHEFFIELD TWP _____
 City of SHEFFIELD LAKE
LORAIN Co., Ohio

Michael G. Hura & Associates
 4560 Liberty Ave. Vermilion, Ohio
 drawn MGH
 date 06-05-80
 scale 1" = 60
 field book

PERMANENT
 PARCEL NUMBER
 03-00-036-101-001