


PERMANENT
PARCEL NUMBER
05-00-003-103-022

Michael G. Hura & Associates
4560 Liberty Ave. Vermilion, Ohio


drawn p.a.r.
date 5-7-80
scale 1"=50'
field book

SUBLOT 61 of _____
CRESTVIEW ACRES SUB. NO. 3
Plat Vol 24 Page 42
Part of O.L. 3 Section _____ TWP
Tract AMHERST
City of AMHERST
LOZAIN Co., Ohio

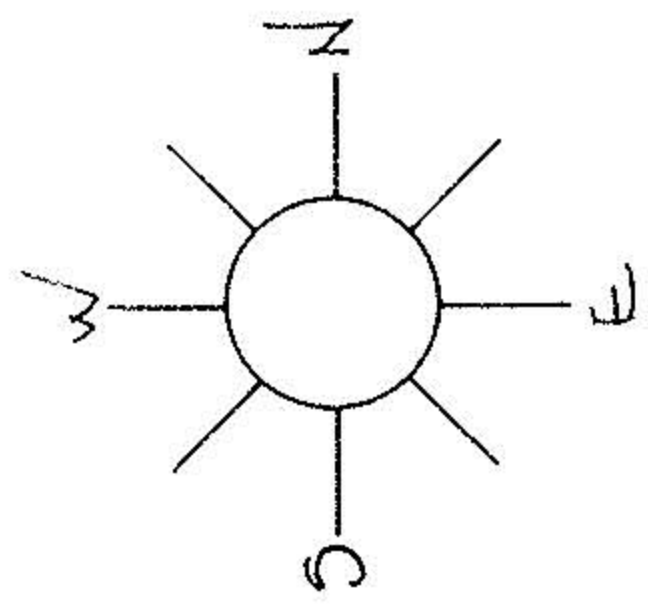

WEST MARTIN AVENUE 60'

PERIMETER SURVEY

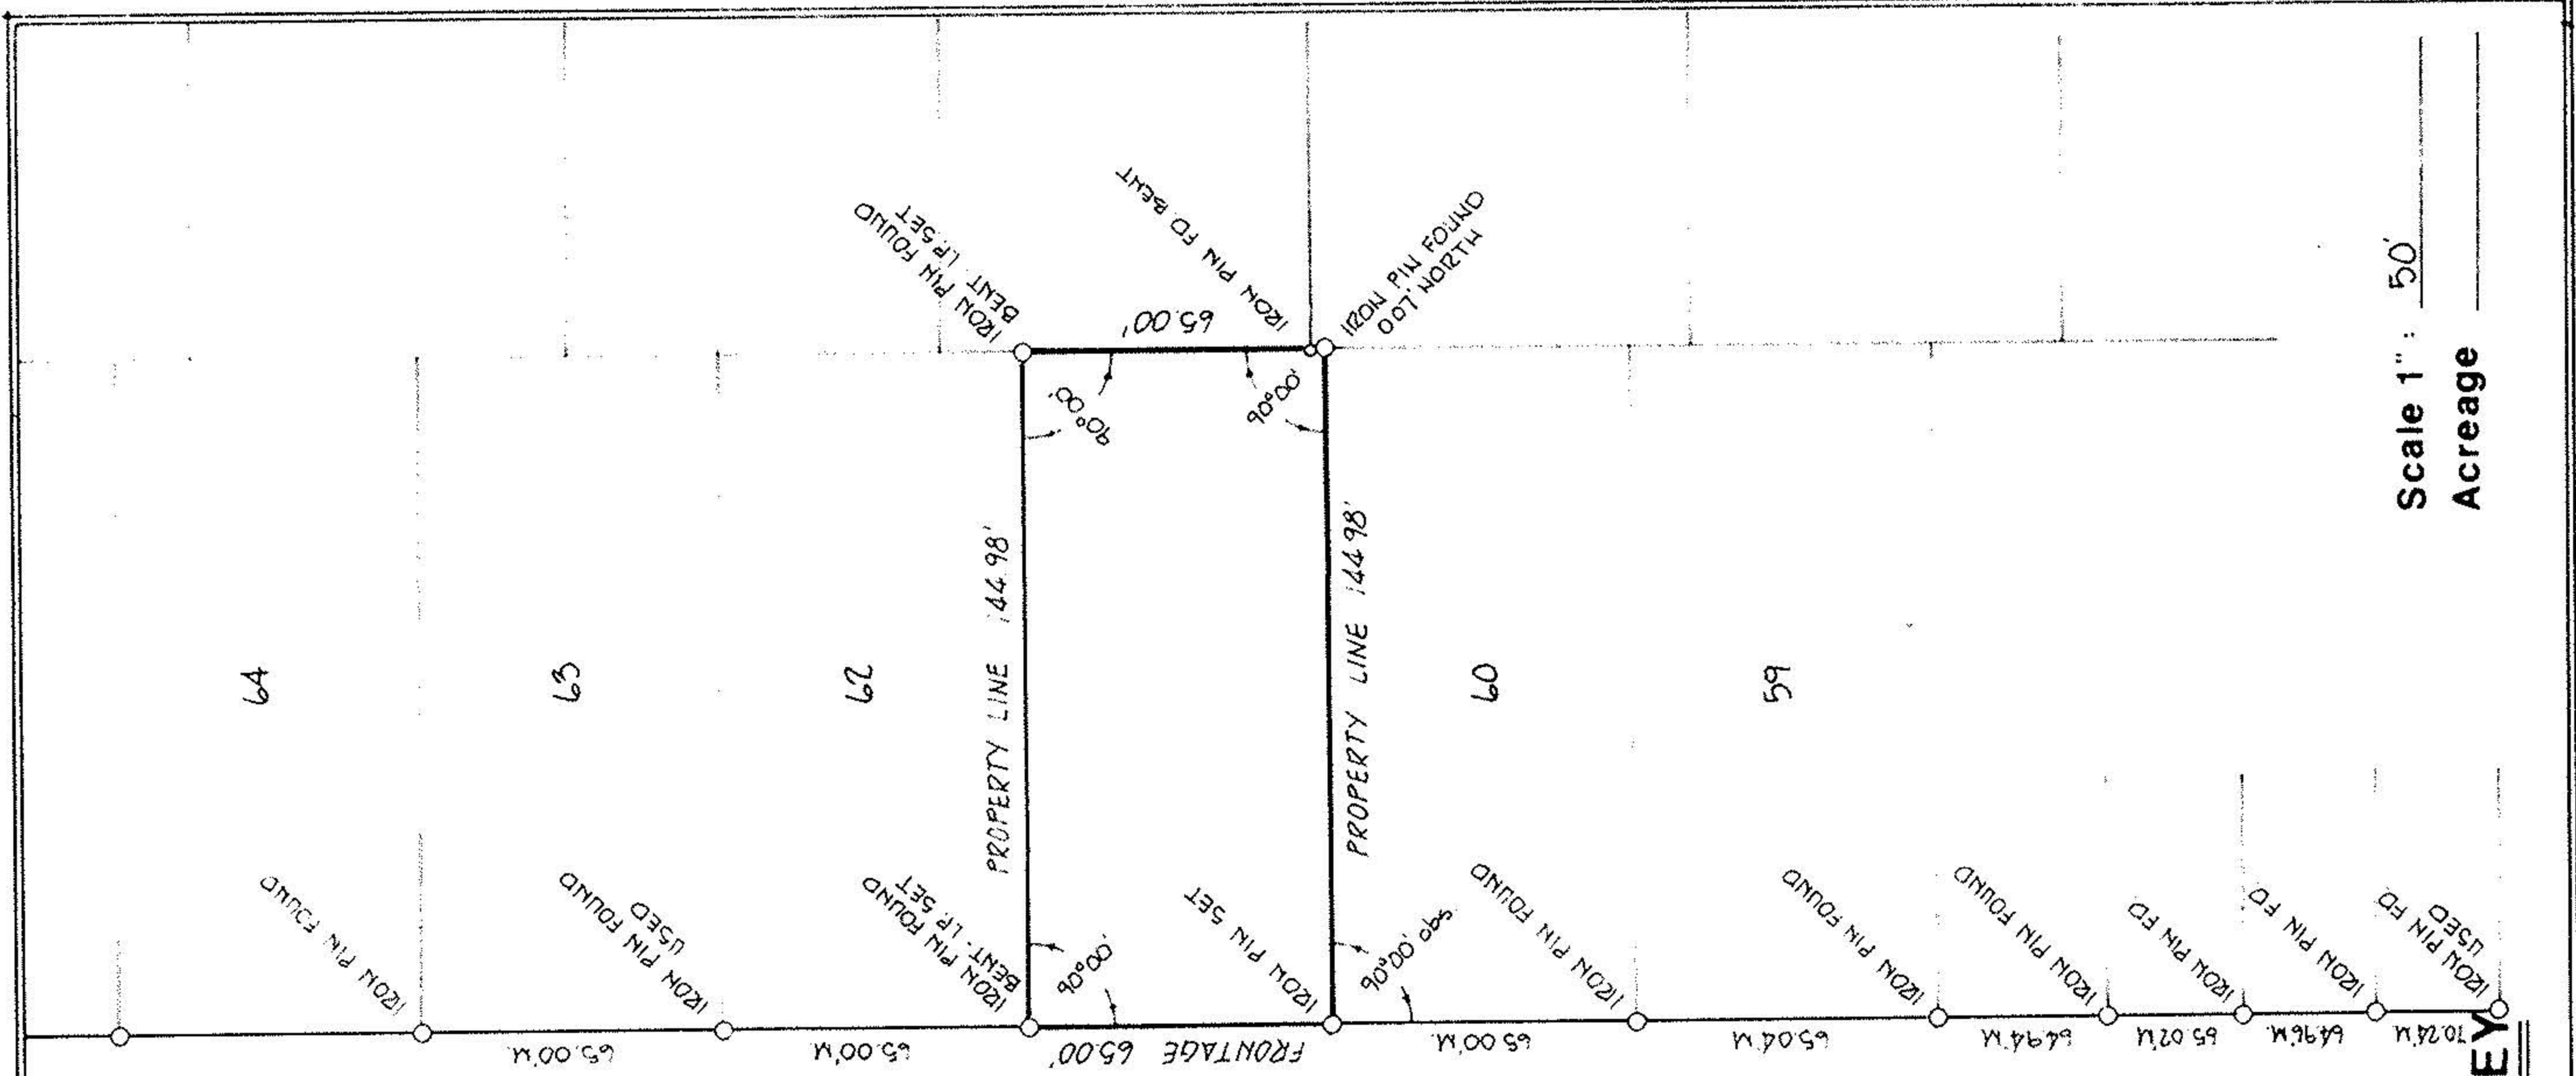

Scale 1" = 50'
Acreage _____