
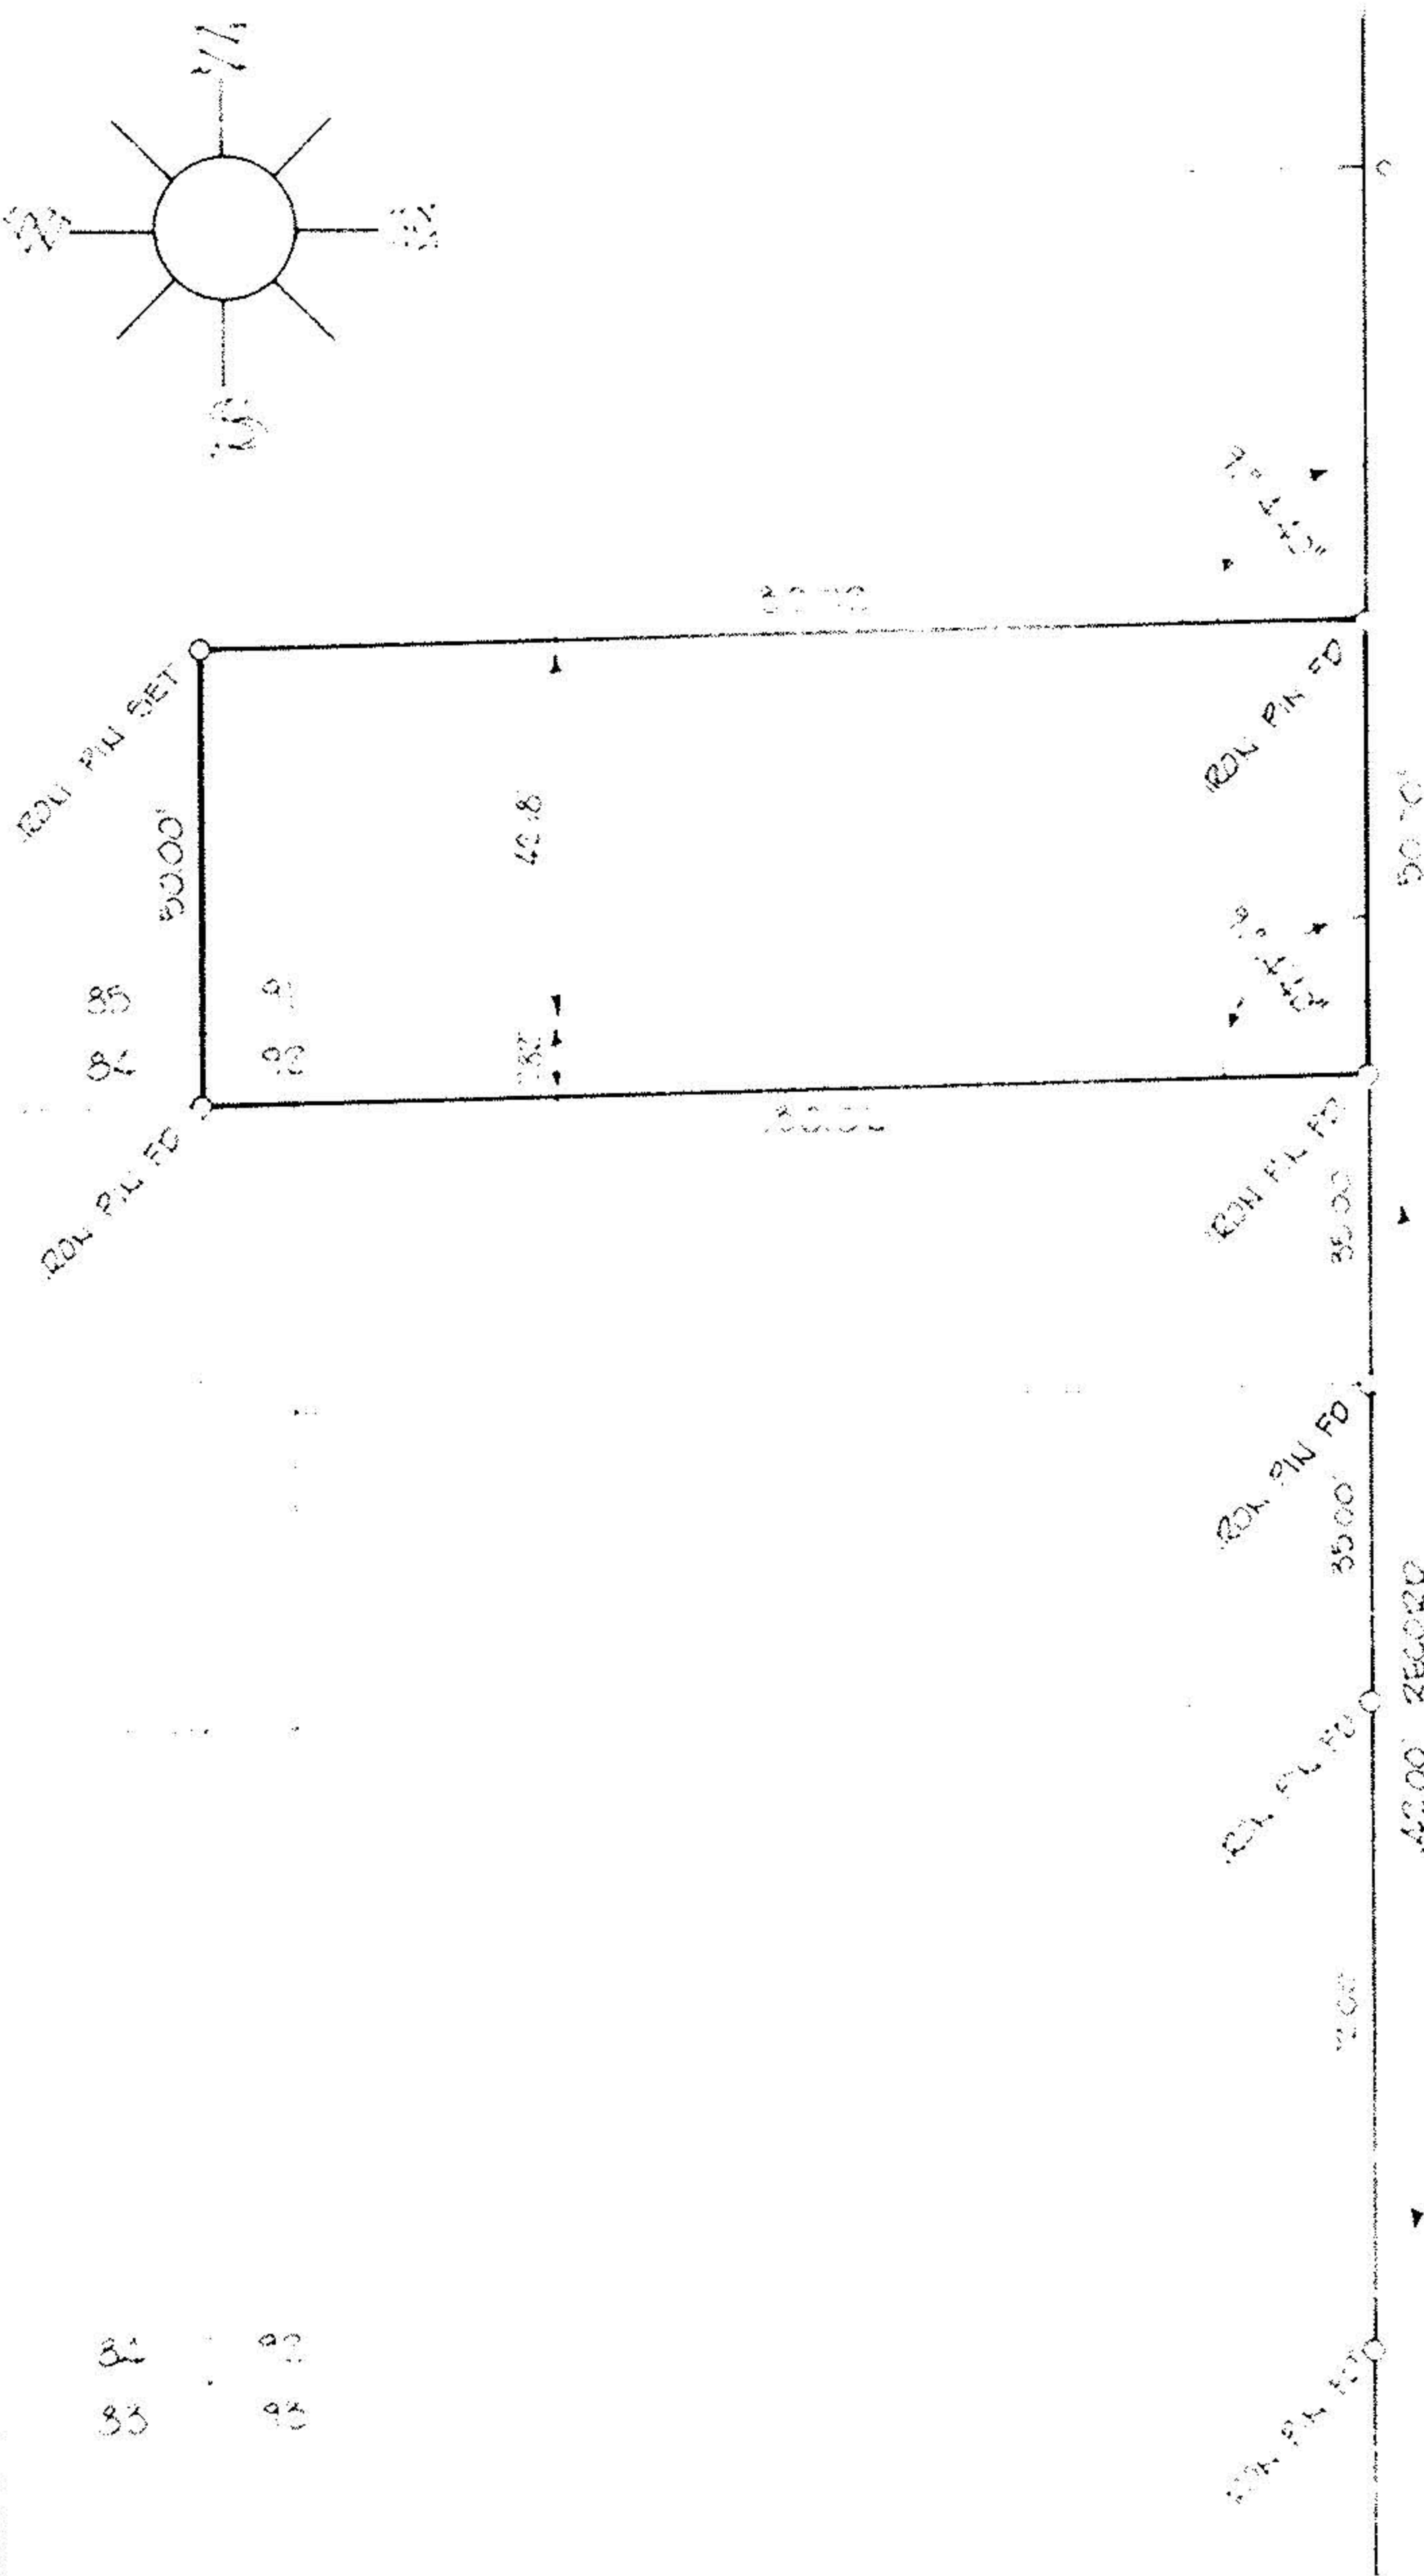


05-00-023-118-026
5-00-023-B

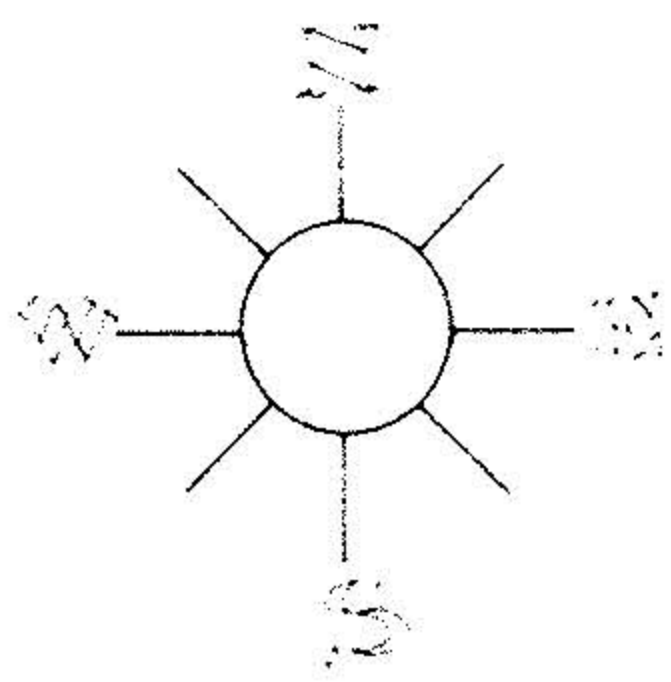

FORBUSH STREET

81 92
83 93

Scale 1" = 30'
Acreage _____

PERIMETER SURVEY

2 AND 5111132

SUBLOT _____ of _____
 PART OF LOT 92 - OUSTINE ADDITION
 Plat Vol _____ Page 5
 Part of O.L. 23 Section _____
 Tract _____ AMHERST TWP
 City of _____ AMHERST
 _____ LOZAN Co., Ohio

Michael G. Hura & Associates
 4560 Liberty Ave. Vermilion, Ohio
 drawn par _____
 date 5-27-80
 scale 1"=30'
 field book _____

PERMANENT
 PARCEL NUMBER
 05 00 023 18 026