
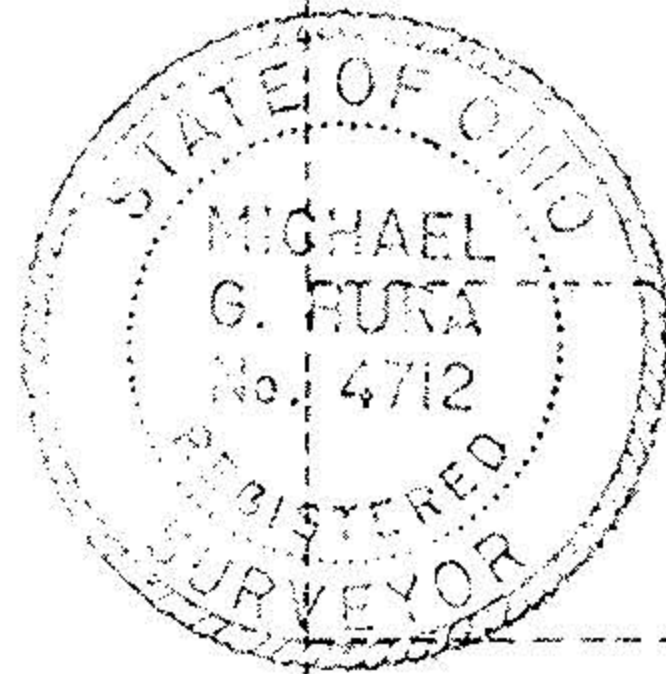
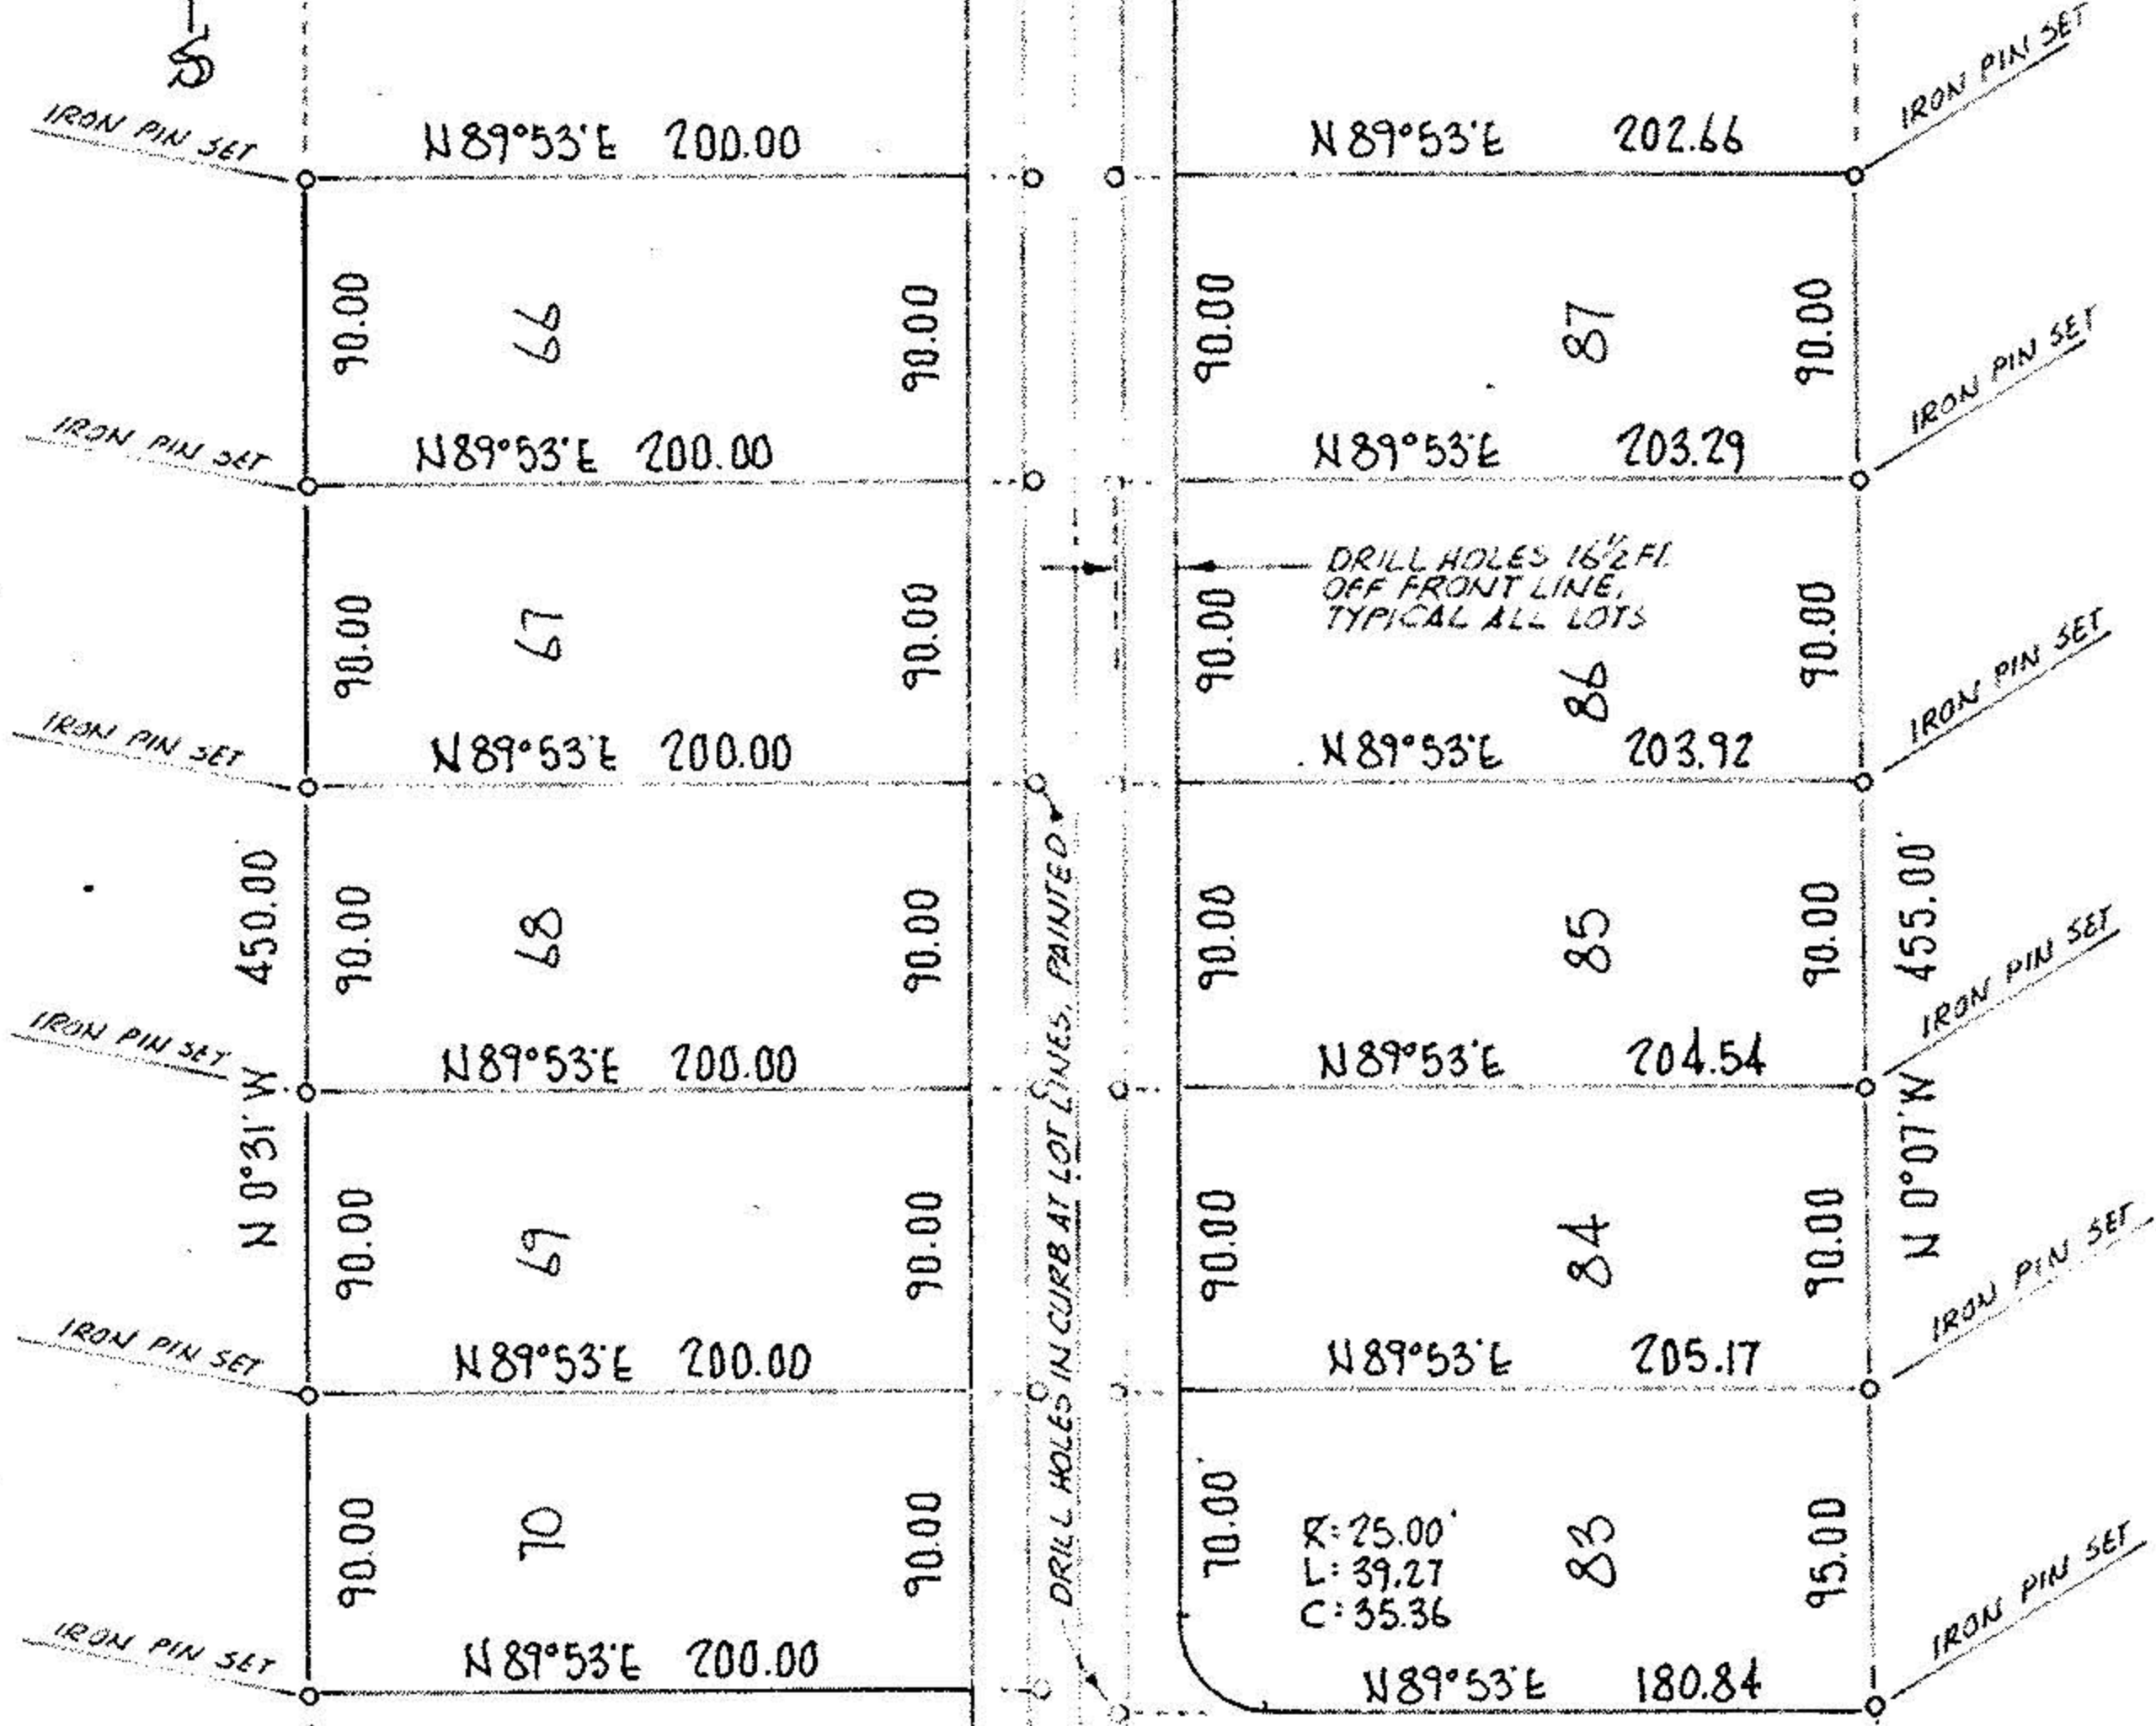


05-00-035-102  
 05-00-035-103  
 5-00-035-A

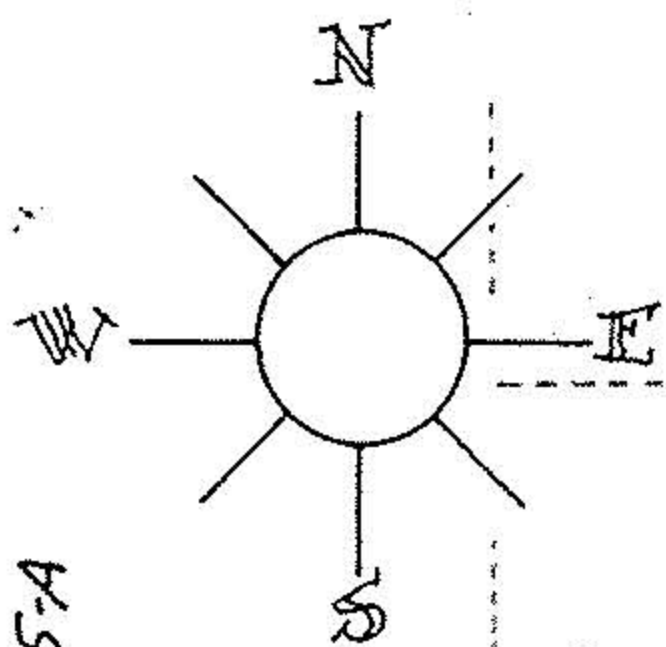

ROYAL DRIVE 60'

WELK LANE

MONUMENT USED

Scale 1" = 100'  
 Acreage \_\_\_\_\_

**PERIMETER SURVEY**

SUBLOT <sup>AS</sup> SHOWN of REVISION TO  
 SLIMAN'S MIDDLE RIDGE ALLOT #3  
 Plat Vol 34 Page 5  
 Part of O.L. 35 Section \_\_\_\_\_  
 Tract AMHERST TWP \_\_\_\_\_  
 City of AMHERST  
LORAIN Co., Ohio

**Michael G. Hura & Associates**  
 4560 Liberty Ave. Vermilion, Ohio  
 drawn MGH  
 date 8-21-79  
 scale 1"=100  
 field book \_\_\_\_\_

PERMANENT  
 PARCEL NUMBER