


ACKERMAN ROAD

DENEY ROAD

EAST LINE OF O.L. 43

N.Y.C. RR (600)

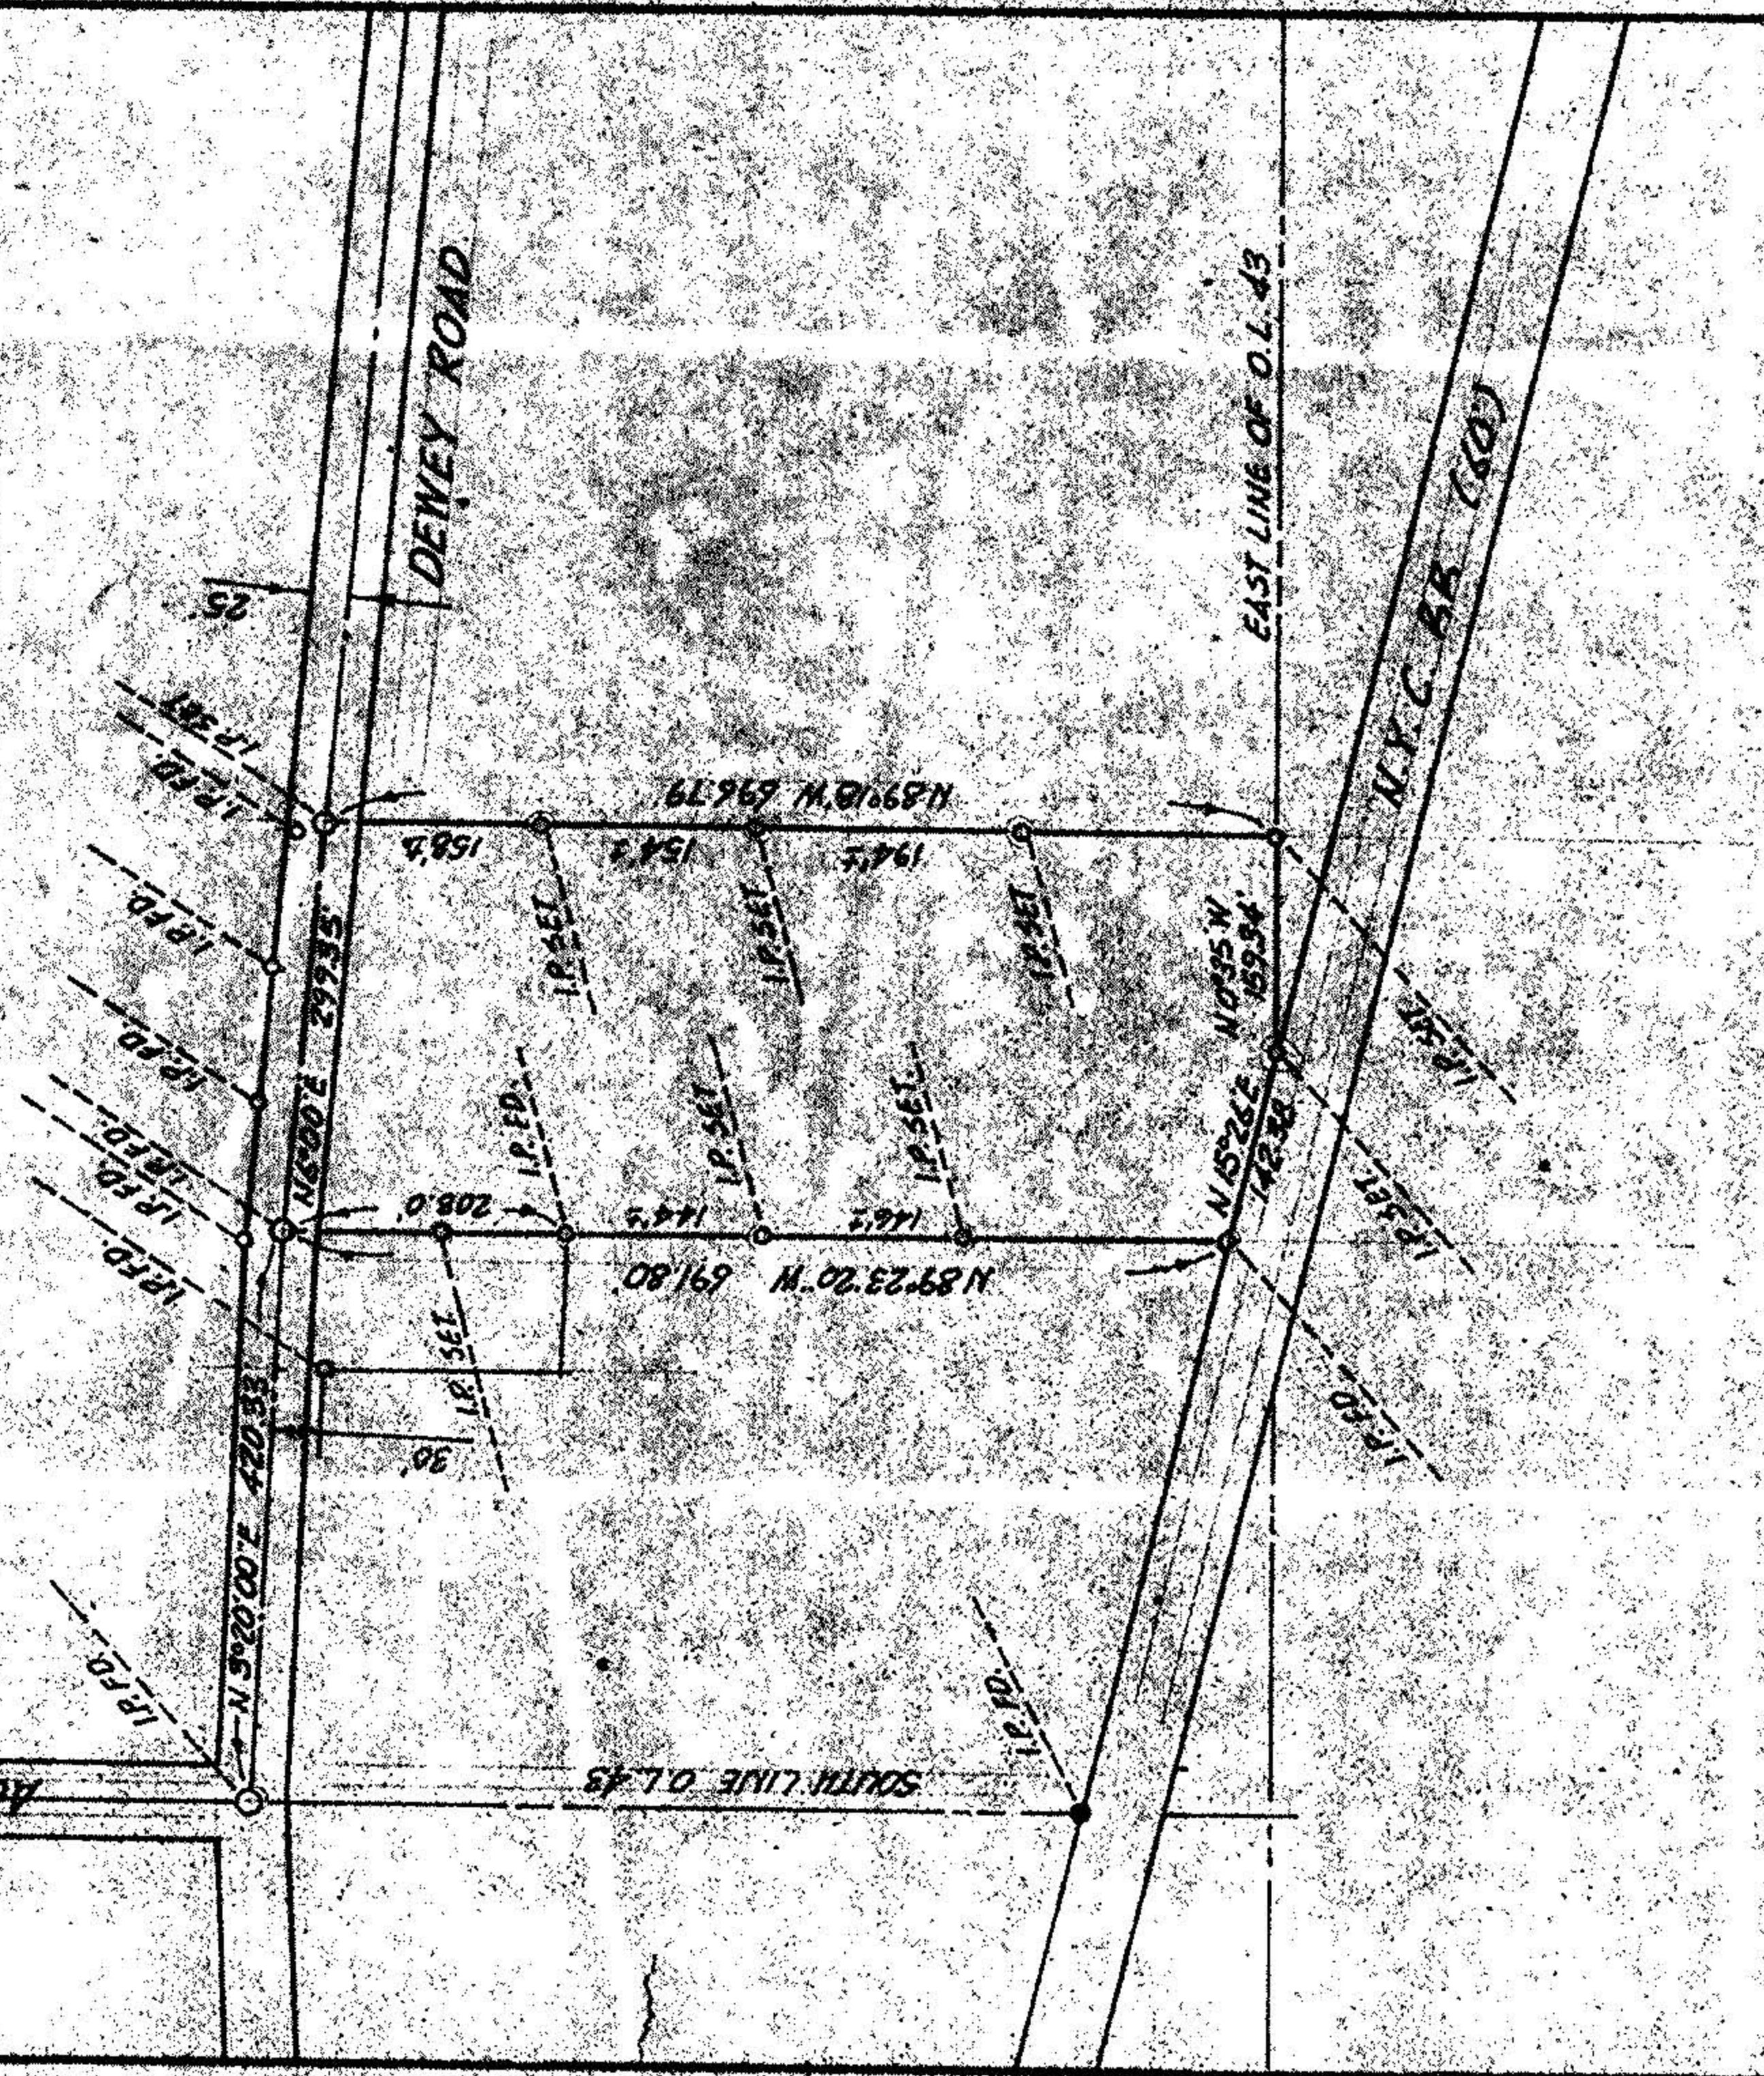

acreage 4.814

DWG No

PERIMETER SURVEY

Sublot \_\_\_ of \_\_\_ Vol. \_\_\_ Page \_\_\_  
 Part of O.L. 43 Sect. \_\_\_ Tr. \_\_\_  
 City of \_\_\_  
 AMHERST Twp. LORAIN Co.

MICHAEL G. HURA  
 REGISTERED SURVEYOR  
 199 PARK AVENUE  
 AMHERST, OHIO 44001

drawn MGH

date 2-15-74

scale 1" = 200'