
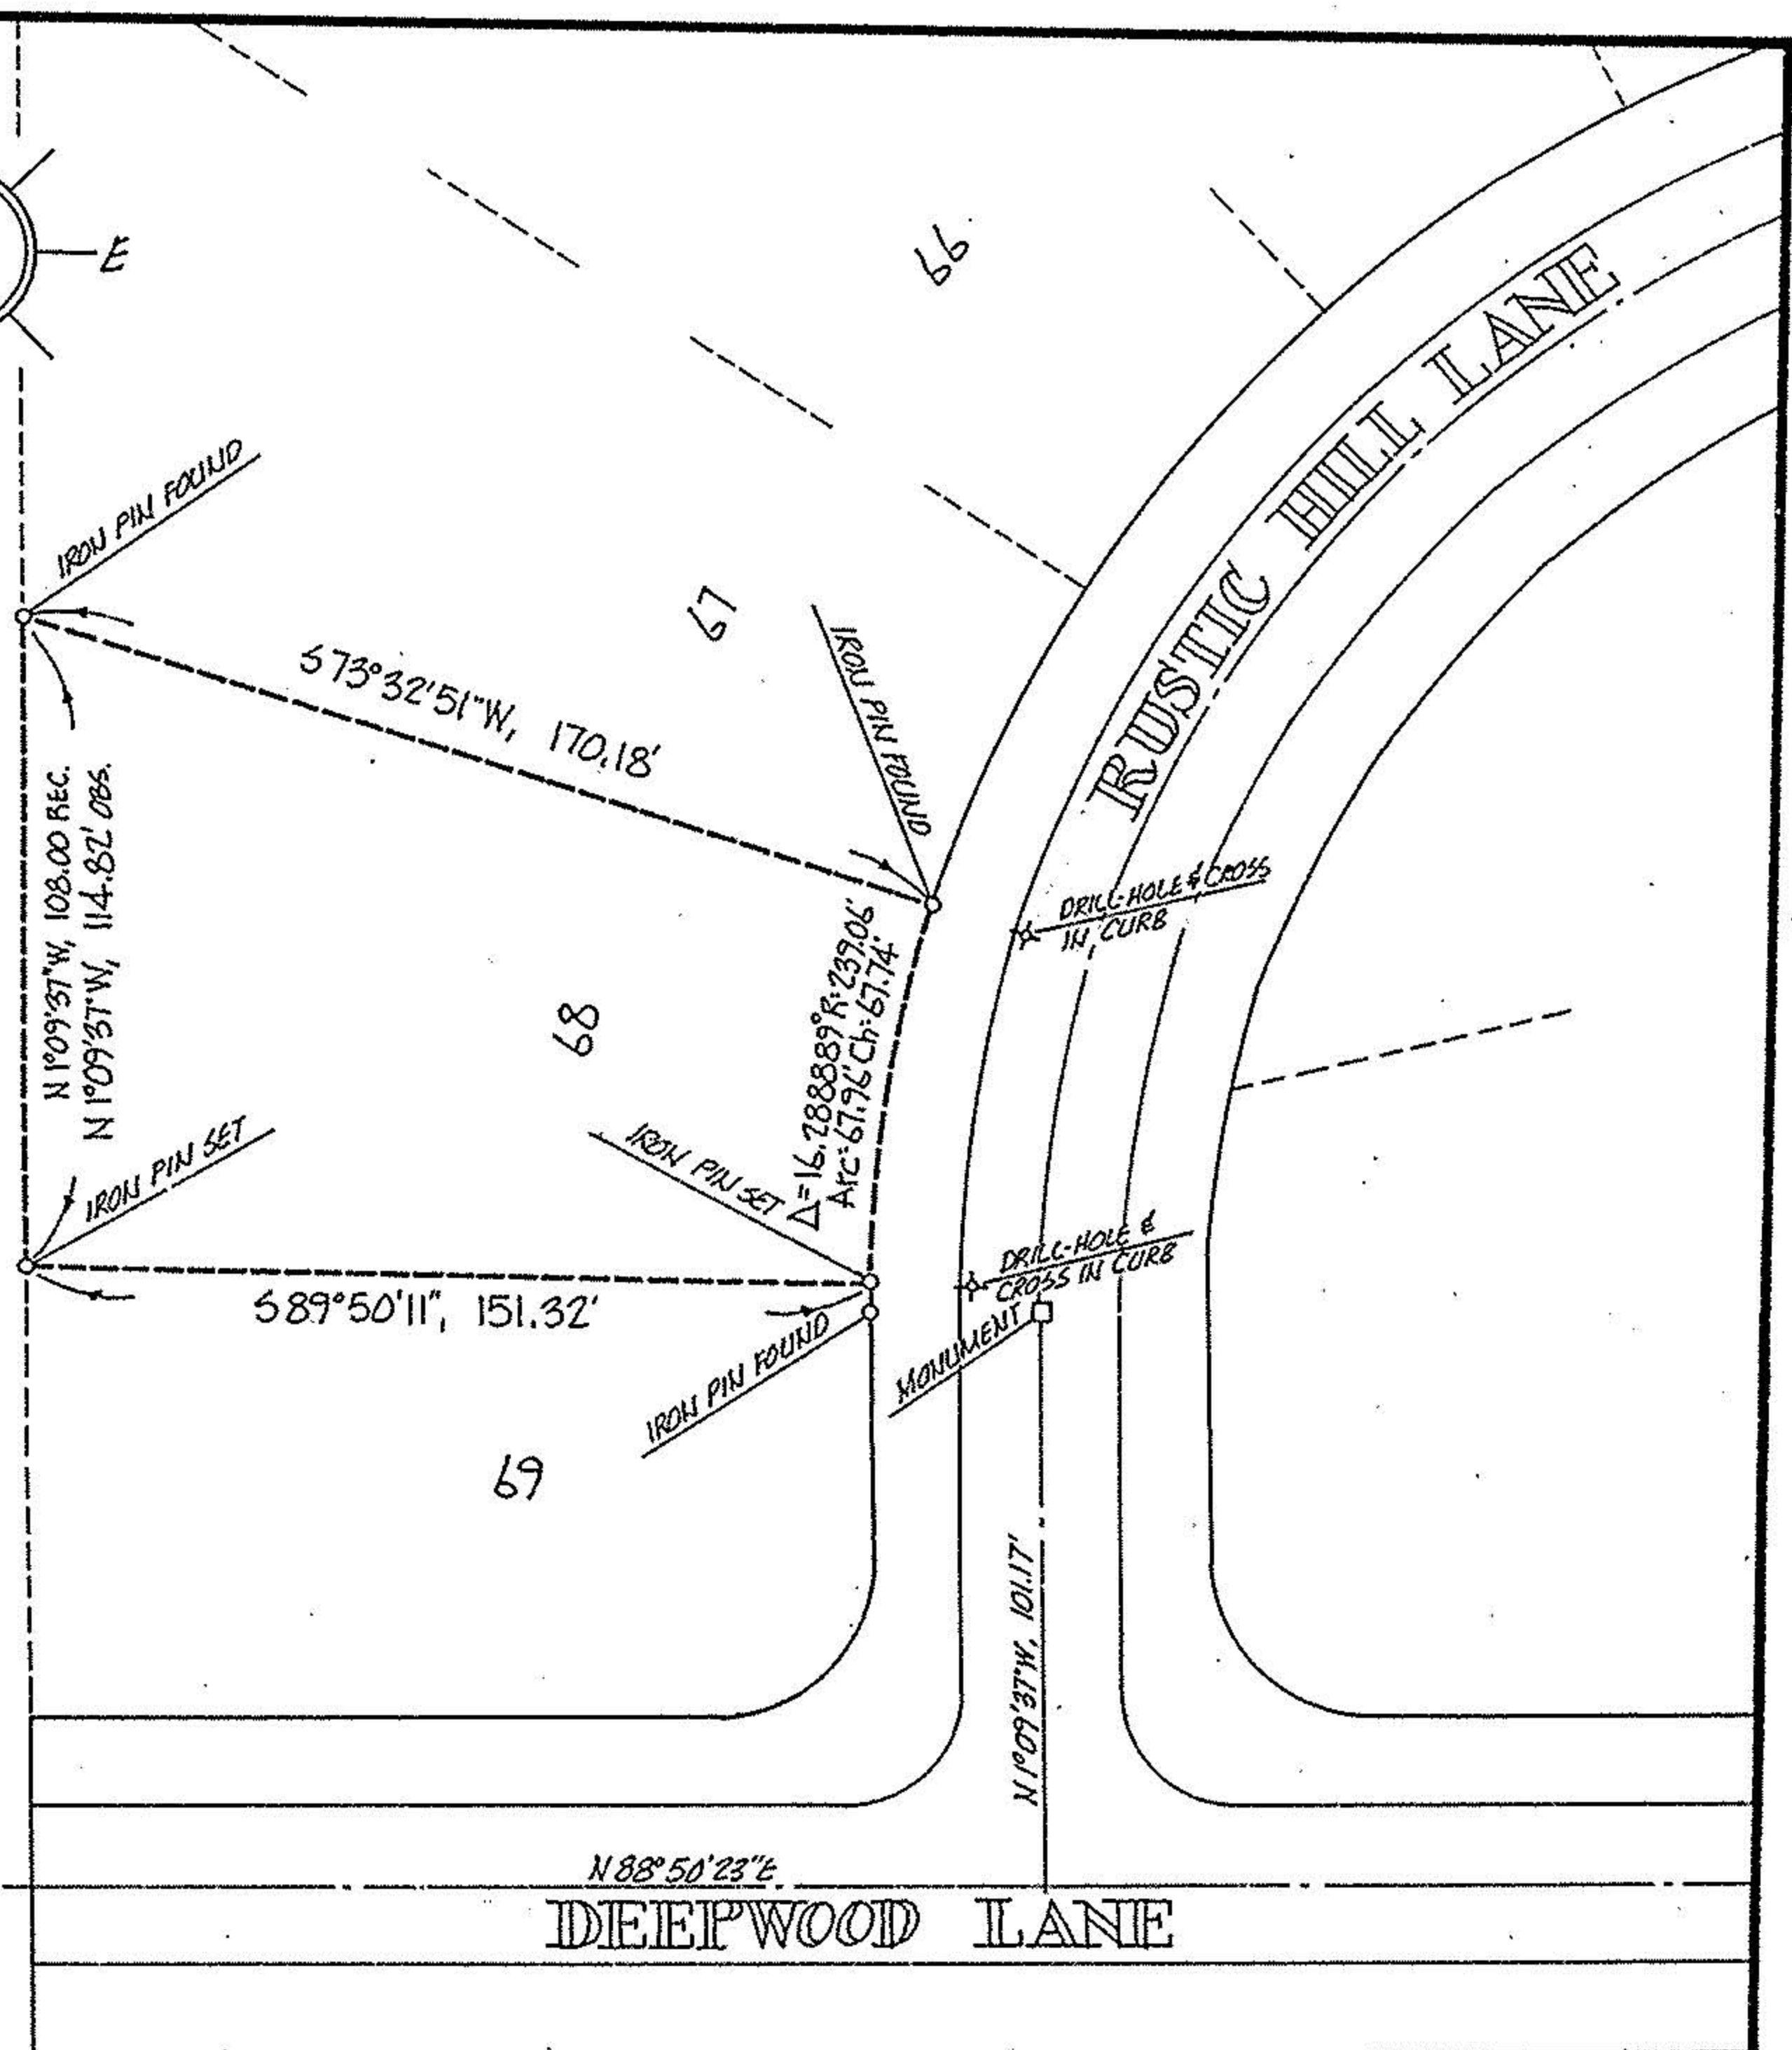


05-00-058-000-015
05-00-058-B

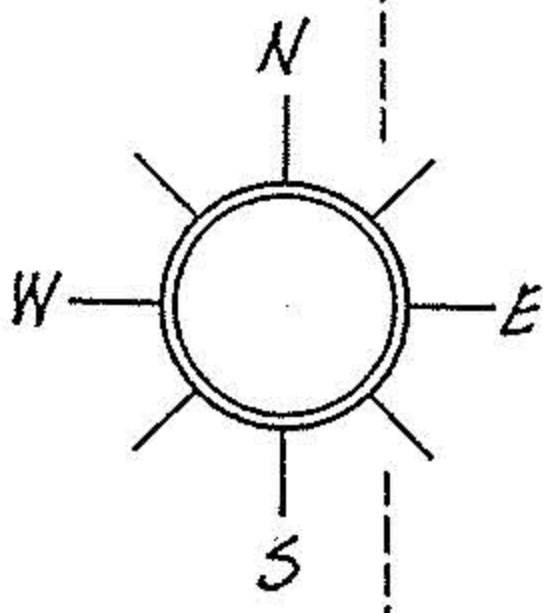

ACREAGE	PREPARED FOR <u>MR. & MRS LEROY REYNOLDS</u>	CITY OF
DATE <u>06-25-86</u>	<u>242 RUSTIC HILL LN., LORAIN</u>	
DRAWN <u>MGH</u>	MICHAEL G. HURA, registered surveyor. 12706 MASON RD., VERMILION, O., Ph(216) 965 4040	
SCALE <u>1" = 50 ft.</u>	PERIMETER SURVEY	
	SUBLOT(s) <u>68</u> of <u>HIDDEN VALLEY SUBDN No 1</u>	
	Volume <u>31</u> Page <u>34</u> of PLATS	
	PART OF O.L. <u>59</u> TRACT _____ SECTION _____ OF <u>AMHERST</u> TOWNSHIP <u>LORAIN</u> CO., OHIO	
	PERMANENT PARCEL No _____	