


5-00-079-A

05-00-018-000
05-00-079-000

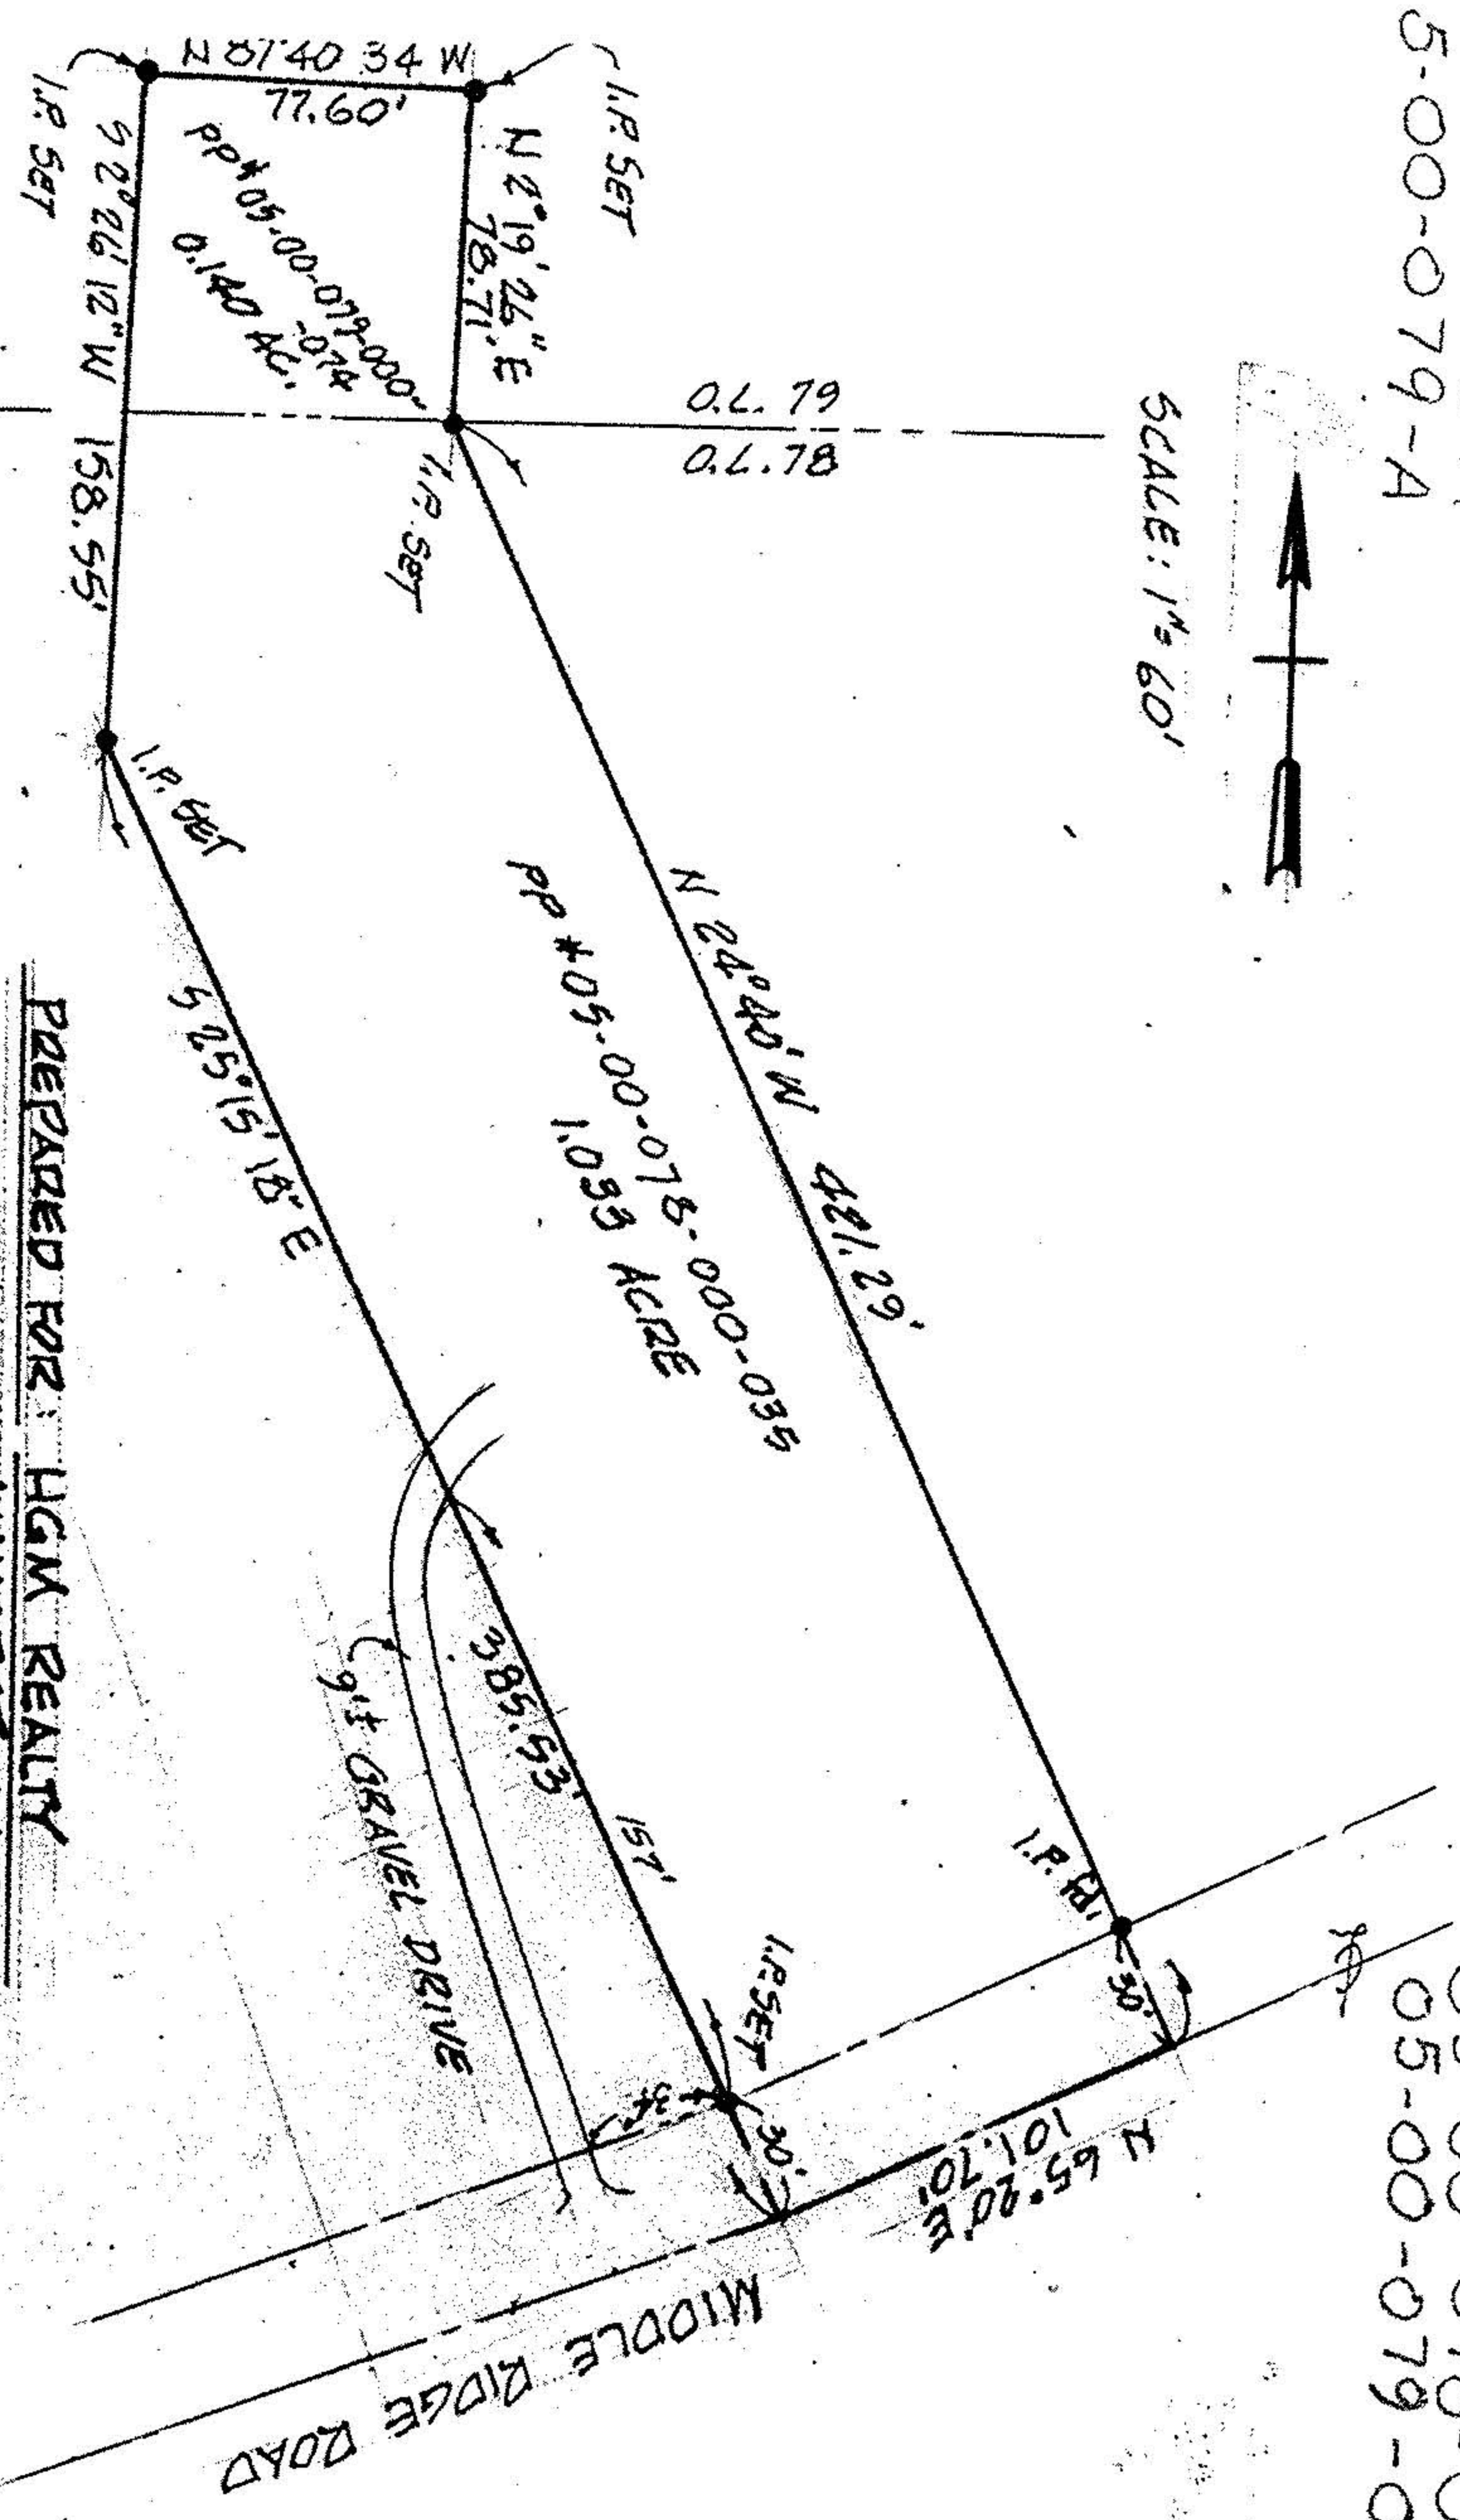

SCALE: 1" = 60'



PREPARED FOR: HGM REALTY
AKHERST, OHIO

NOTE: IRON PINS SET IN ACCORDANCE
WITH DEED DESCRIPTION PER
VOLUME 1379, PAGE 917

THIS IS A PLAT OF SURVEY:

James M. [Signature]
REGISTERED SURVEYOR #4219

PART OF ORIG. AKHERST TWP. LOTS 78 & 79
TOWNSHIP of AKHERST, LOZAN Co, OHIO

K. E. MCCARTNEY & ASSOCIATES

APRIL 11, 1986

#82169