6-24-035-106

6-61

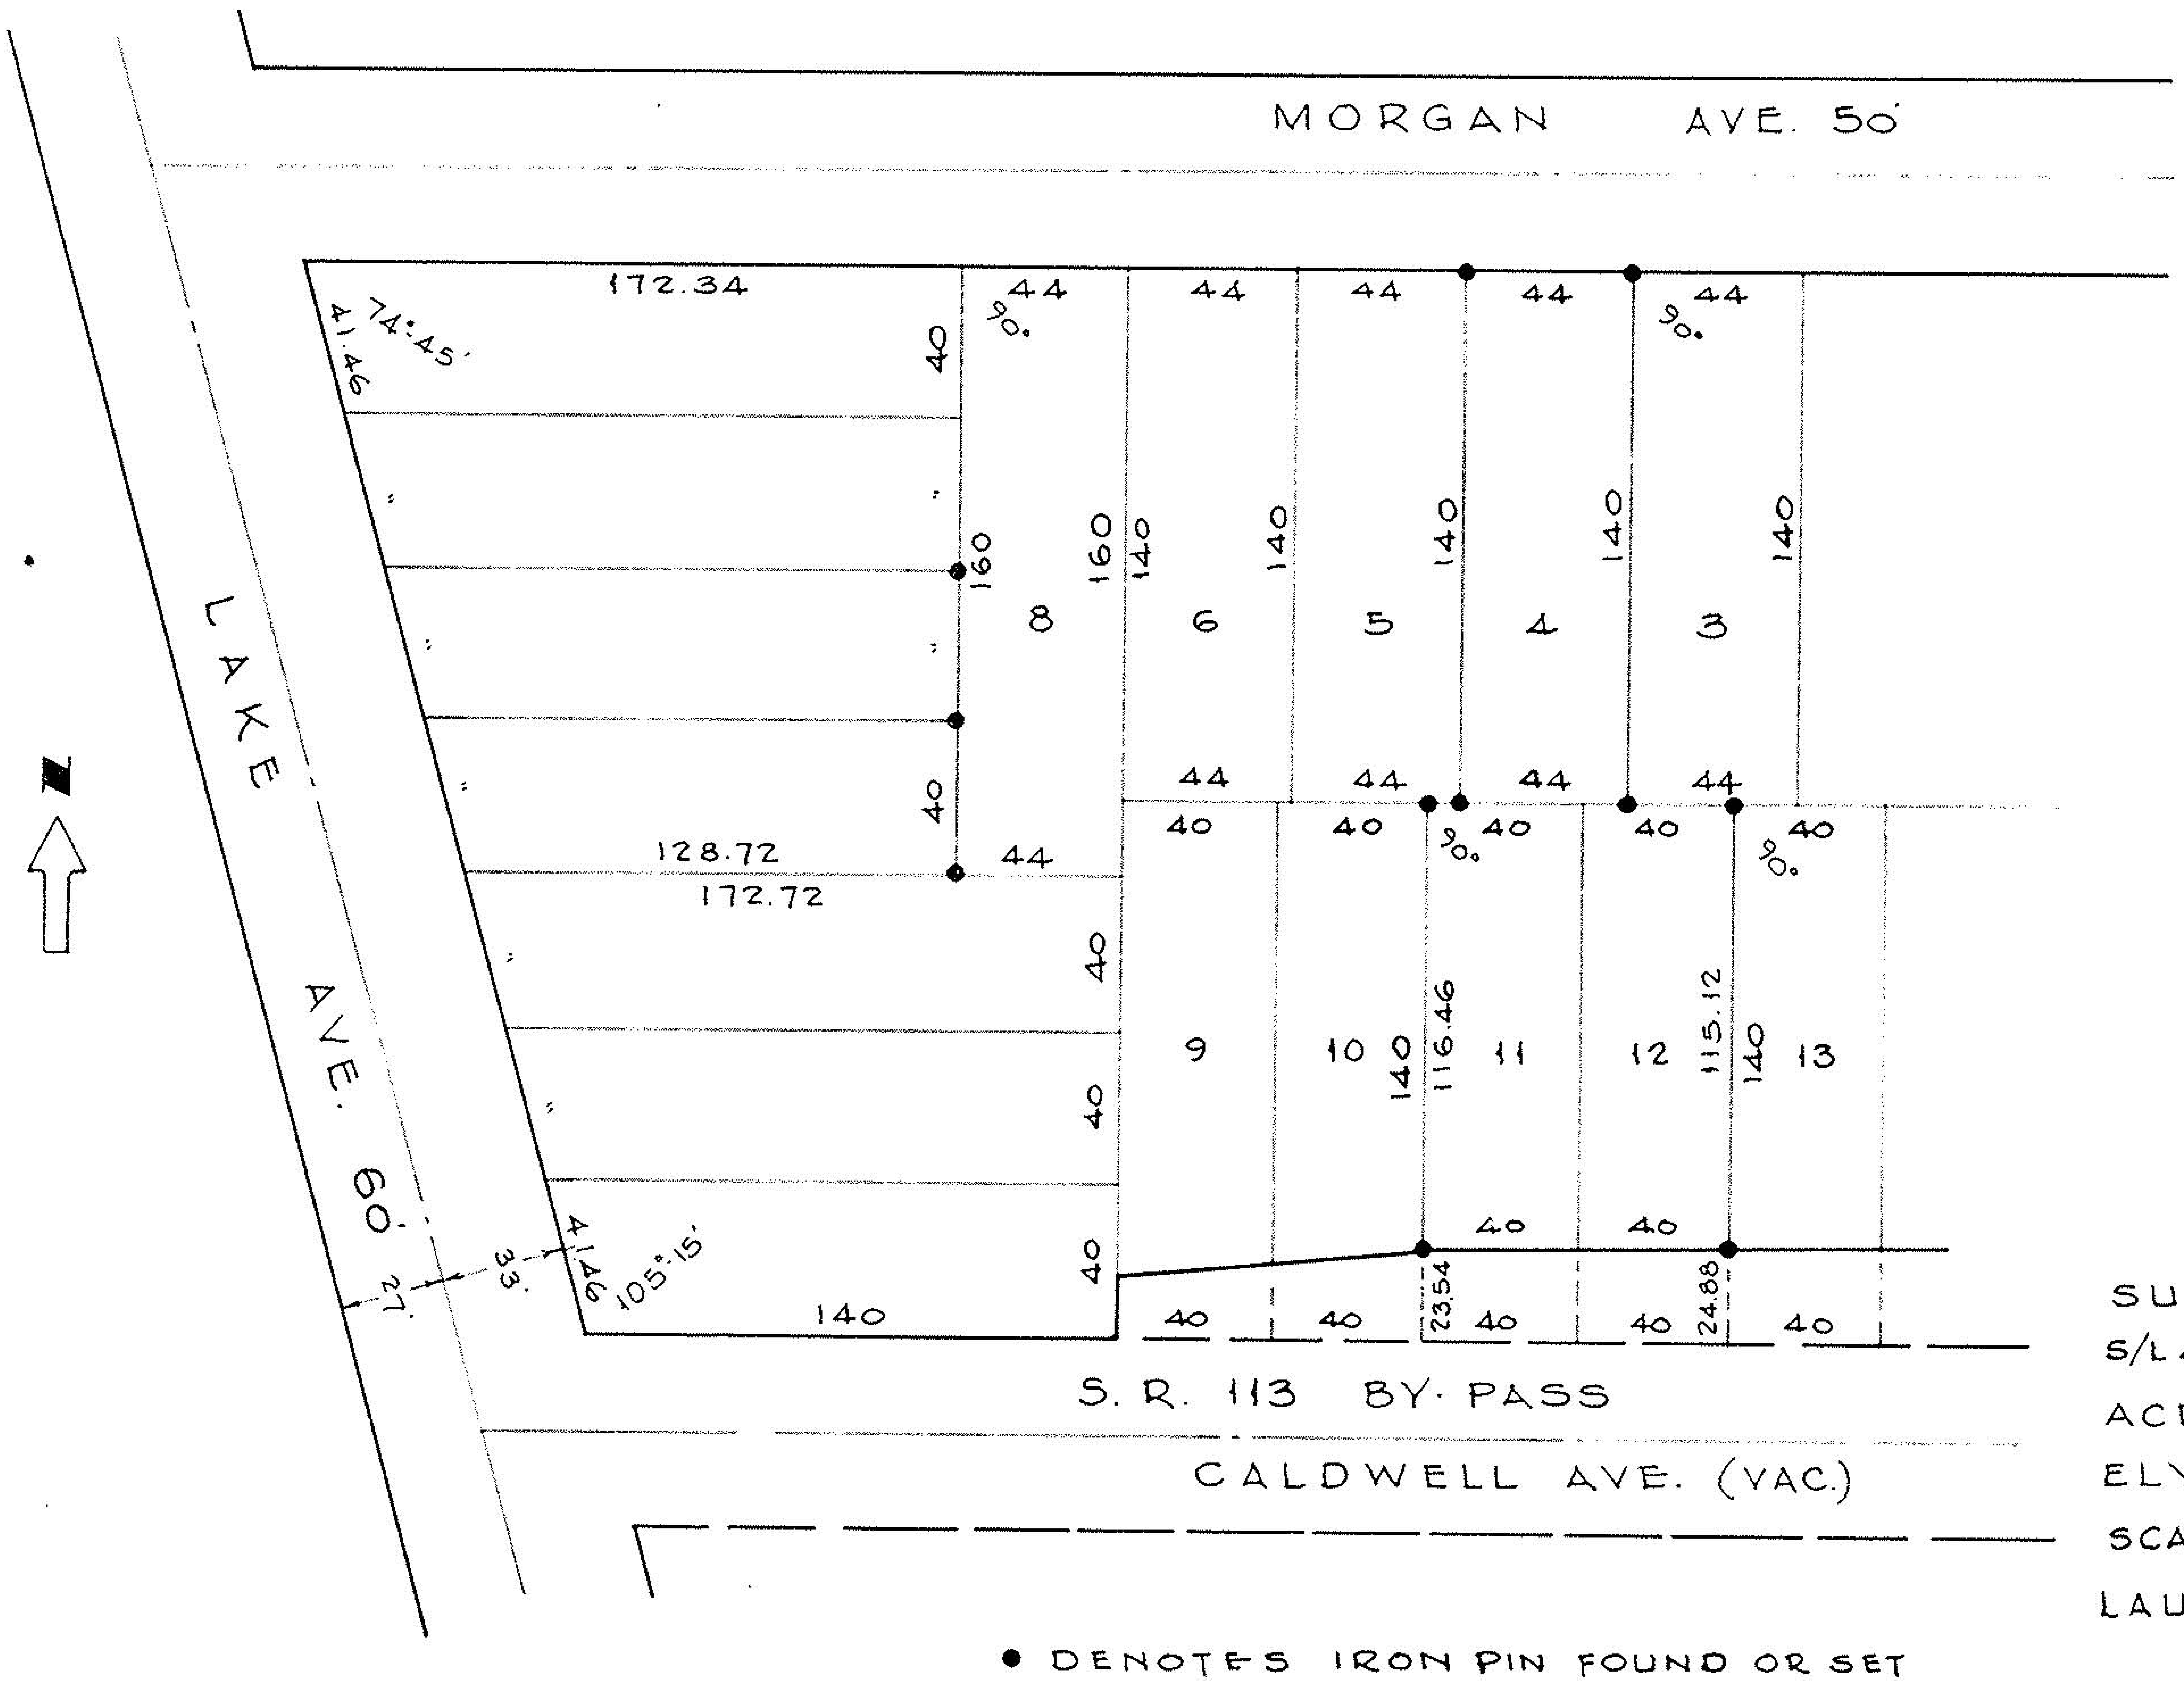

SURVEY FOR JACK & IRENE CABLE

S/L 4 BLK 51 - S/L's 11-12 BLK. 52

ACRE FARMS ALLOT. P.V. 9 PG. 21

ELYRIA CITY - LORAIN CO. - OHIO

SCALE 1"=60' JAN. 1973

LAUNDON · SIMON · CAHL & ASSOC.

ENGINEERS - SURVEYORS

JOB 73-74