06-25-007-000-124

6-126

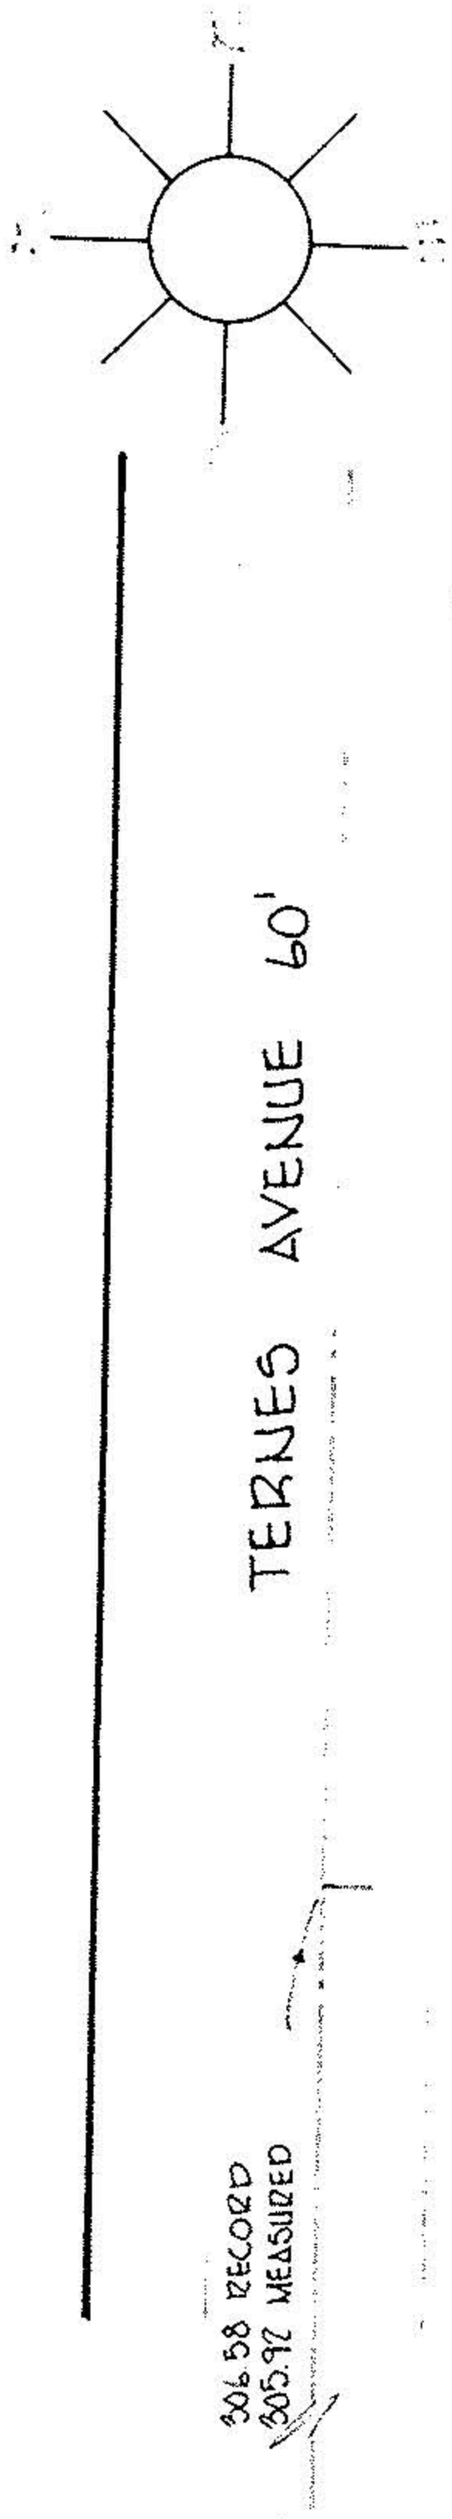

ELYRIA TELEPHONE

IRON PIN FOUND

28'10"
30'7"
33'11"
11'8"

2'10"

S.86° 22' 30" E. 193.00'

IRON PIN SET

18'5½"

15'5"

2'6½"

3'6"

IRON PIN FOUND

95.00'

46'3"

N.3° 13' 30" W.

6'

29'2"

13'

IRON PIN SET

IRON PIN SET

N 86° 22' 30" W. 190.07'

S.5° 23' 20" W. 95.04'

PERIMETER SURVEY

Scale 1" : 40'

Acreage 0.418

SUBLOT ____ of ____

Plat Vol ____ Page ____

Part of O.L. 7 Section ____

Tract ____ ELYRIA TWP

City of ELYRIA

LORAIN Co., Ohio

Michael G. Hura & Associates

4560 Liberty Ave. Vermilion, Ohio

drawn p.a.r.

date 8-25-80

scale 1" = 40'

field book

PERMANENT PARCEL NUMBER

06-25-007-000-012