


ACREAGE 5.047	PREPARED FOR JOHN BELU, BELU & SONS PAVING 4900 FRENCH CREEK ROAD LORAIN, OHIO 44054
DATE NOV 13 1986	
DRAWN MGH	
SCALE 1" = 200 ft.	
	MICHAEL G. HURA, registered surveyor 12706 MASON RD., VERMILION, O., Ph(216) 965 4040
	PERIMETER SURVEY
	SUBLOT(s) _____ of _____ _____ Volume _____ Page _____ of PLATS PART OF O.L. 25 TRACT GORE SECTION _____ OF HENRIETTA TOWNSHIP LORAIN CO., OHIO PERMANENT PARCEL N ^o _____

B-A 08-20-025-000-020

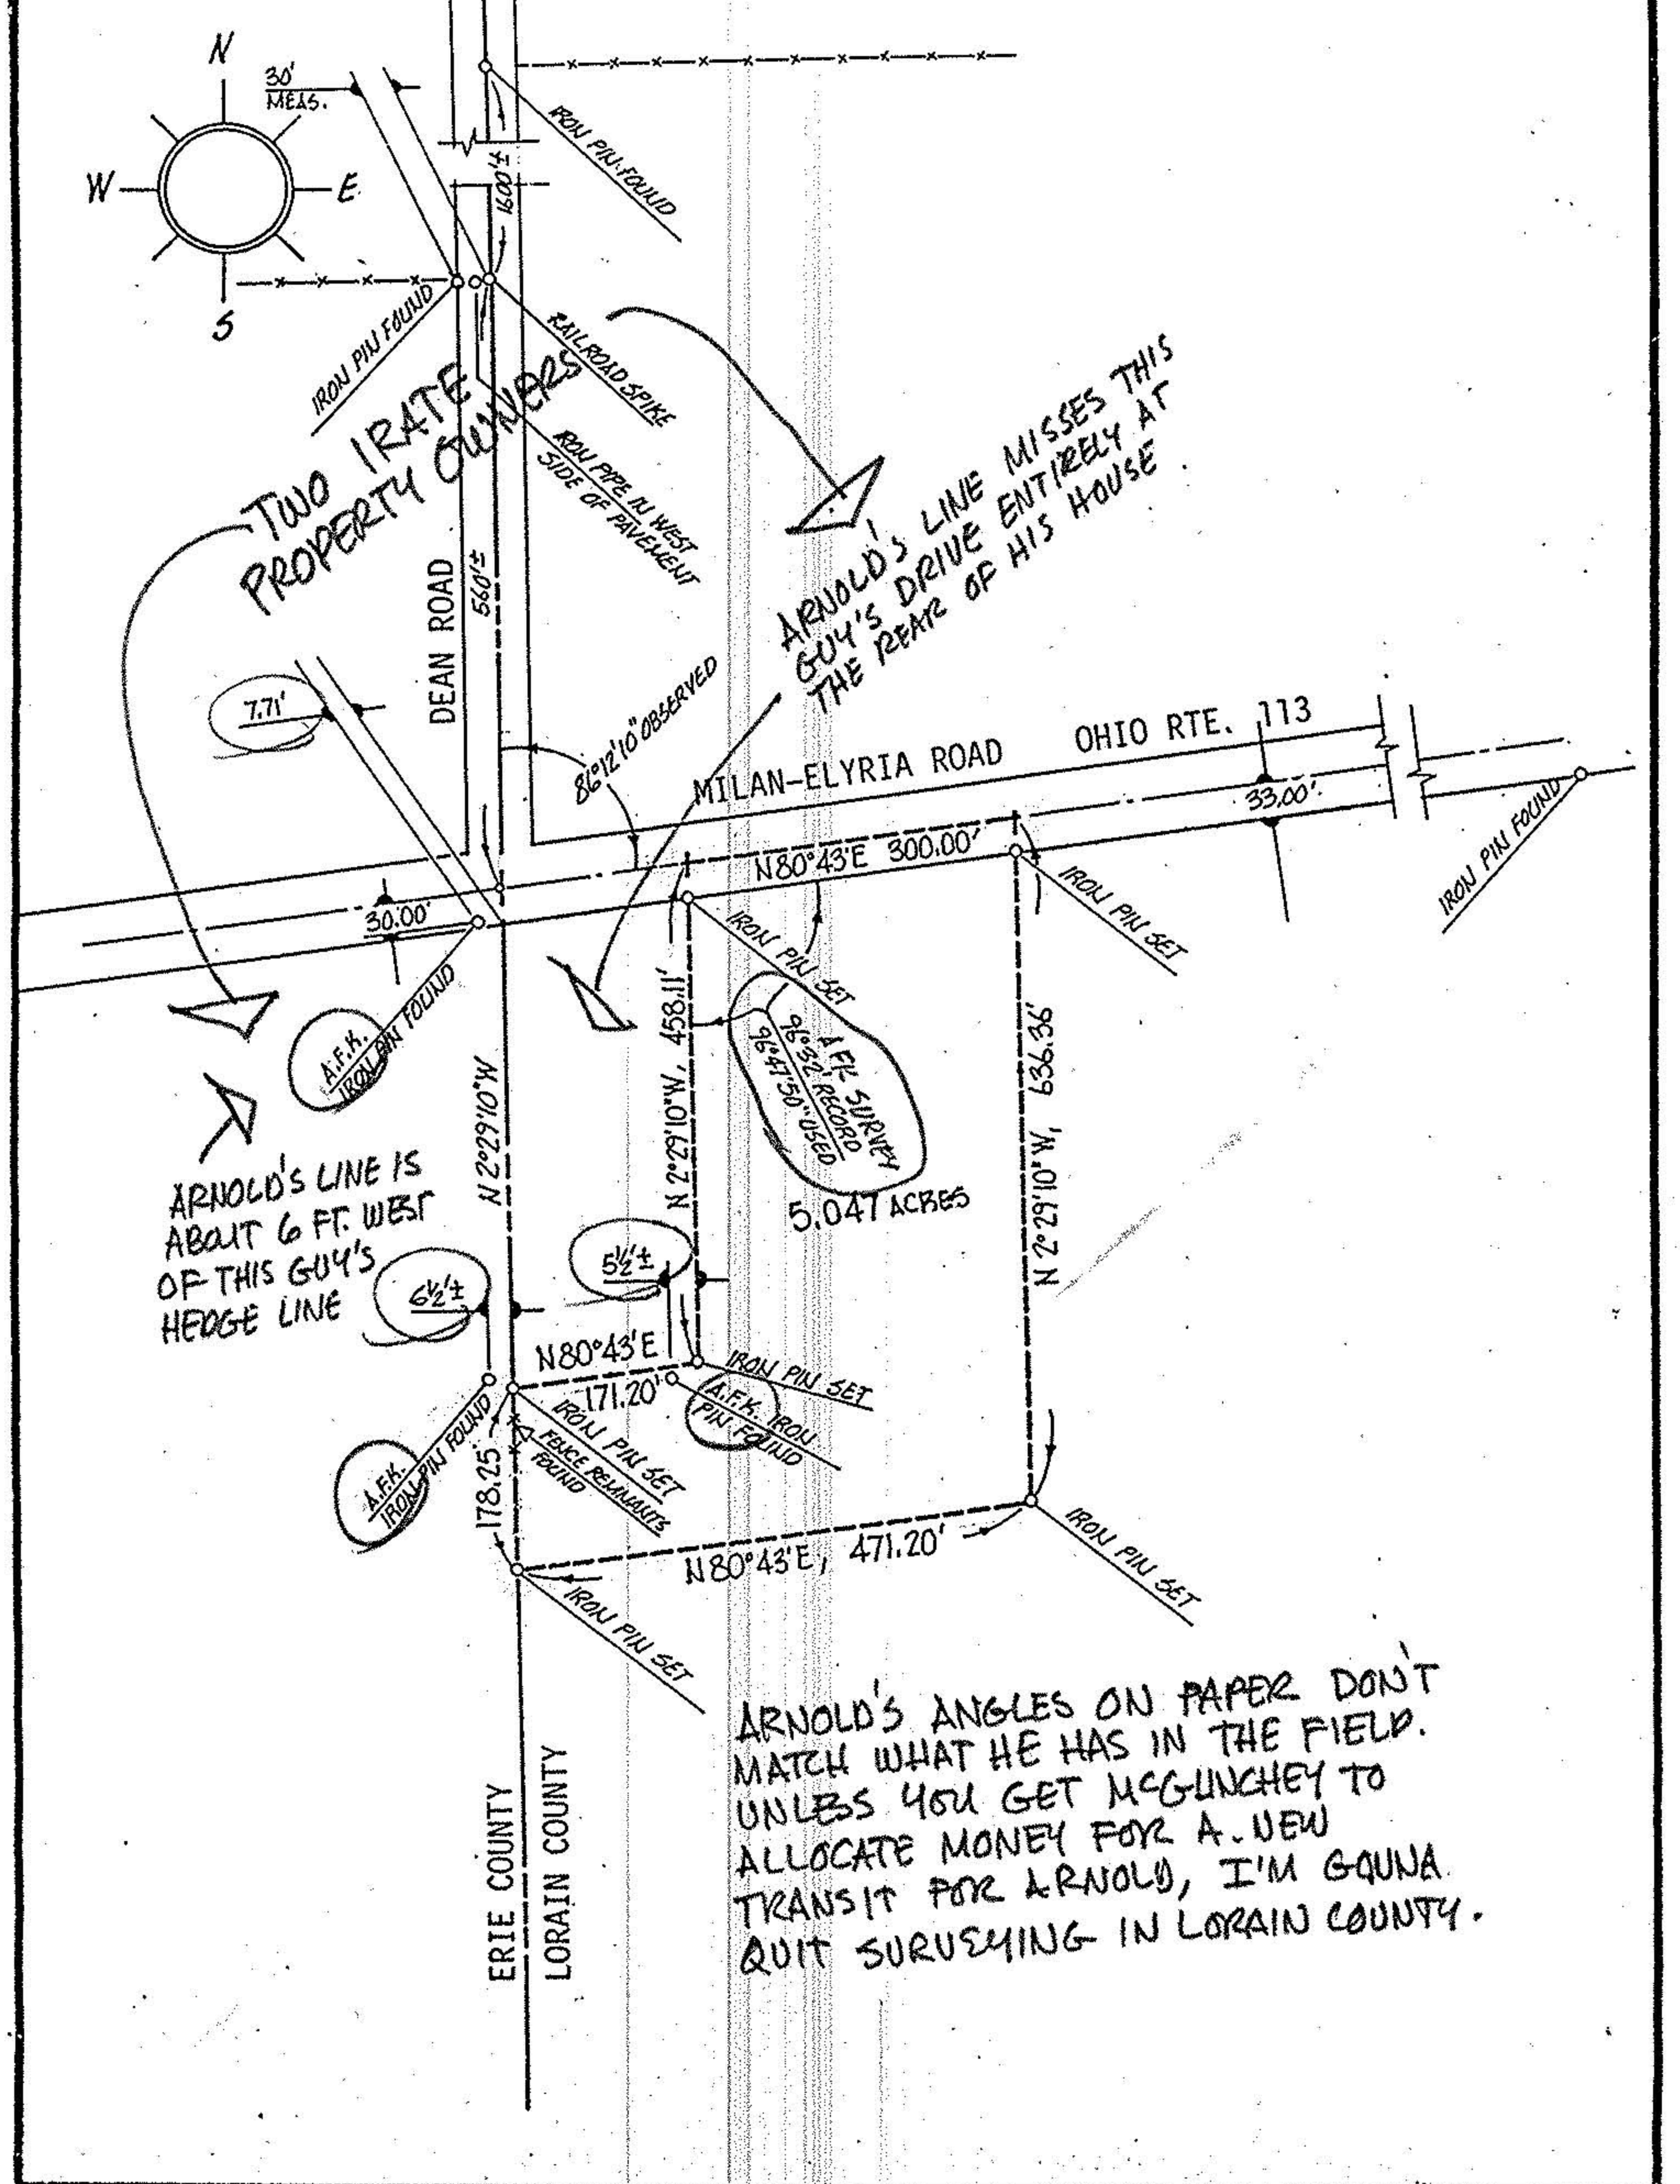

ACREAGE 5.047	PREPARED FOR JOHN BELU, BELU & SONS PAVING
DATE NOV 13 1986	4900 FRENCH CREEK ROAD LORAIN, OHIO 44054