010-000-00-018.00
010-000-00-060.00

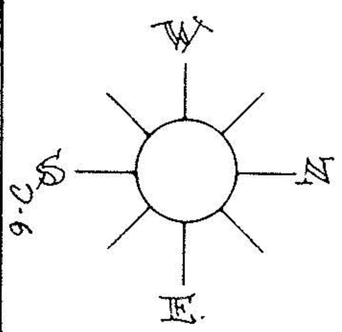

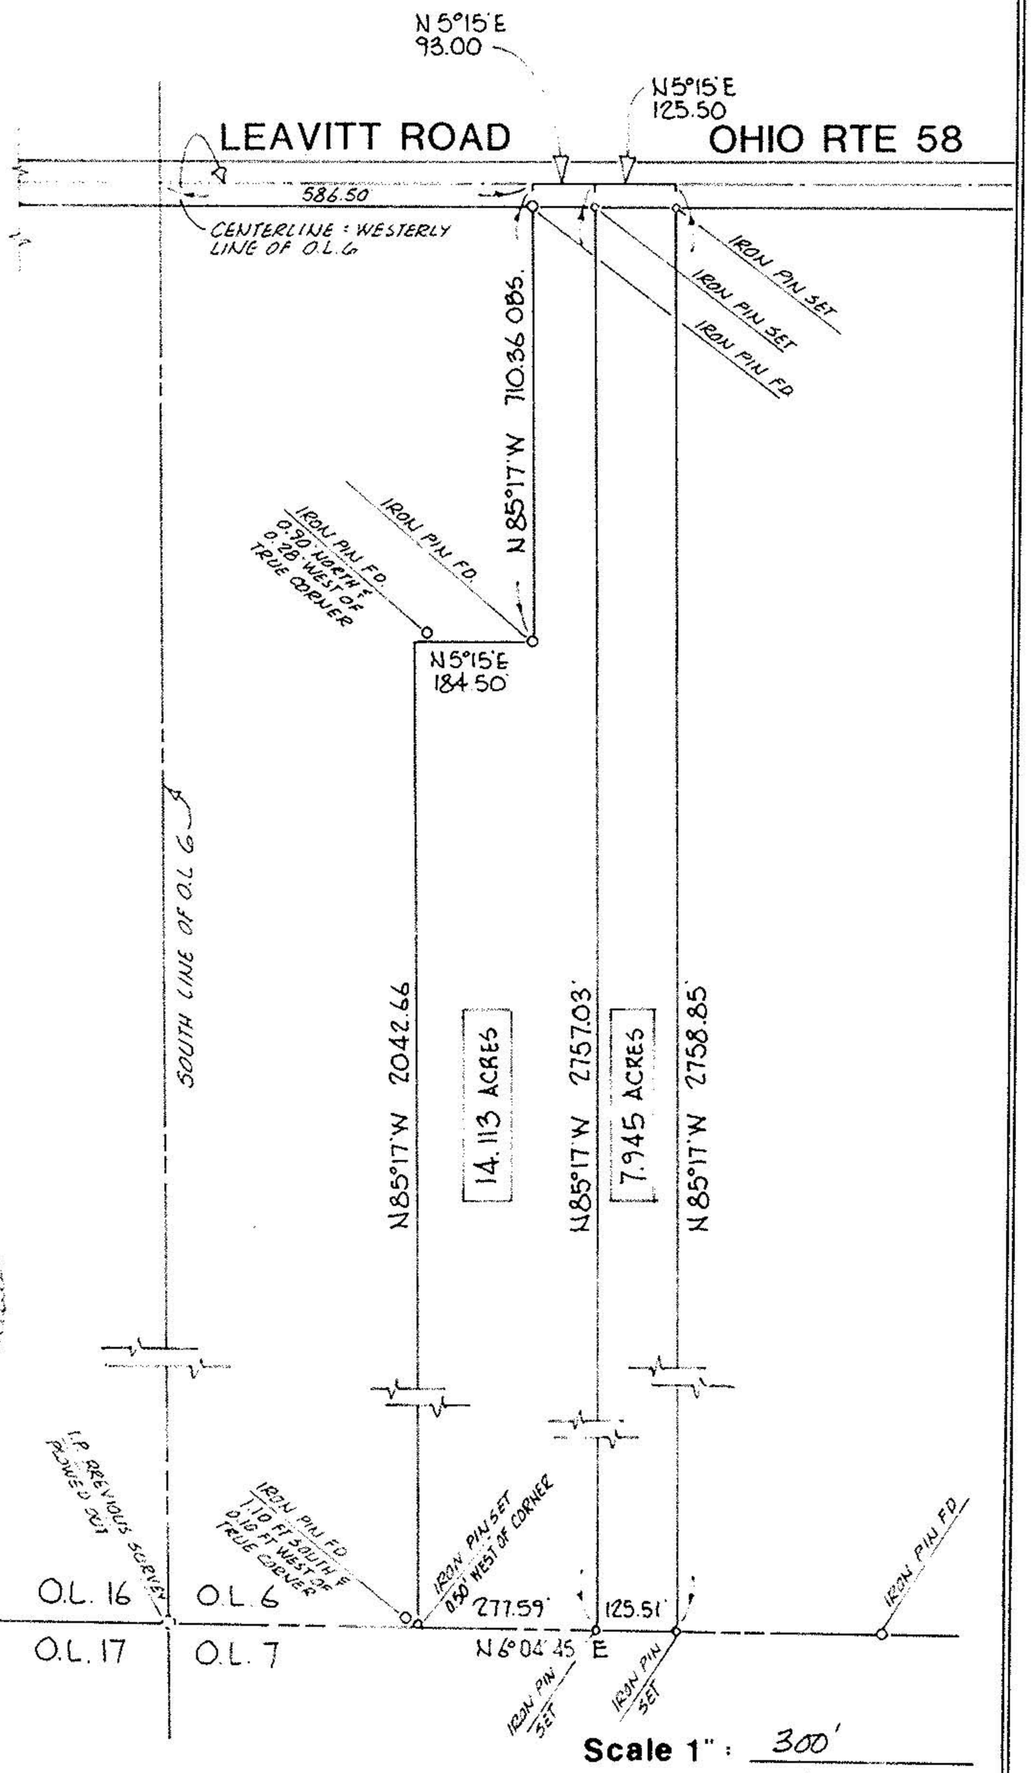

STATE OF OHIO
MICHAEL G. HURA
No. 4712
REGISTERED SURVEYOR

Scale 1" : 300'

Acreage 22.058

PERIMETER SURVEY

SUBLOT ____ of ____

Plat Vol ____ Page ____

Part of O.L. 6 Section ____

Tract ____ RUSSIA TWP

City of ____

LORAIN Co., Ohio

Michael G. Hura & Associates

4560 Liberty Ave. Vermilion, Ohio

drawn	MGH
date	06-17-80
scale	1" = 300'
field book	

PERMANENT PARCEL NUMBER