9-00-085-112-0[illegible]
9-00-085-B

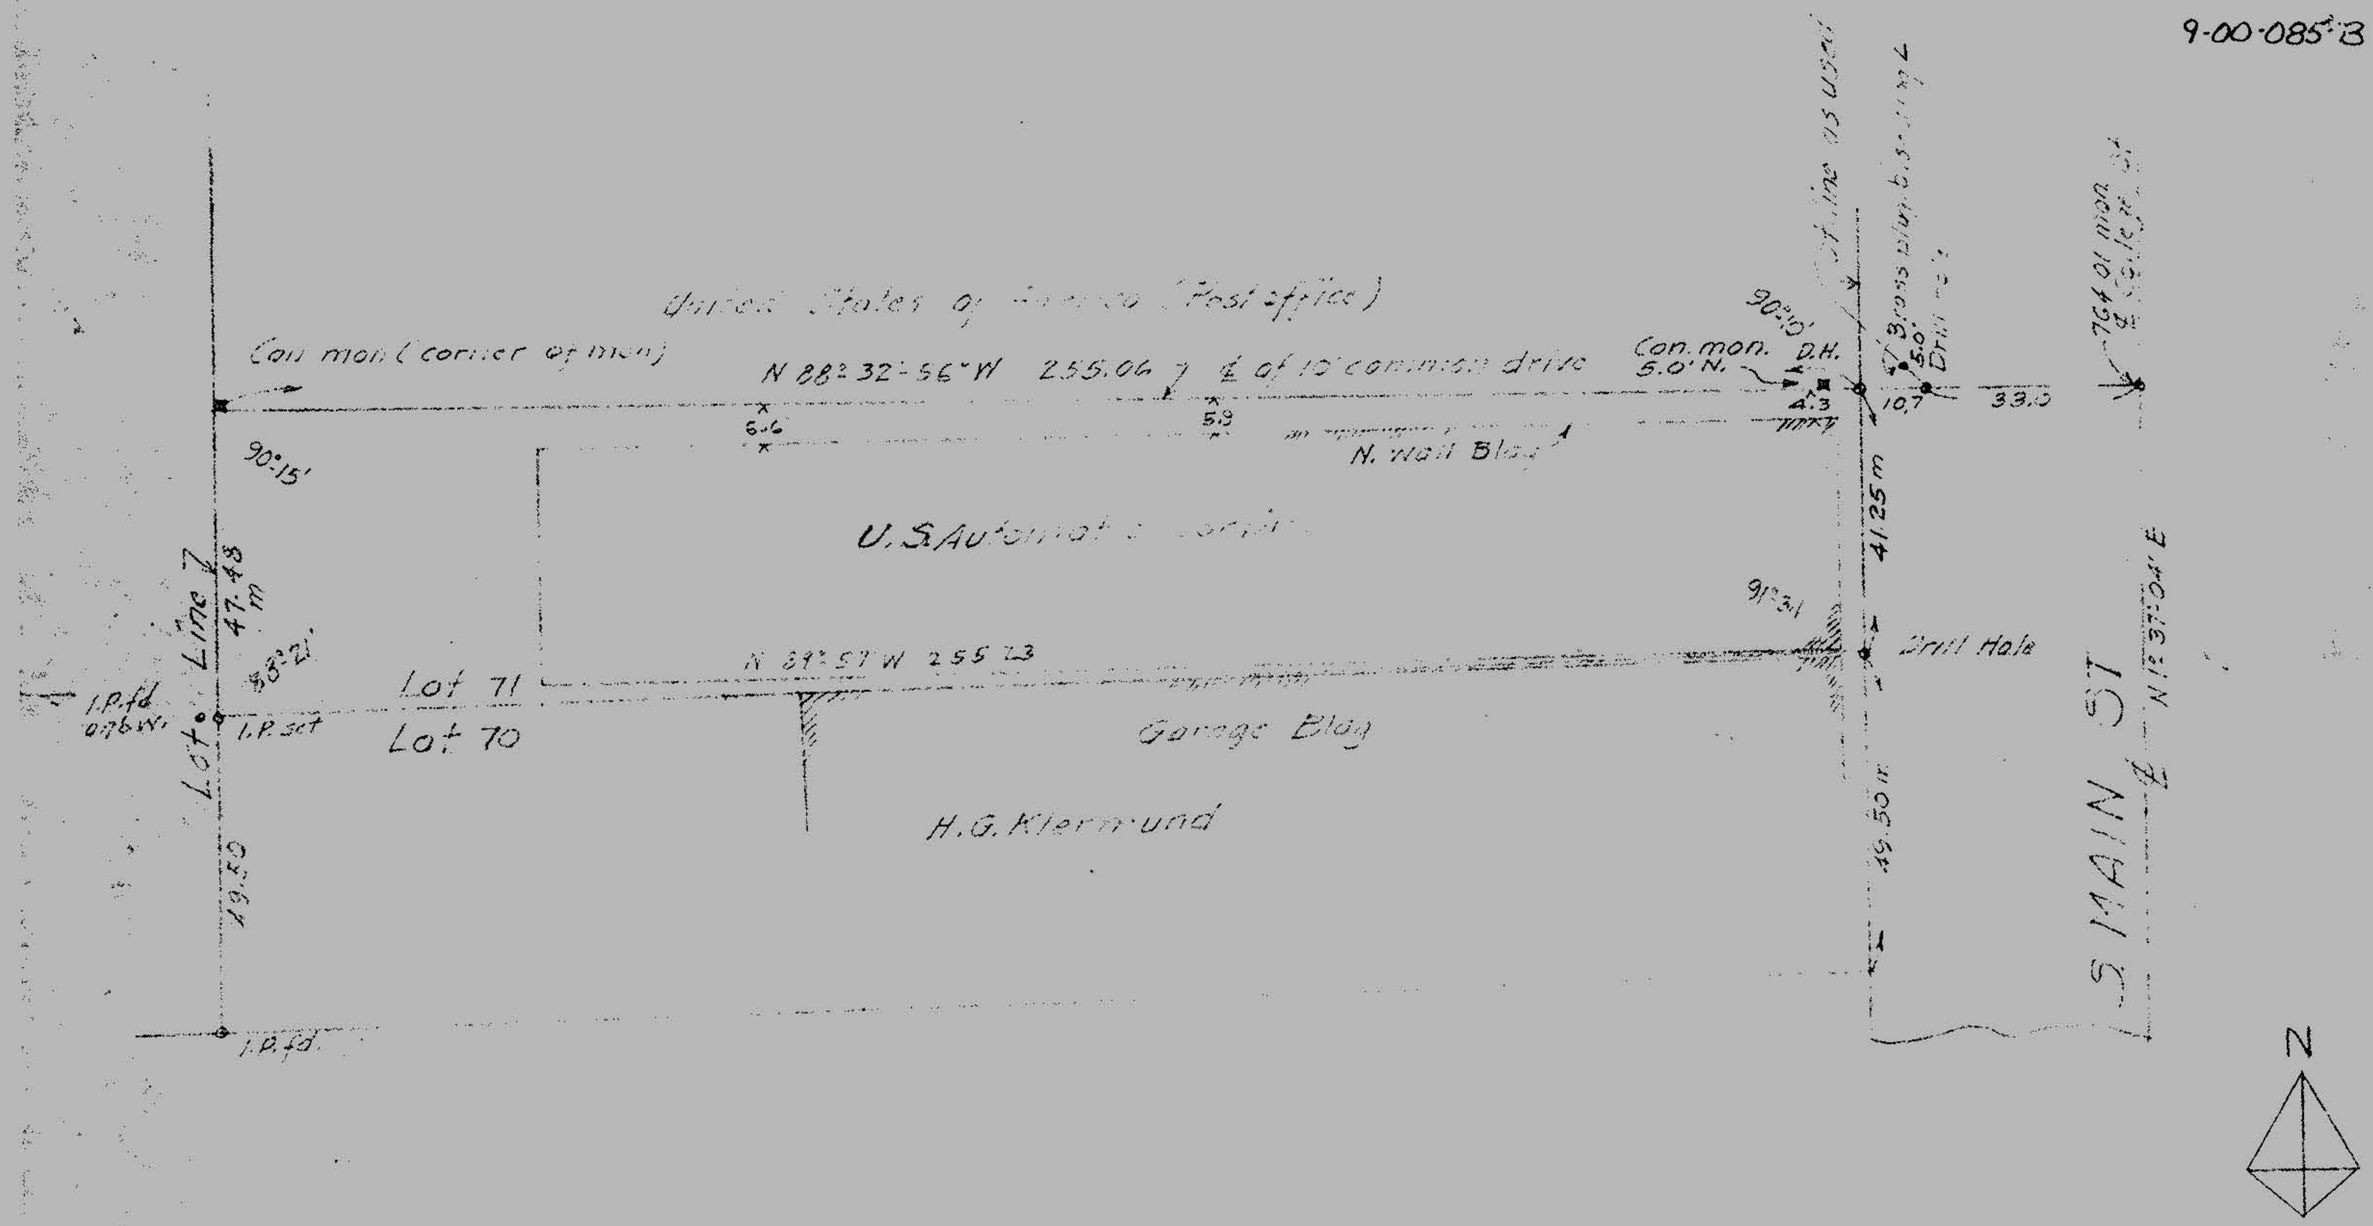

Survey for
U.S. Automatic Corp'n
Part of Lot 11 Original Village Plat
Oberlin Village. Lorain Co. Ohio.
Scale 1" = 30' Jan 26. 1944
T. W. Laundon Reg. Surveyor.