


10-00-005-107-132  
10-00-005-1

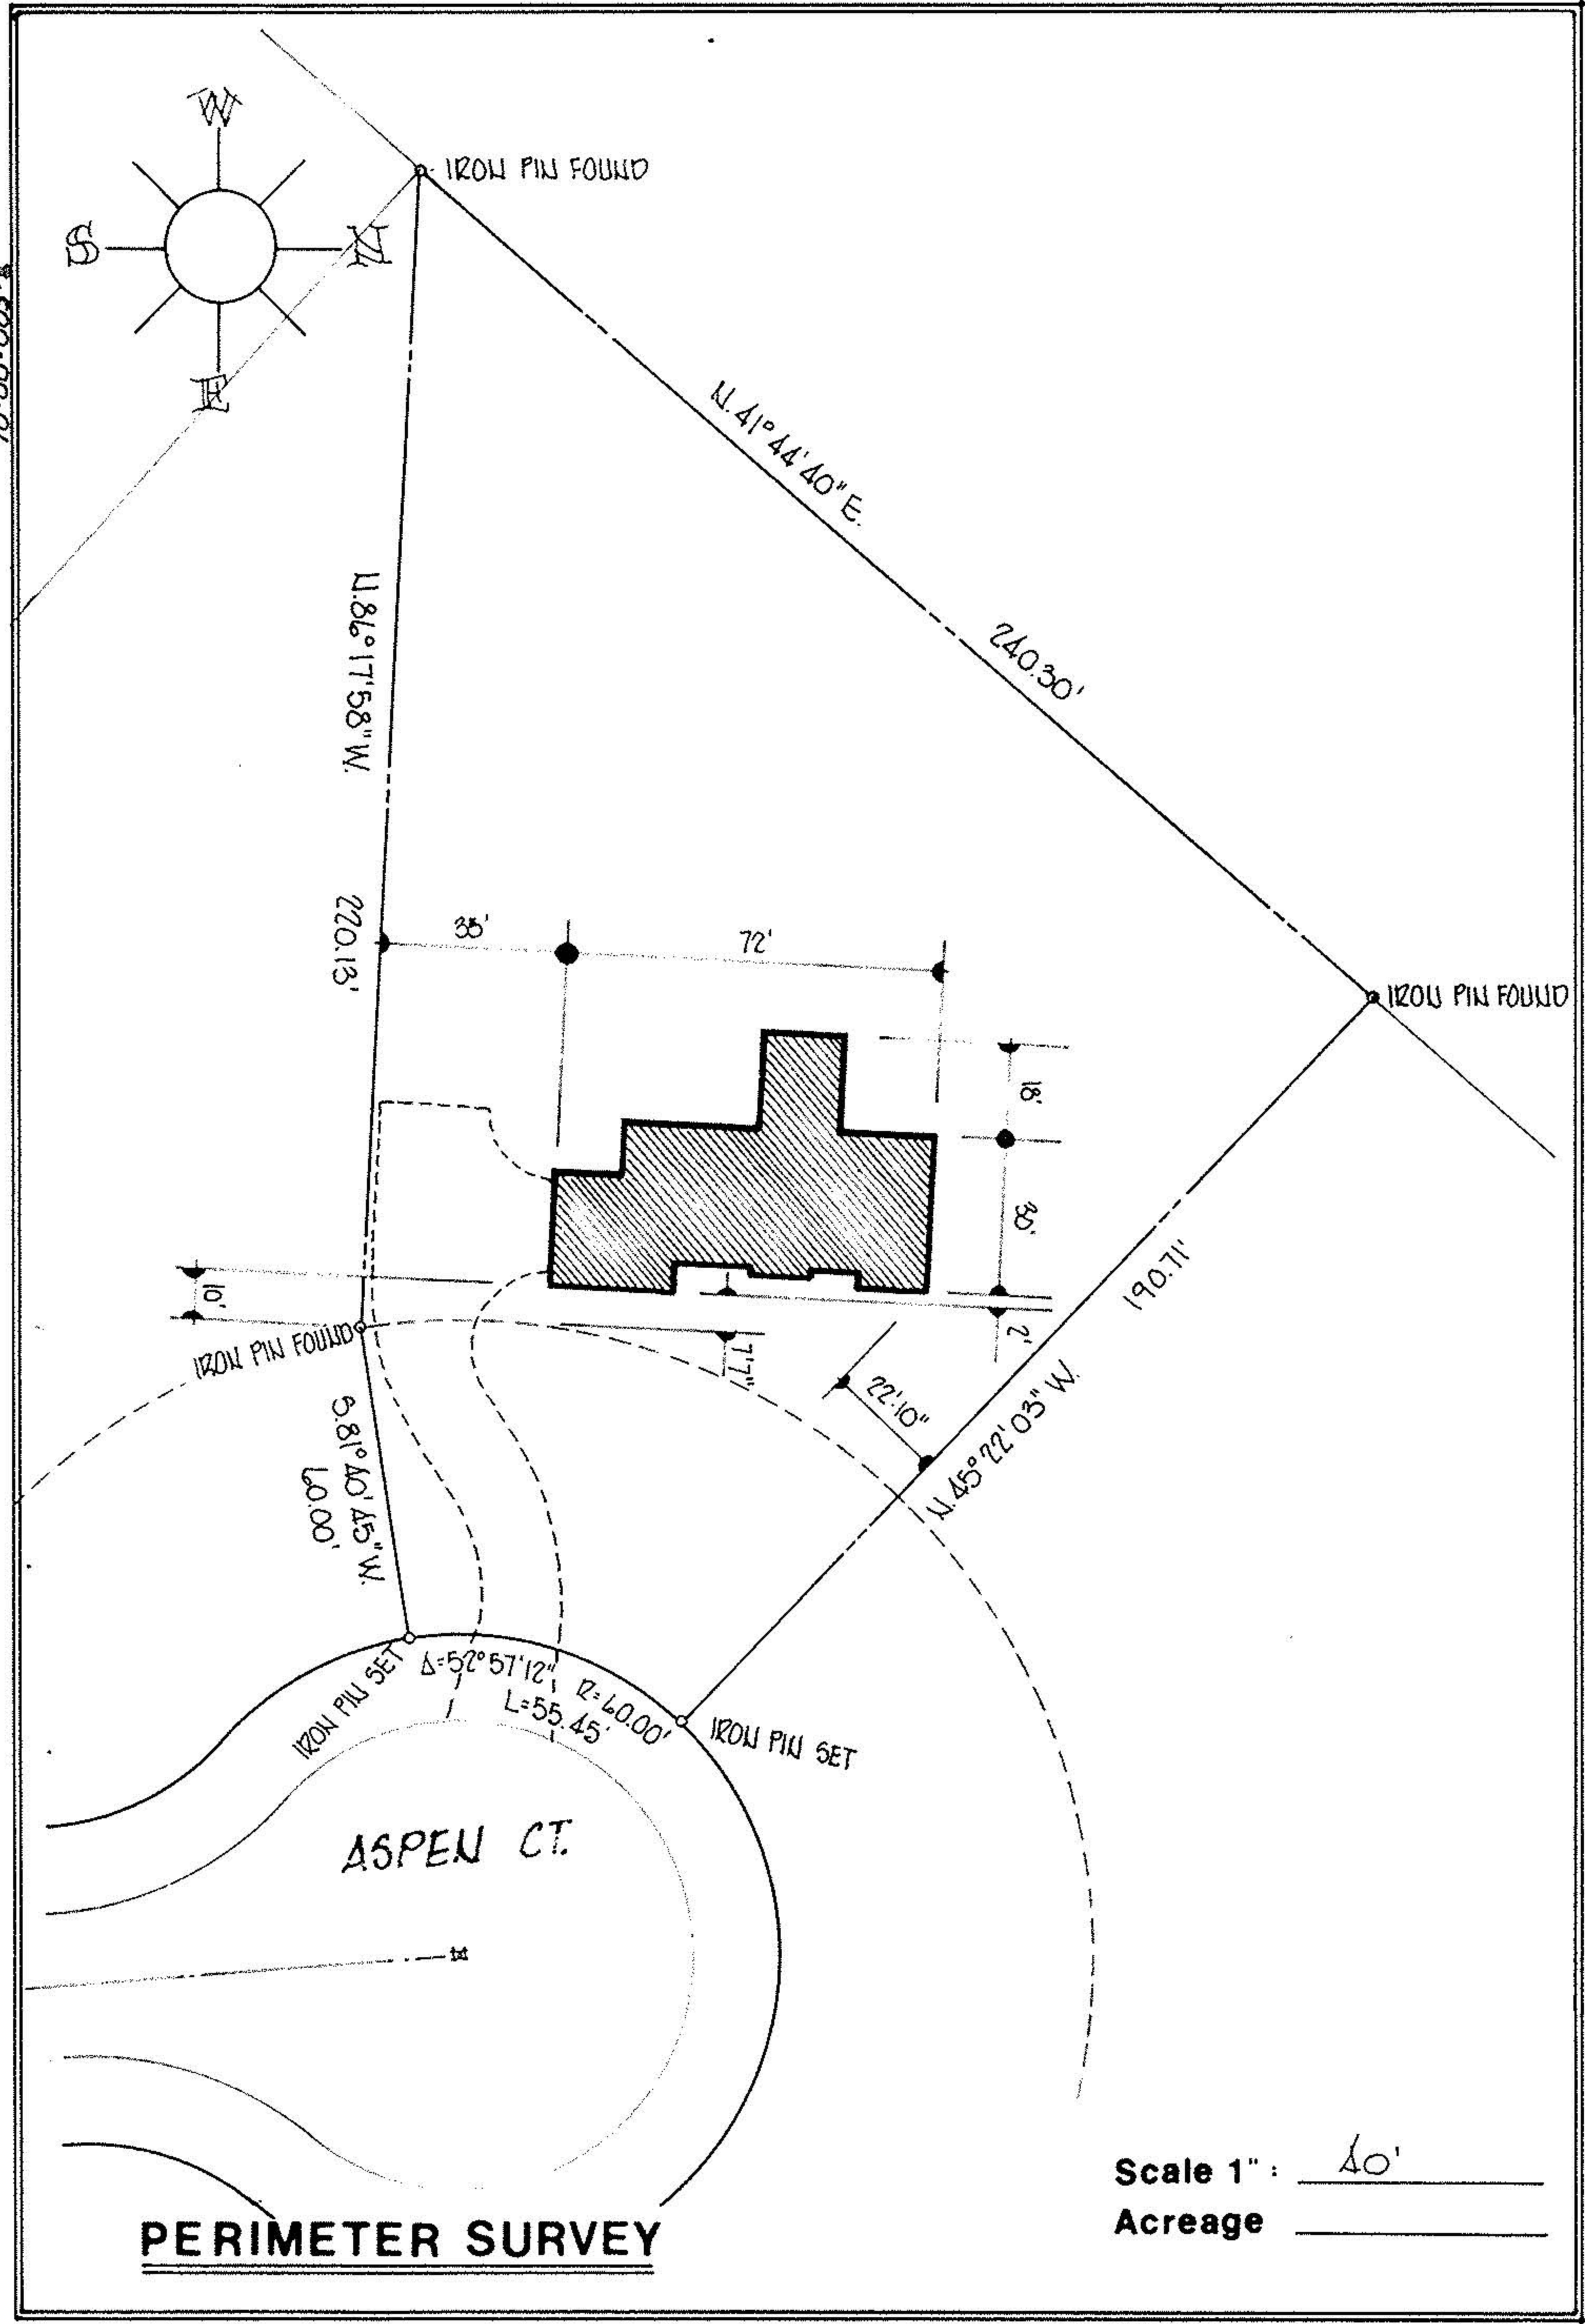

SUBLOT 27 of \_\_\_\_\_  
 WILLOWOOD ESTATES #2  
 Plat Vol 35 Page 45  
 Part of O.L. \_\_\_\_\_ Section 27  
 Tract \_\_\_\_\_ CADLISLE TWP  
 City of \_\_\_\_\_  
 \_\_\_\_\_ LOZAIN Co., Ohio

**Michael G. Hura & Associates**  
 4560 Liberty Ave. Vermilion, Ohio  
 drawn p.a.r.  
 date 8-21-80  
 scale 1" = 40'  
 field book

PERMANENT  
 PARCEL NUMBER