11-00-027-000-032
11-00-027-A & B

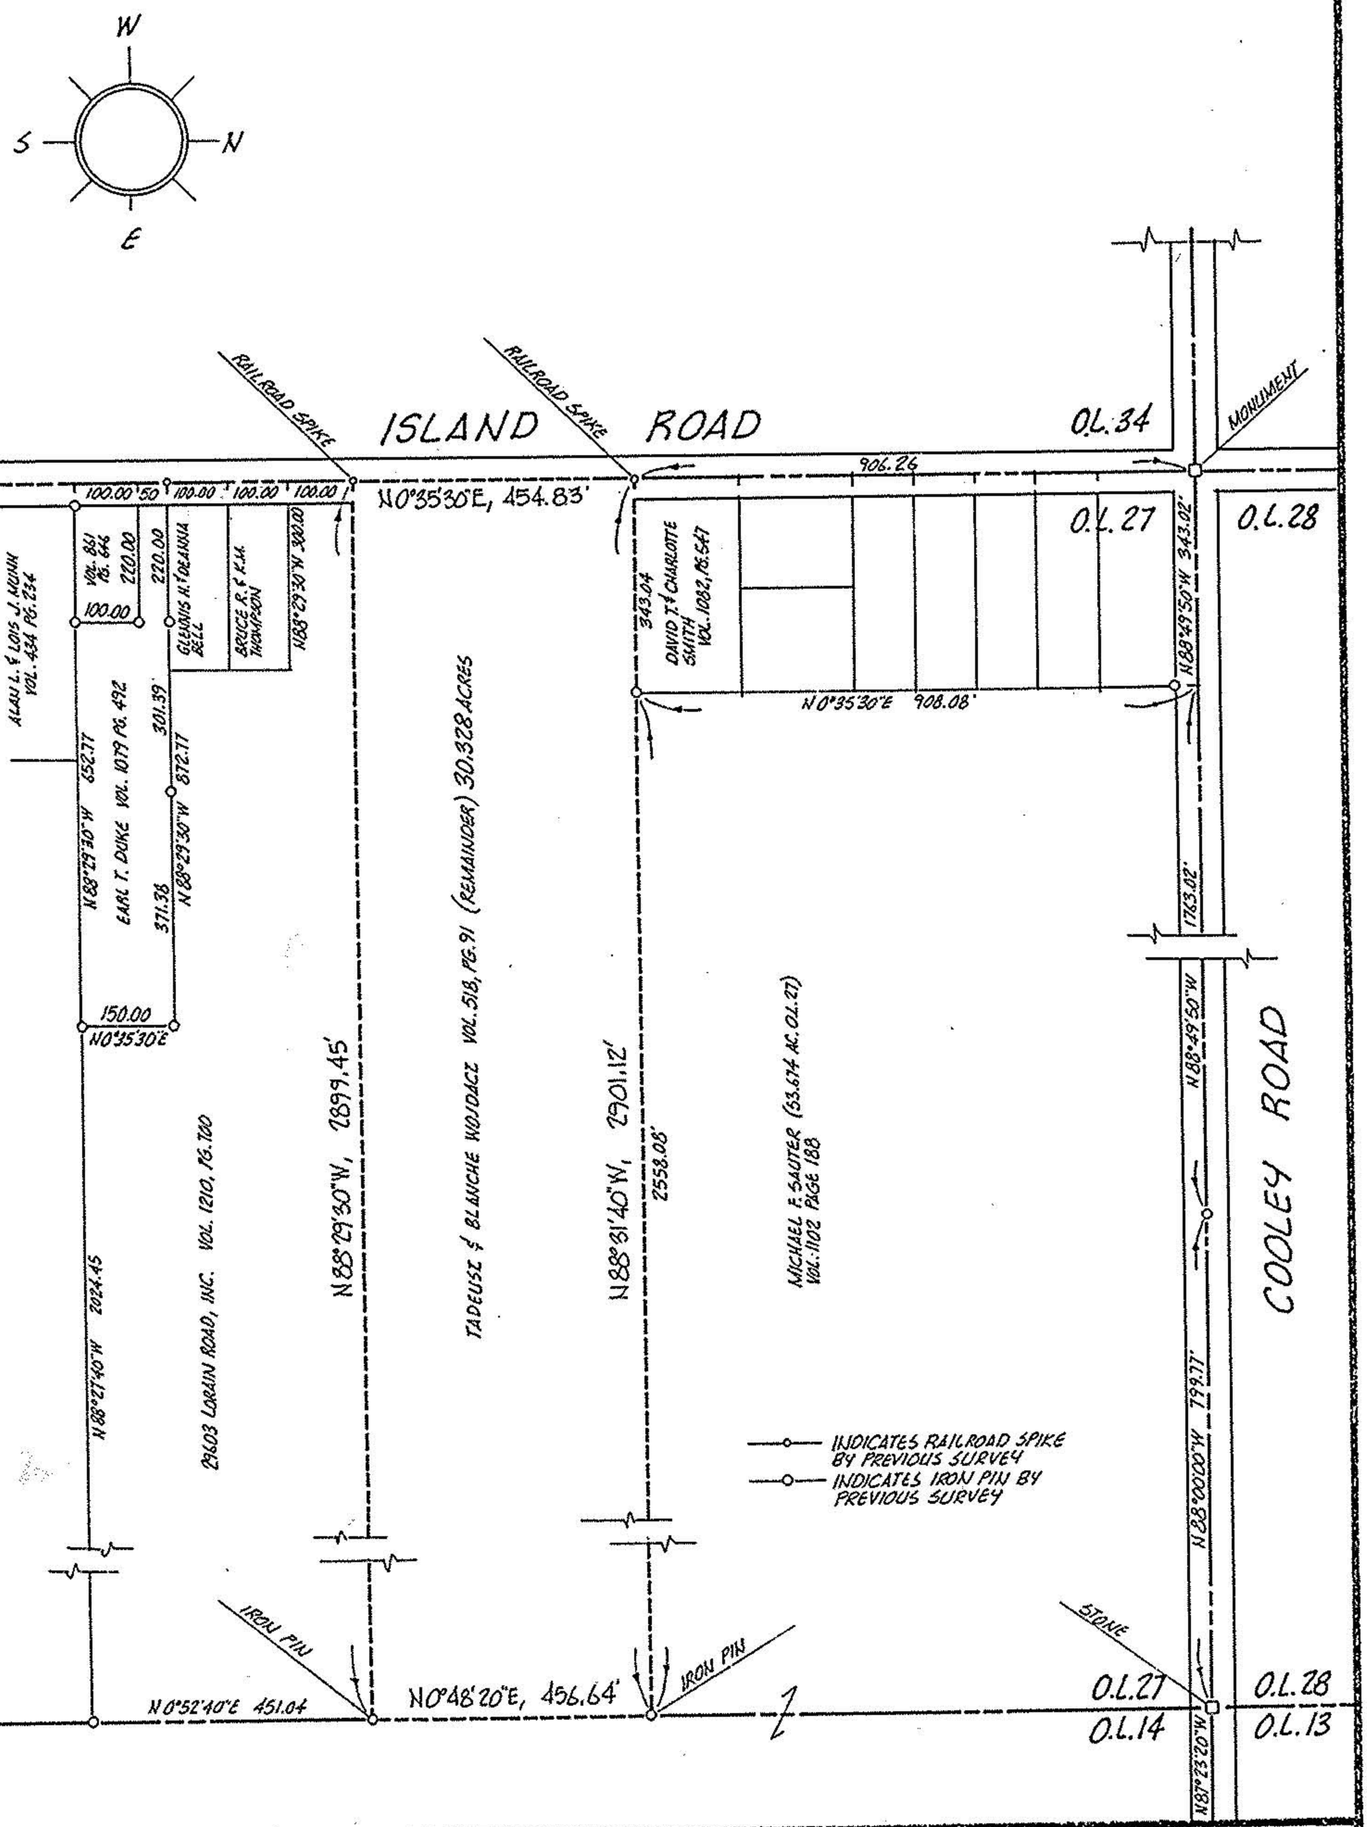

ACREAGE	30.327
DATE	06-18-86
DRAWN	MGH
SCALE	1" = 300 ft.

PREPARED FOR MR. HARRY W. RAPP
2048 BRAEWICK DR., AKRON 44313
864-8664

MICHAEL G. HURA, registered surveyor
12706 MASON RD., VERMILION, O., Ph (216) 965 4040

STATE OF OHIO
MICHAEL G. HURA
No. 4712
REGISTERED SURVEYOR

PERIMETER SURVEY

SUBLOT(s) _____ of _____
_____, Volume ____ Page ____ of PLATS
PART OF O.L. 27 TRACT ____ SECTION ____ OF
EATON TOWNSHIP LORAIN CO., OHIO
PERMANENT PARCEL Nº _____

CITY OF

11-00-027-A & B