



12-00-035-102-038
12-00-035-B

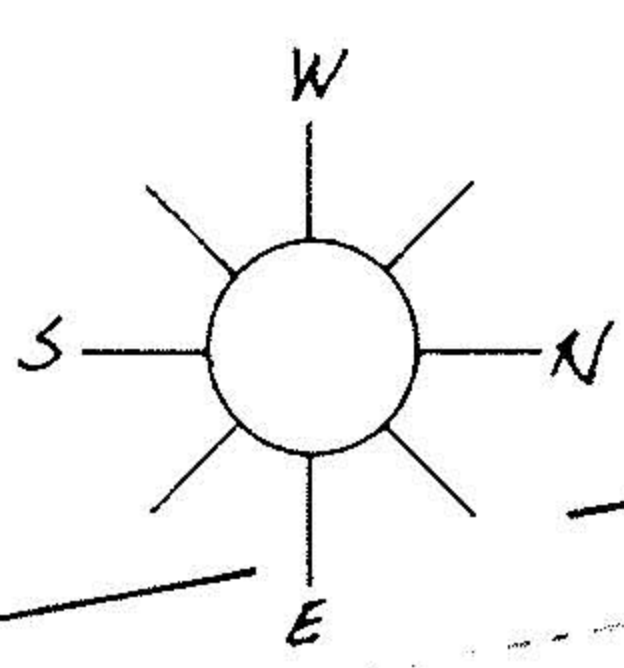

MALLET CREEK - BAY VILLAGE RD.
OHIO ROUTE 252

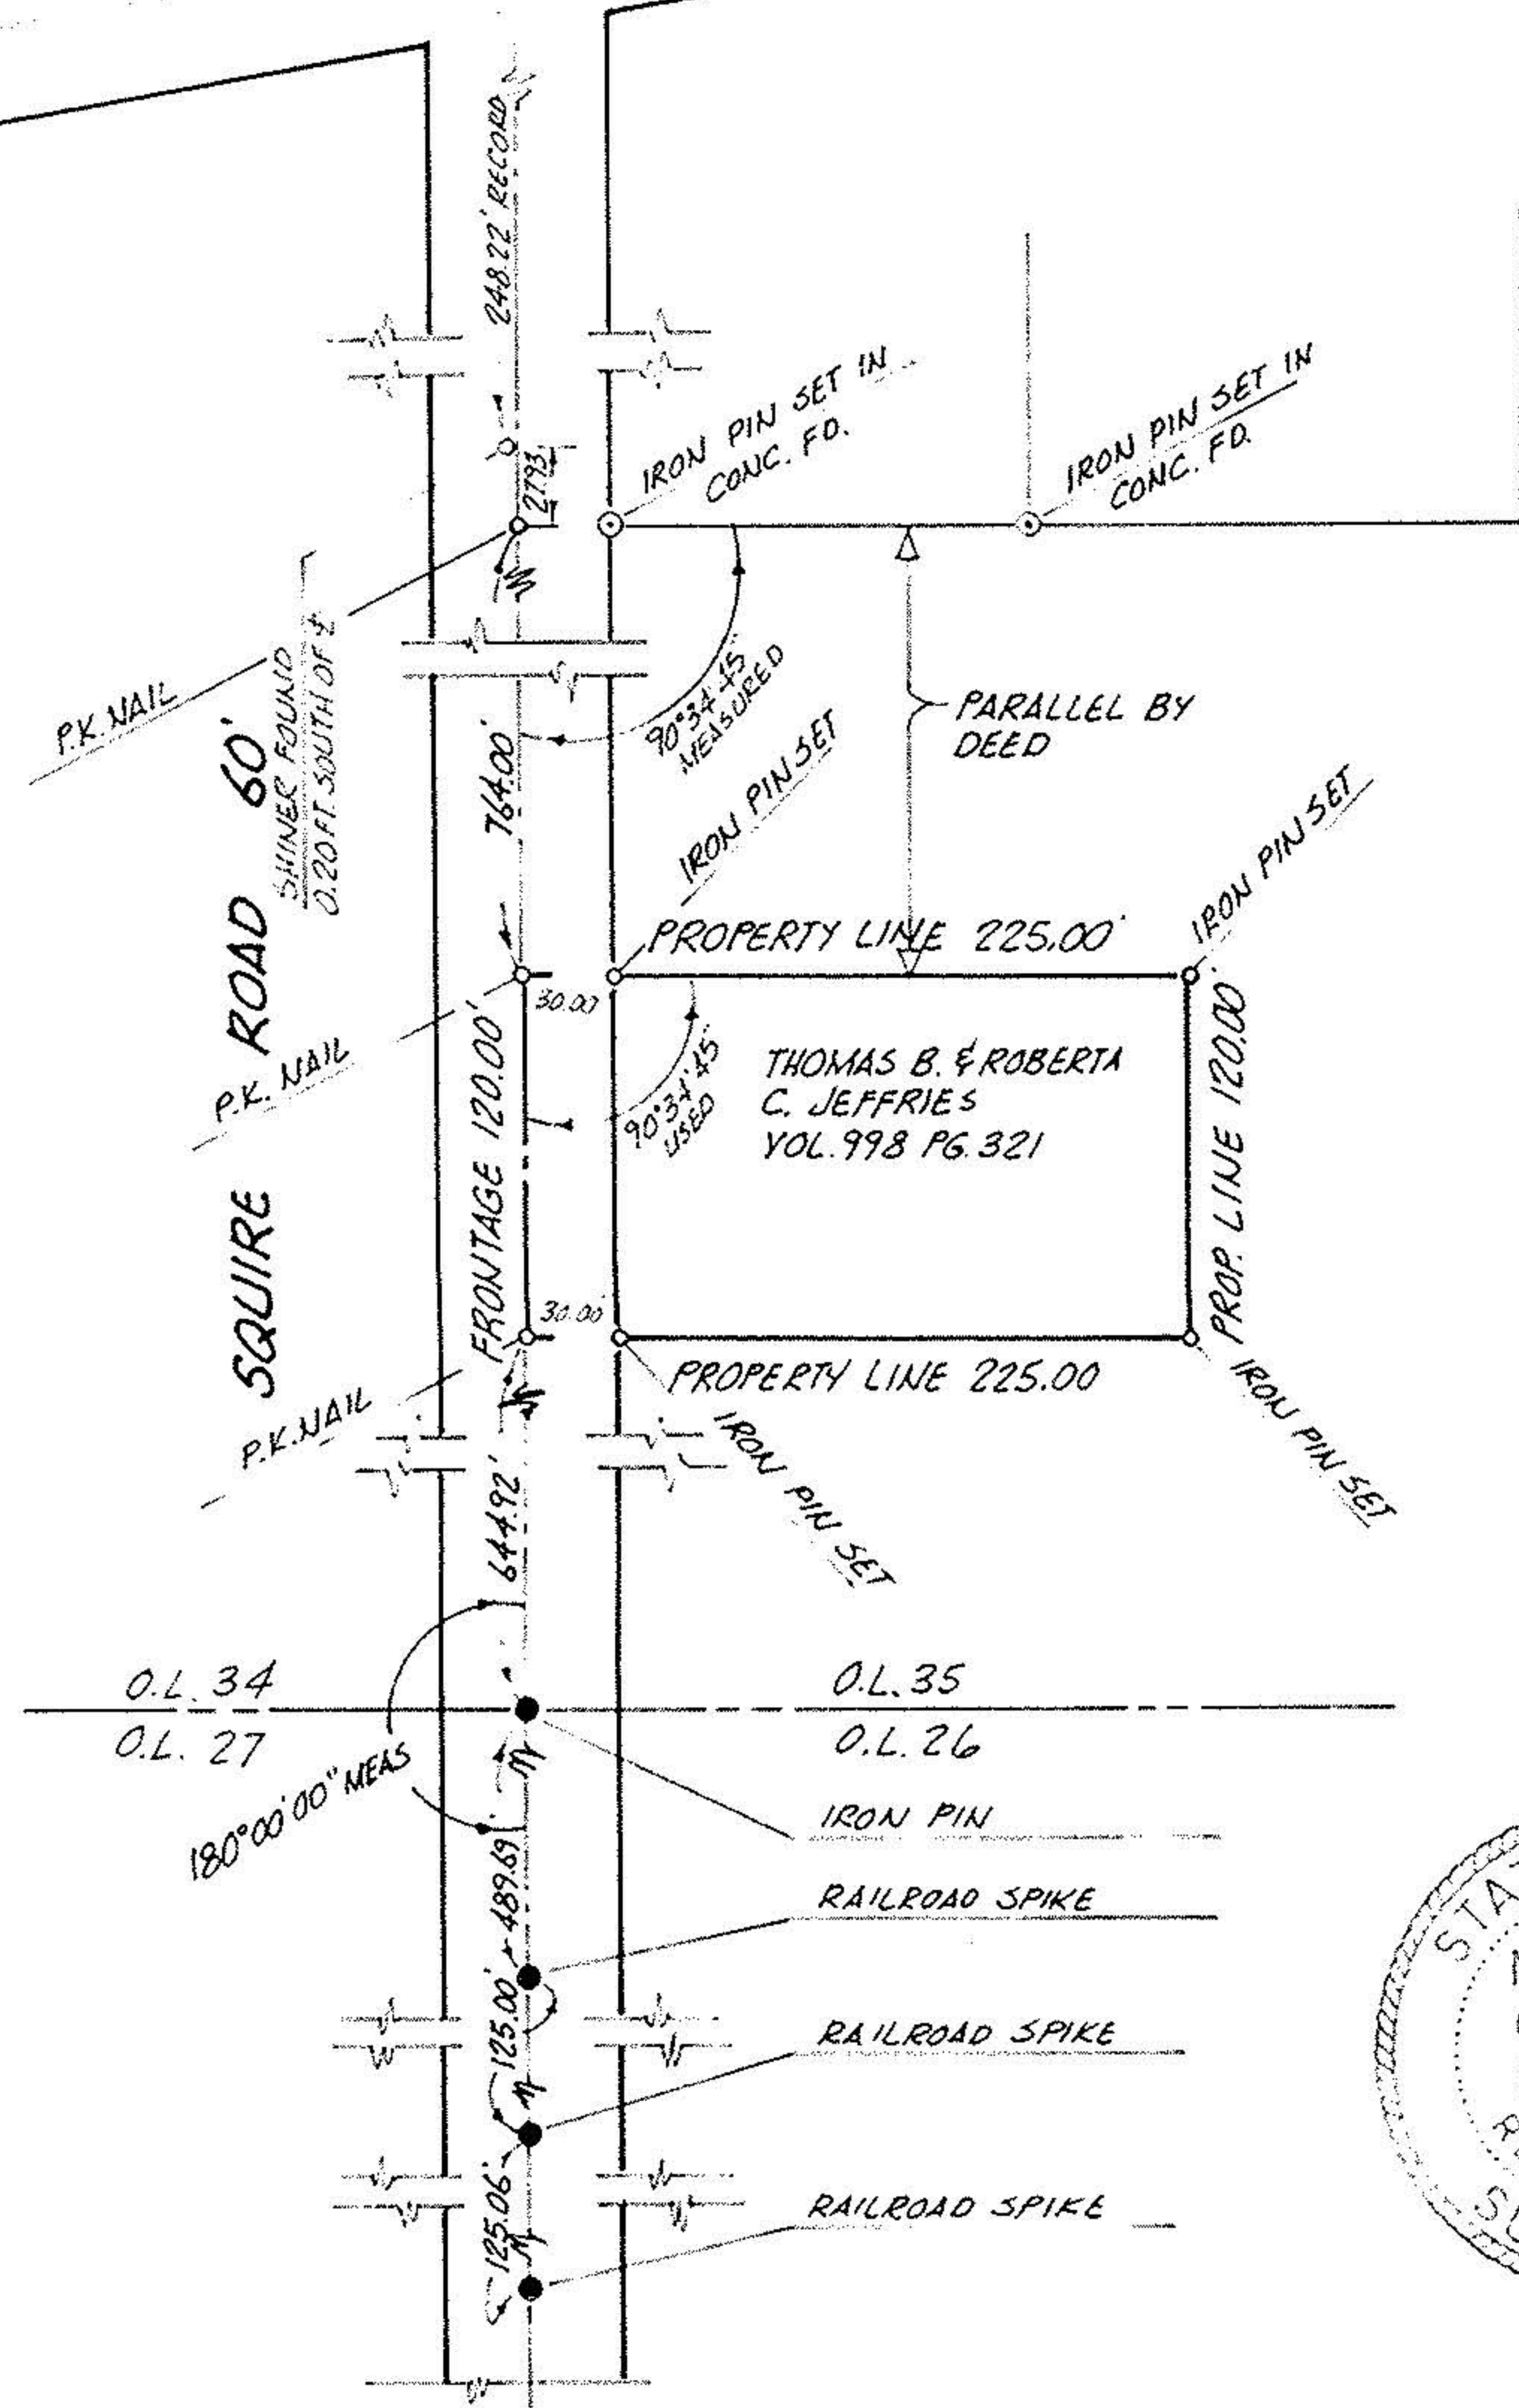

Scale 1" : 100'
Acreage 0.6198

PERIMETER SURVEY

SUBLOT _____ of _____
0.6198 ACRE PARCEL

Plat Vol _____ Page _____

Part of O.L. 35 Section _____
Tract COLUMBIA TWP
City of LORAIN Co., Ohio

Michael G. Hura & Associates
4560 Liberty Ave. Vermilion, Ohio

drawn MGH
date 10-01-79
scale 1"=100
field book

PERMANENT
PARCEL NUMBER
12-00-035-102-038

51A005121