SCALE: 1" = 60'

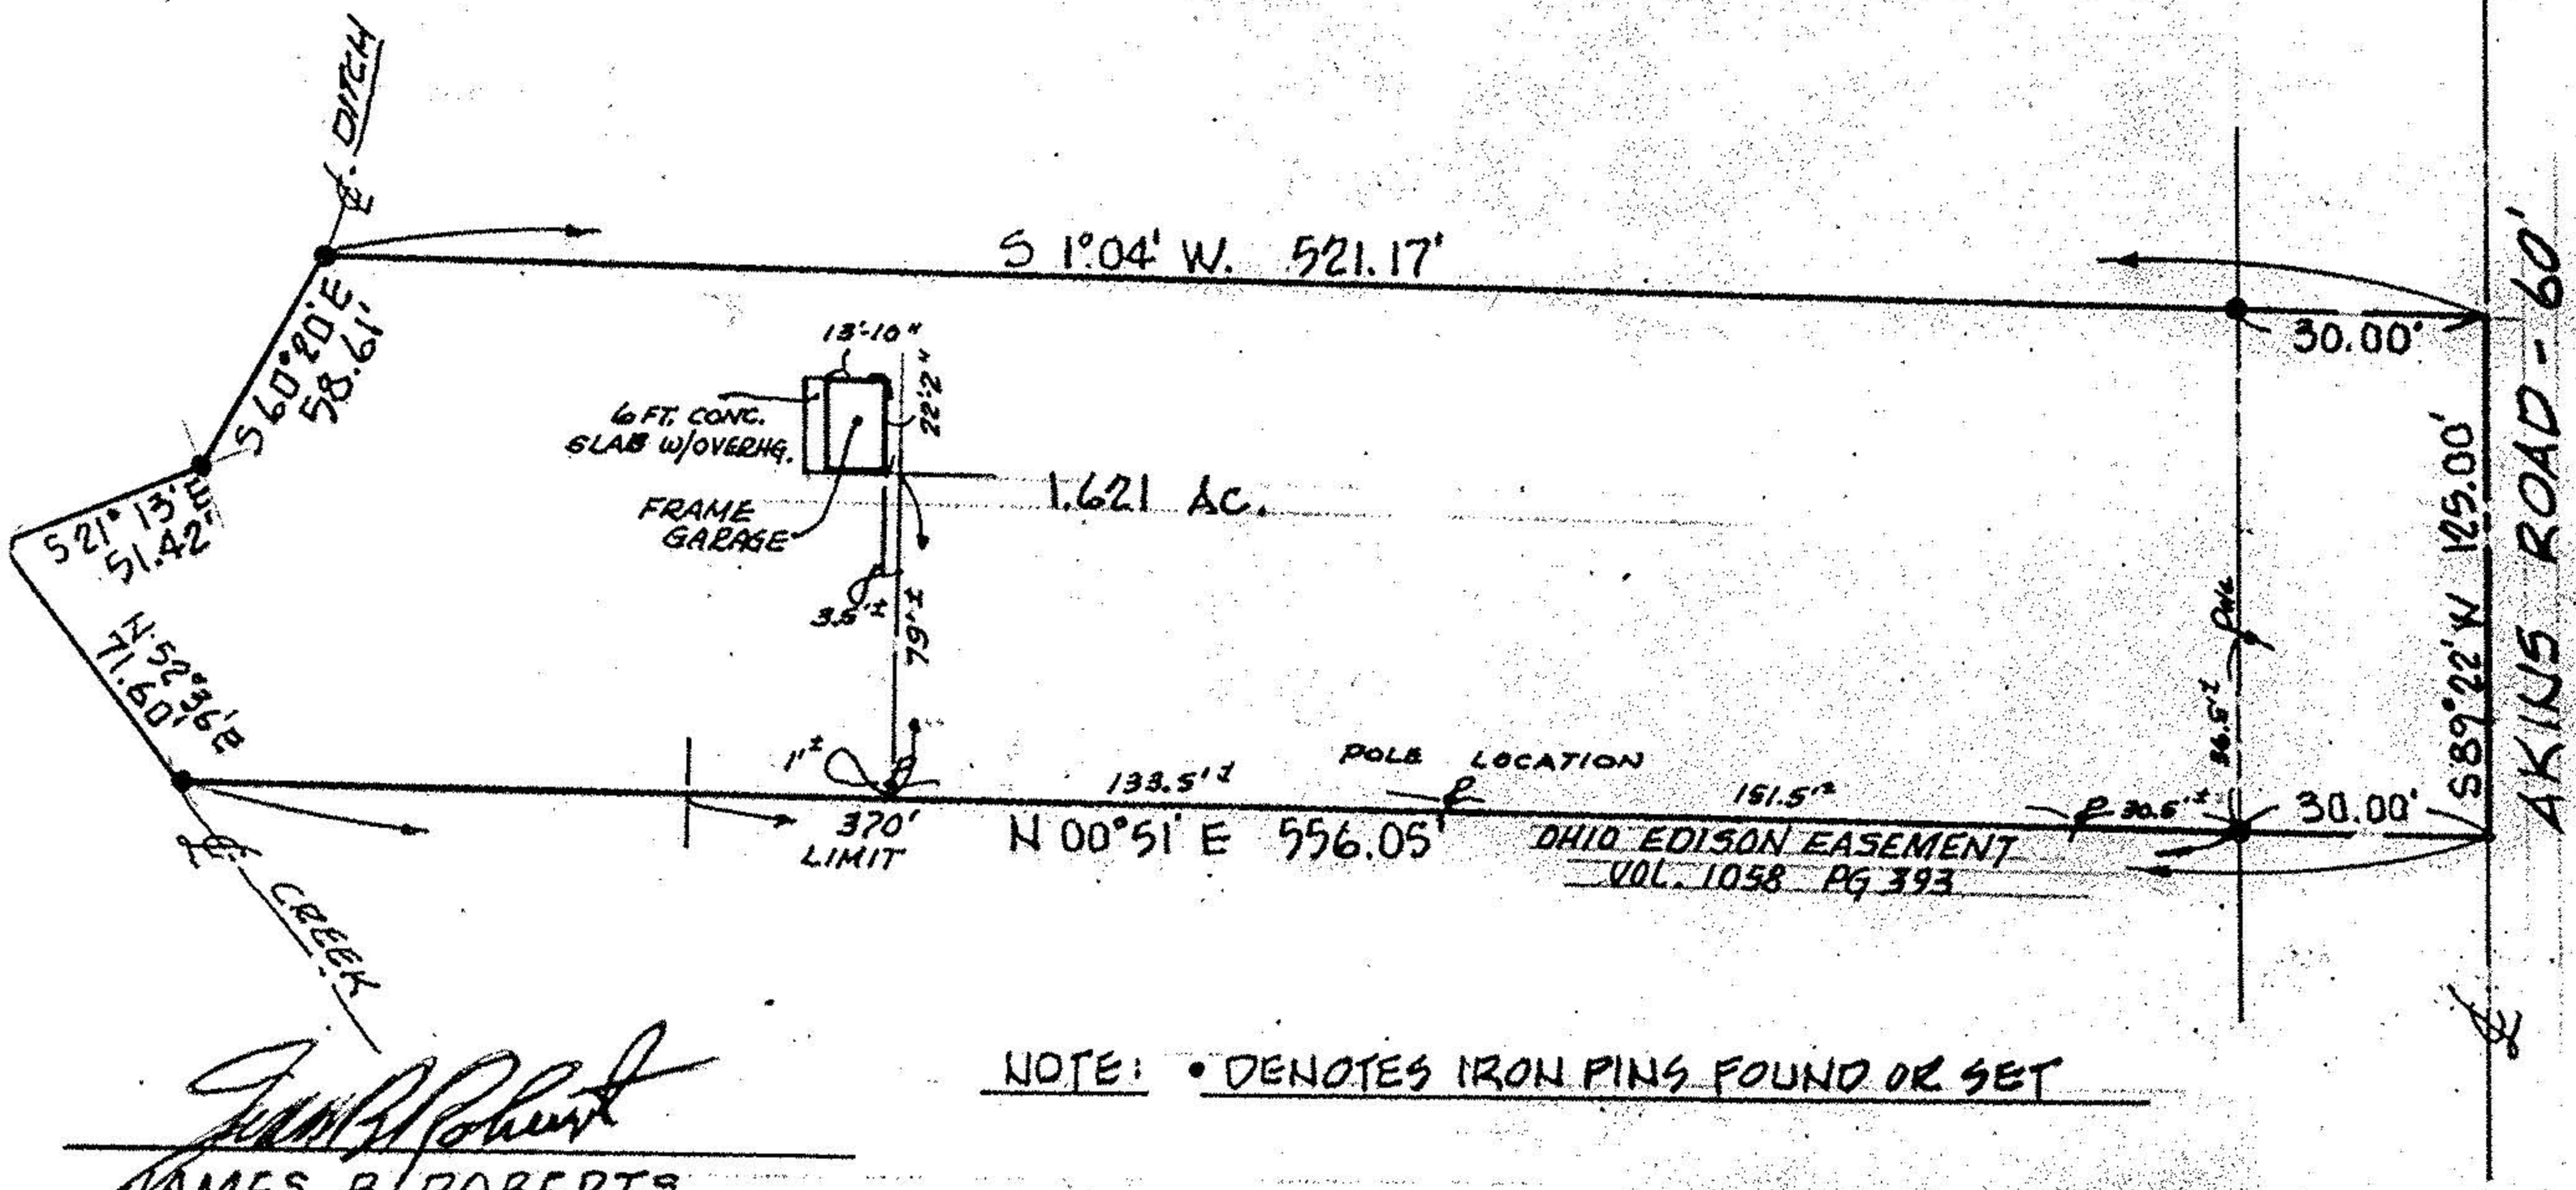

NOTE: • DENOTES IRON PINS FOUND OR SET

JAMES B. ROBERTS
REG. SURVEYOR #4279

PART of ORIG. COLUMBIA TWP. LOT 73
LORAIN COUNTY, OHIO

THIS IS A PLAT OF SURVEY:
PREPARED FOR: DONALD D. ROBESON

K. E. McCARTNEY & ASSOCIATES

MAY 5, 1986 #86199