15-00-027-000-027
15-C

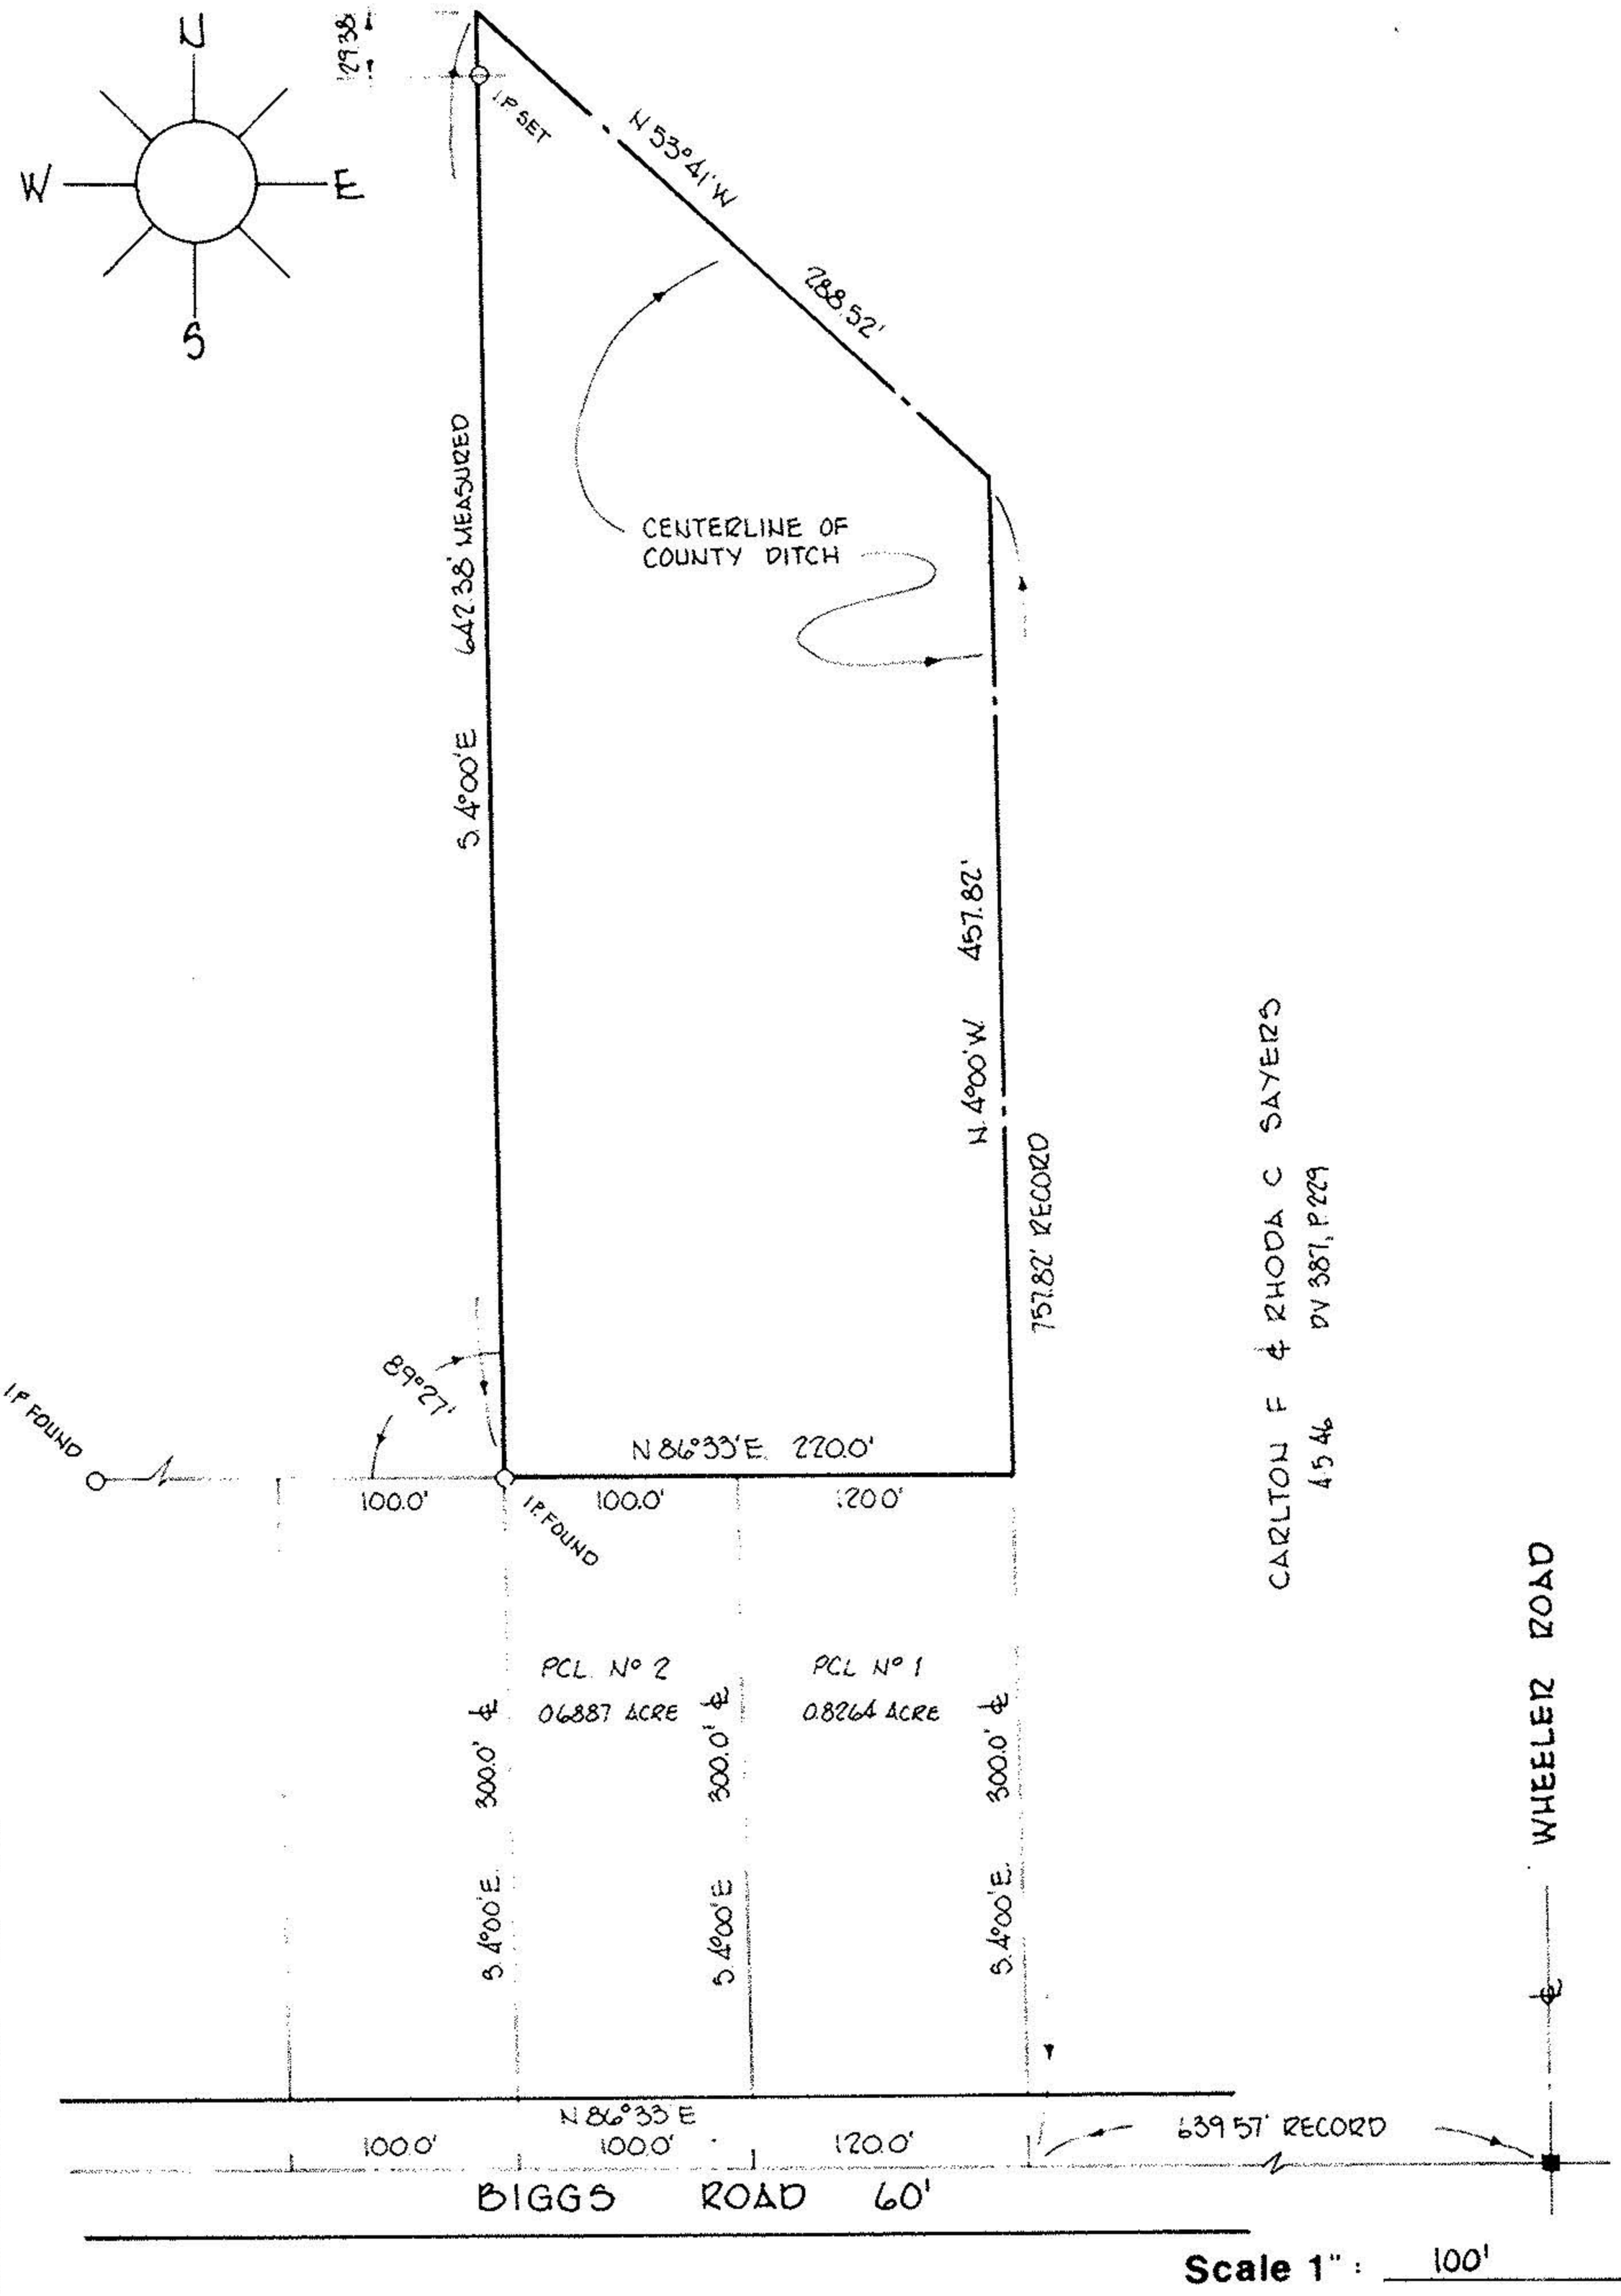

Scale 1" : 100'

Acreage 2.7781

PERIMETER SURVEY

HAROLD FORTNER

SUBLOT _____ of _____

Plat Vol _____ Page _____

Part of O.L. 27 Section _____

Tract _____ LAGRANGE TWP

City of _____

LORAIN Co., Ohio

Michael G. Hura & Associates

4560 Liberty Ave. Vermilion, Ohio

drawn p.a.r.

date 5-14-80

scale 1" = 100'

field book

PERMANENT PARCEL NUMBER
PART OF
15-00-027-000-003
-027

REVISED 5-20-80 p.a.r.