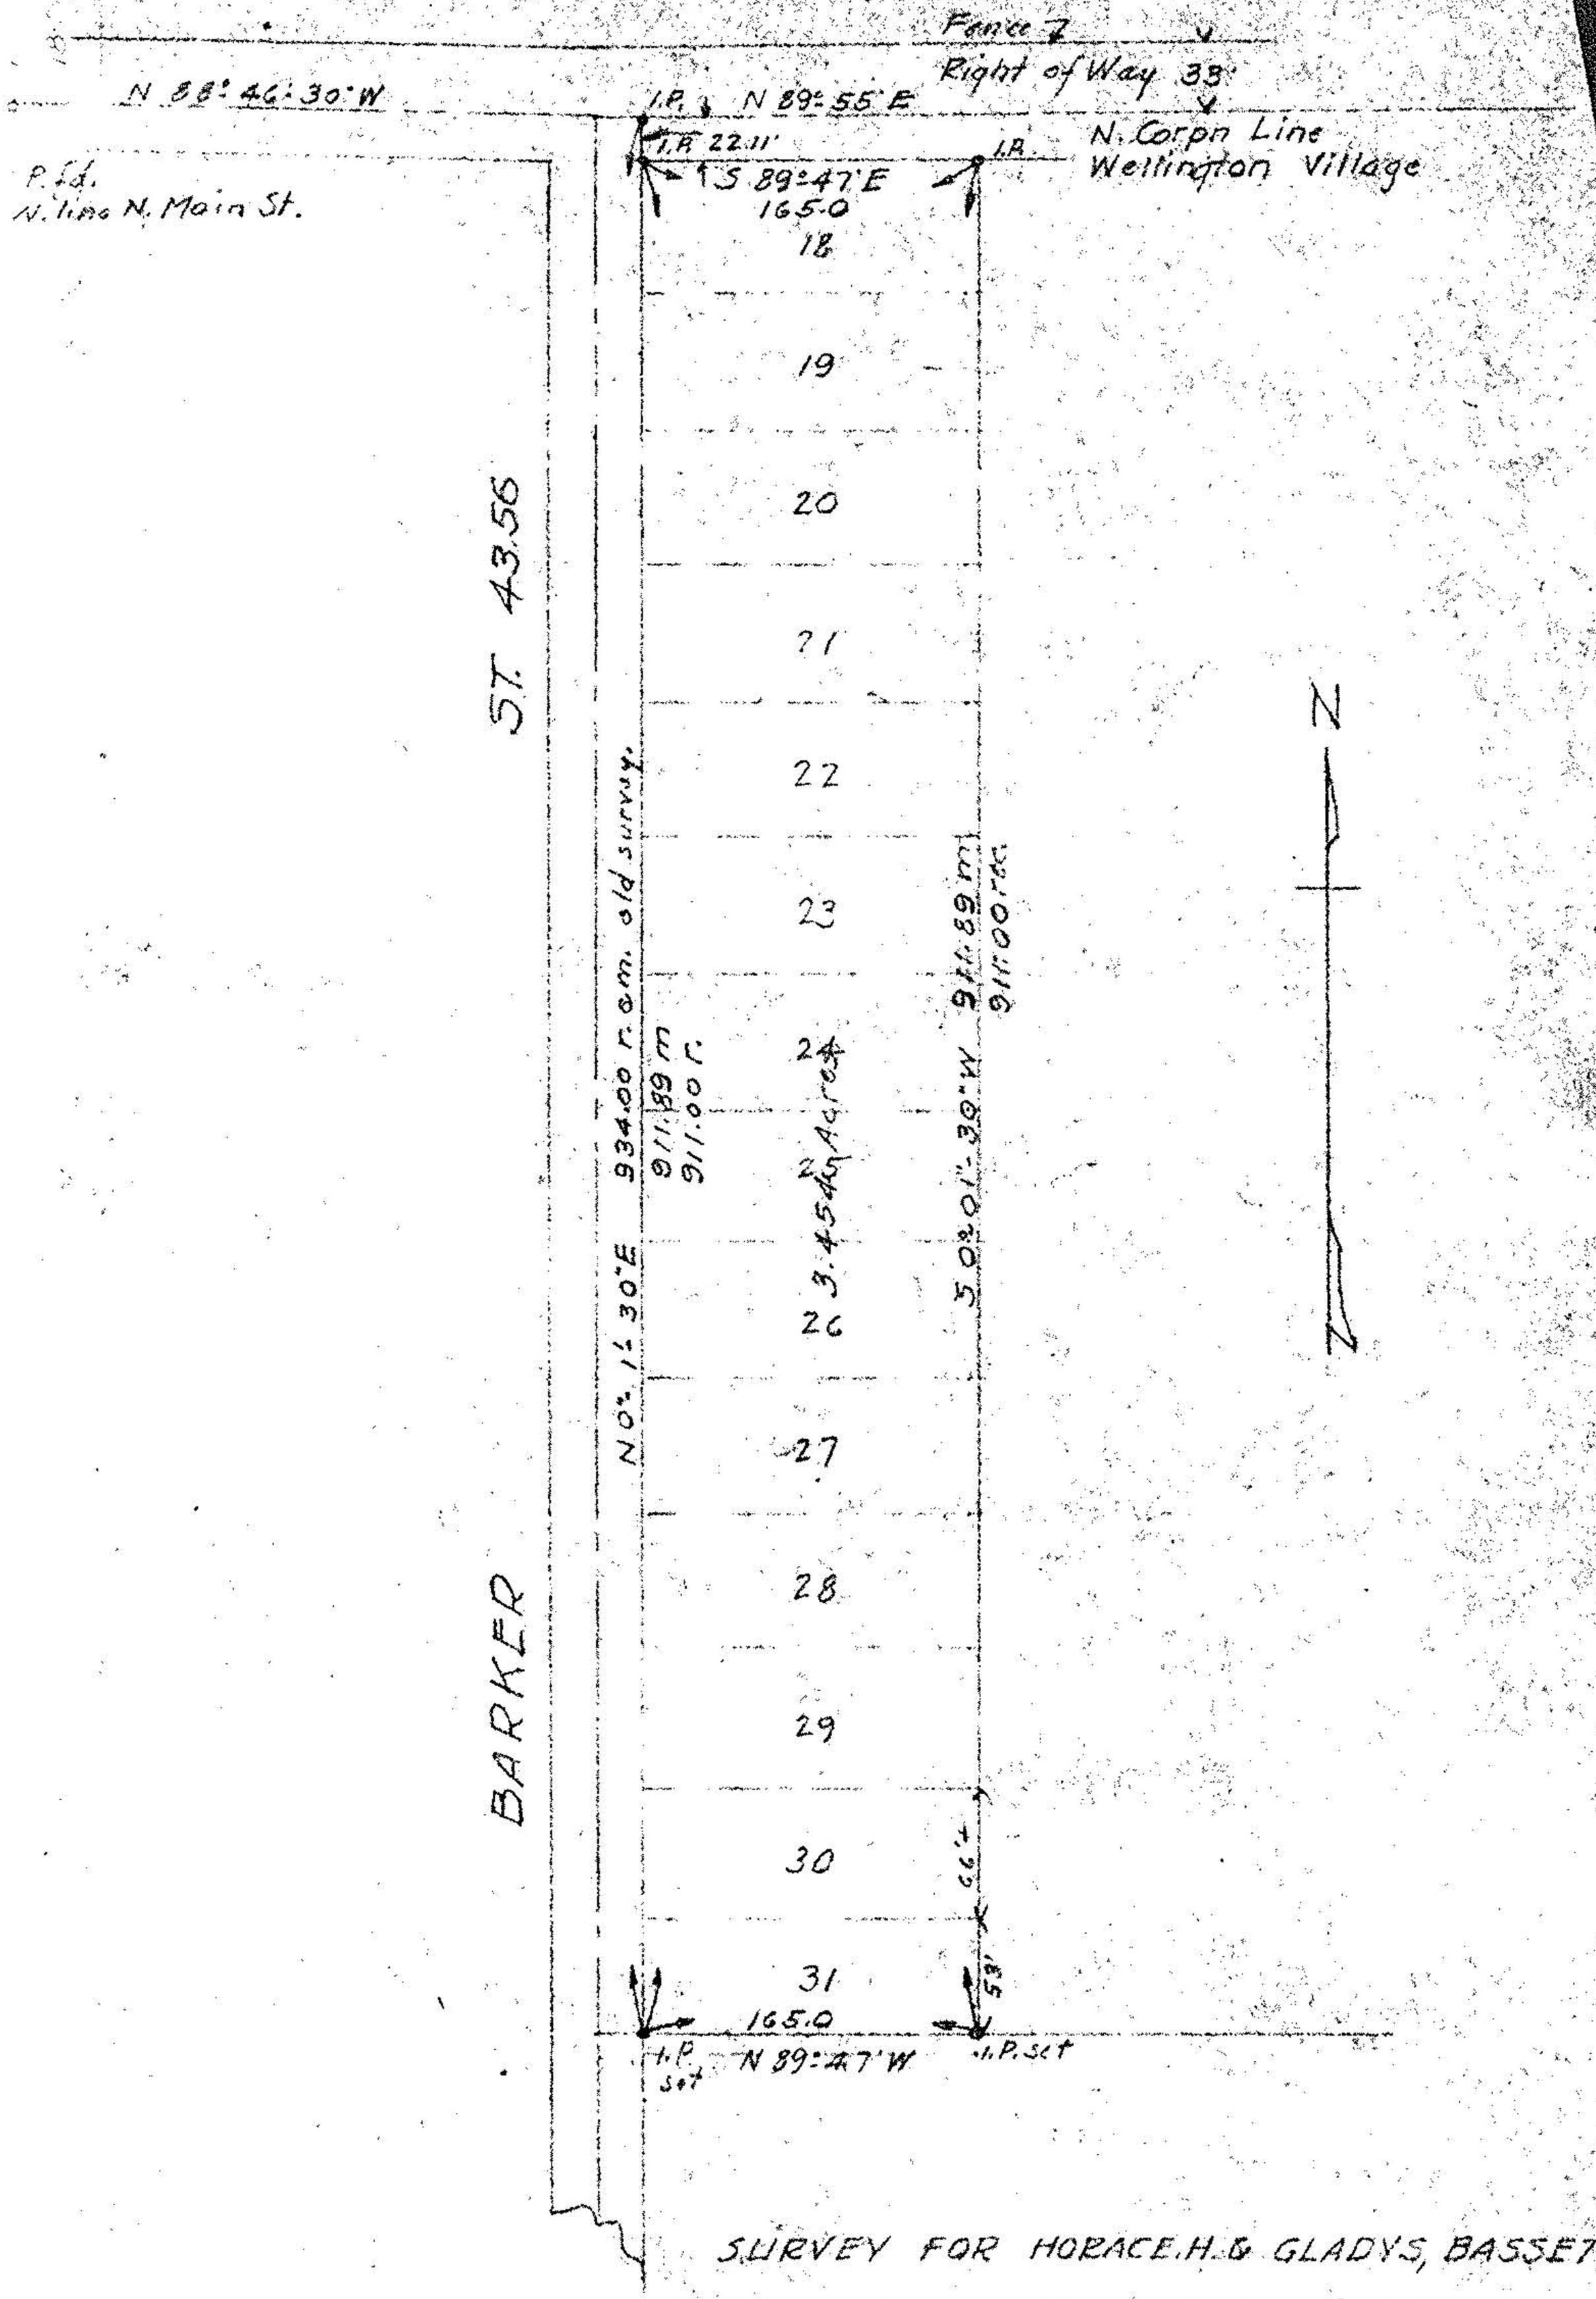

SURVEY FOR HORACE H. & GLADYS, BASSETT

LOTS 18 TO 30, & PT OF LOT 31 WHITBECKS

ADDN. WELLINGTON VILLAGE

LORAIN CO. OHIO. SCALE 1" = 100'