


DEC 27 1974

01-00-064-000-015,016  
01-00-065-000  
01-20-026-000

1-I  
1-00-064  
1-00-065  
1-20-026

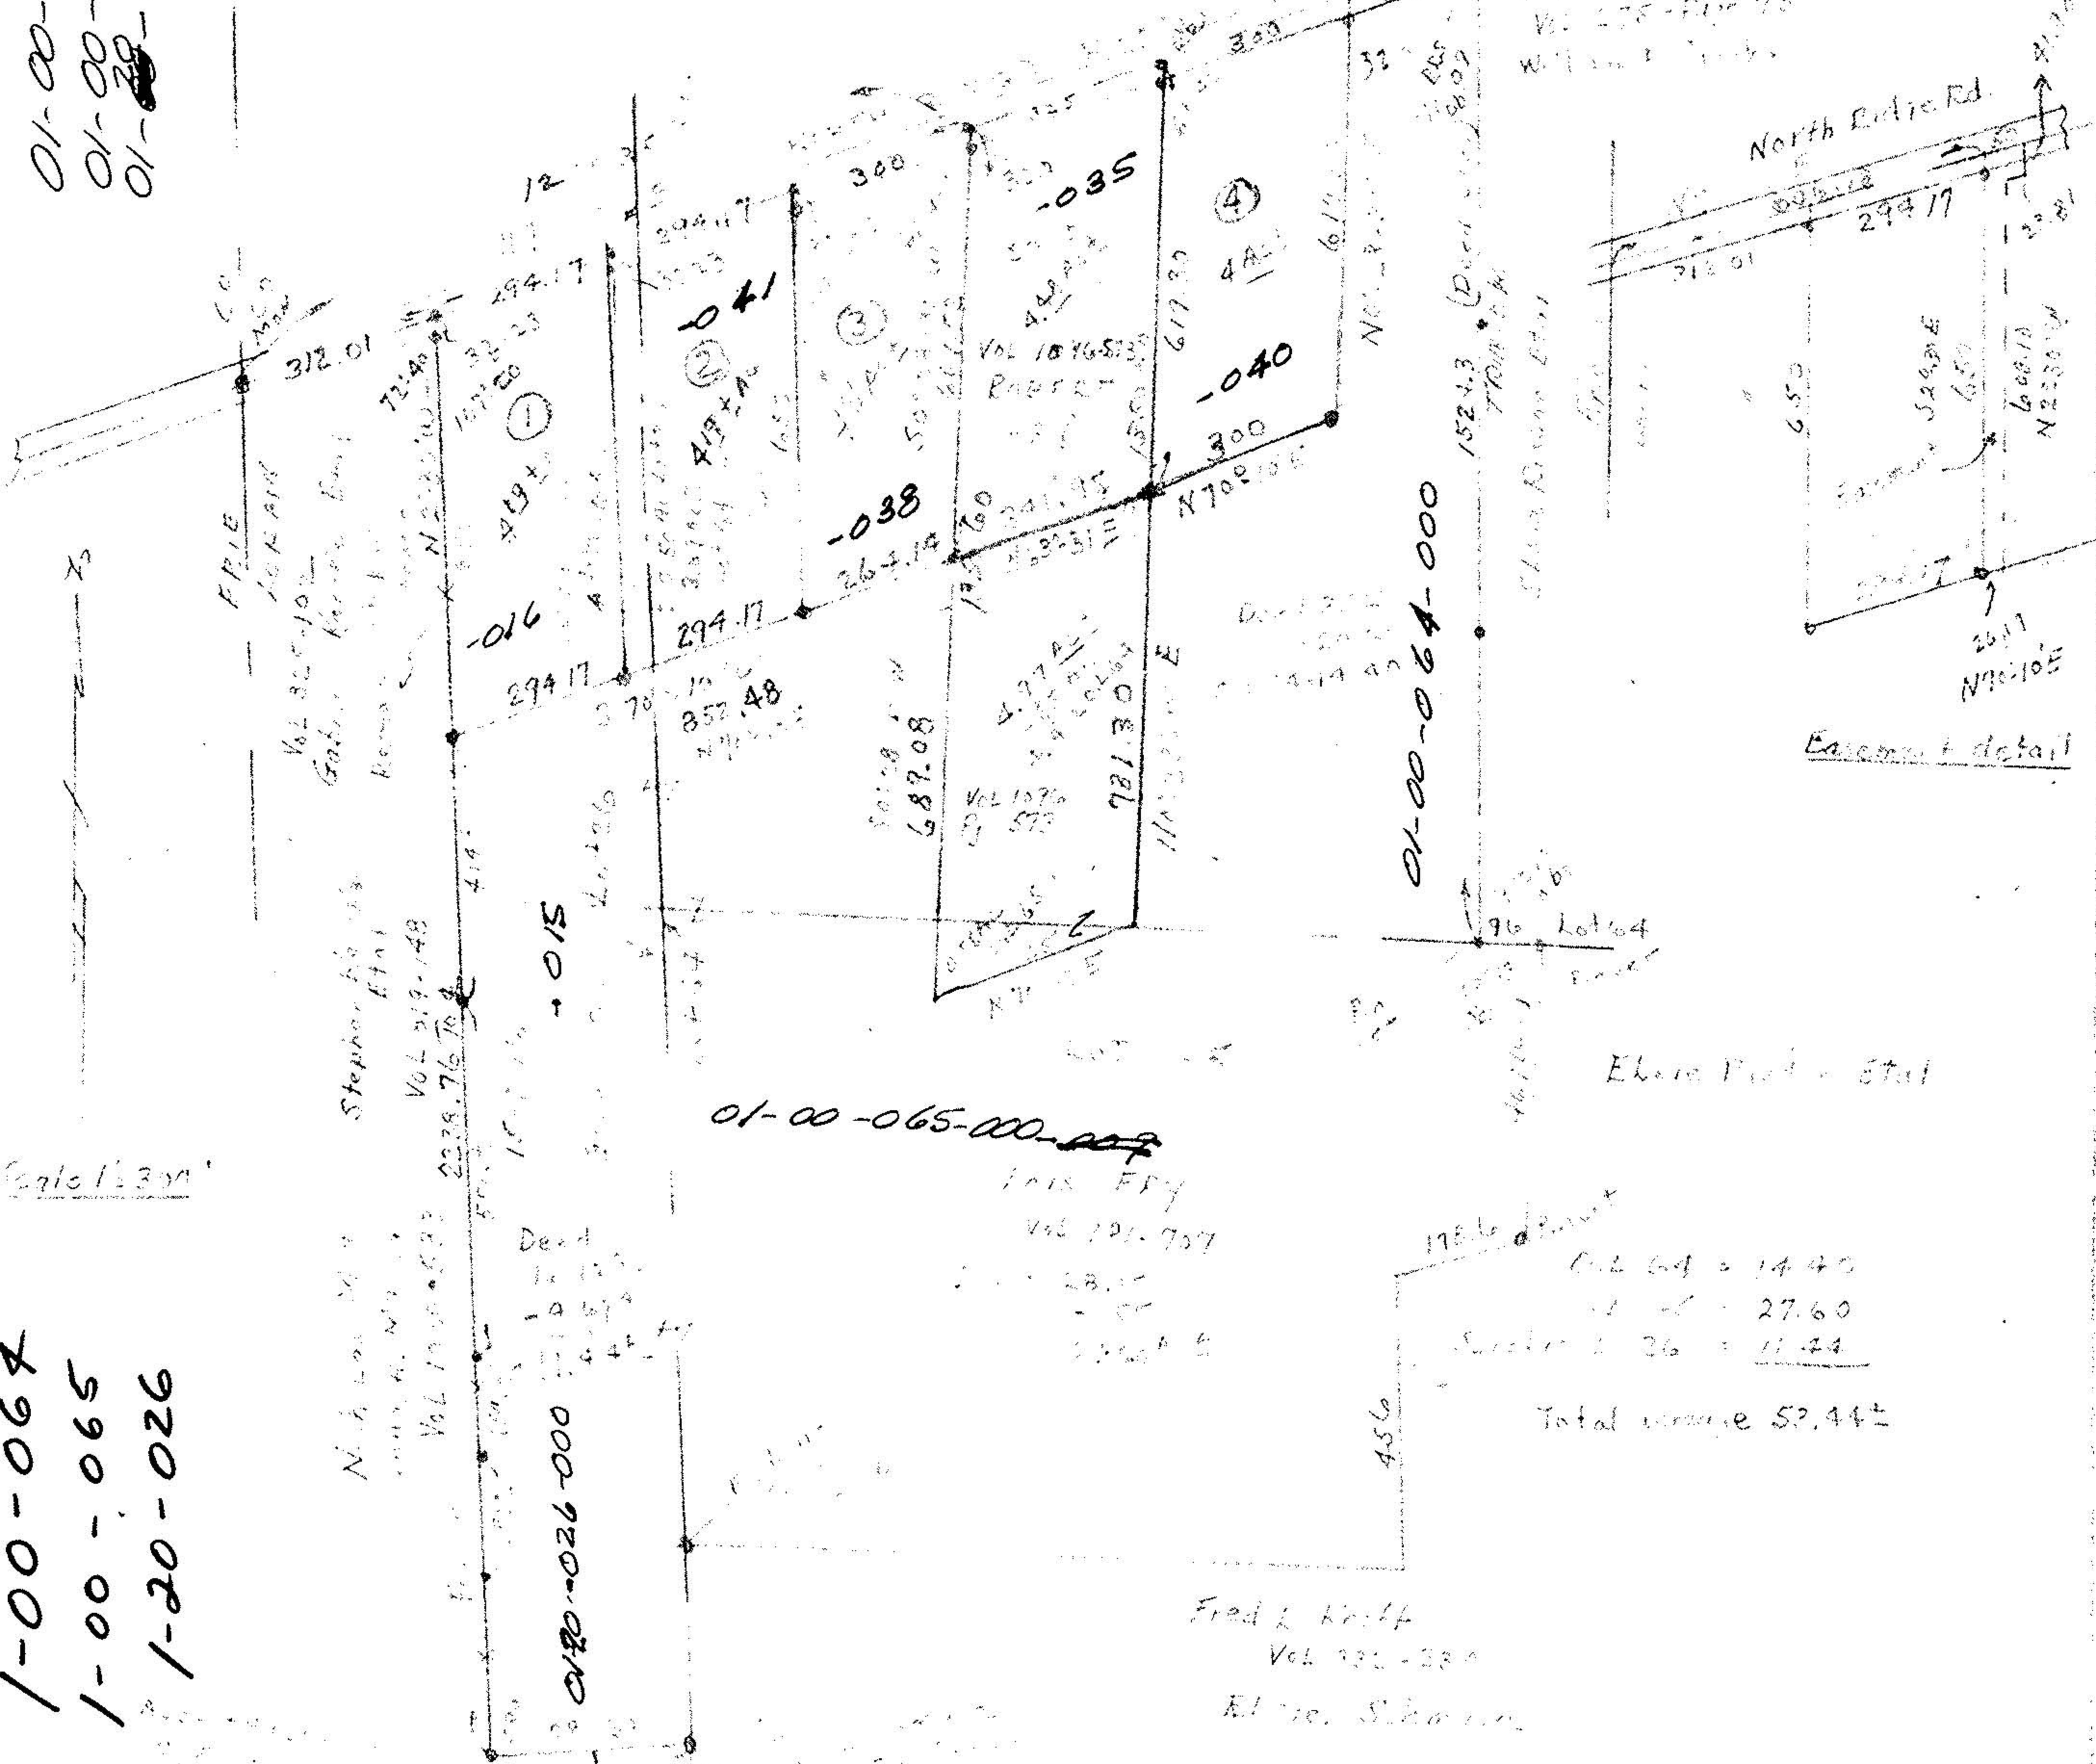


Nicholas M. v. Stephen A. et al

Vol 191-757

01-00-026-000

01-00-065-000-007


Vol 191-757

28.15  

Fred L. Kraft

Vol 221-220

Elmer S. et al

Elmer Fred - et al

175 lb. Easement

64 = 14.40

65 = 27.60

Section 36 = 11.44

Total acreage 53.44±

Easement detail

North Endie Rd

Vol 275-419-73  
William J. et al

Elmer Fred et al

Lot 64

Lot 65

