


1-00-073

#113.02

0.273

1-00-073

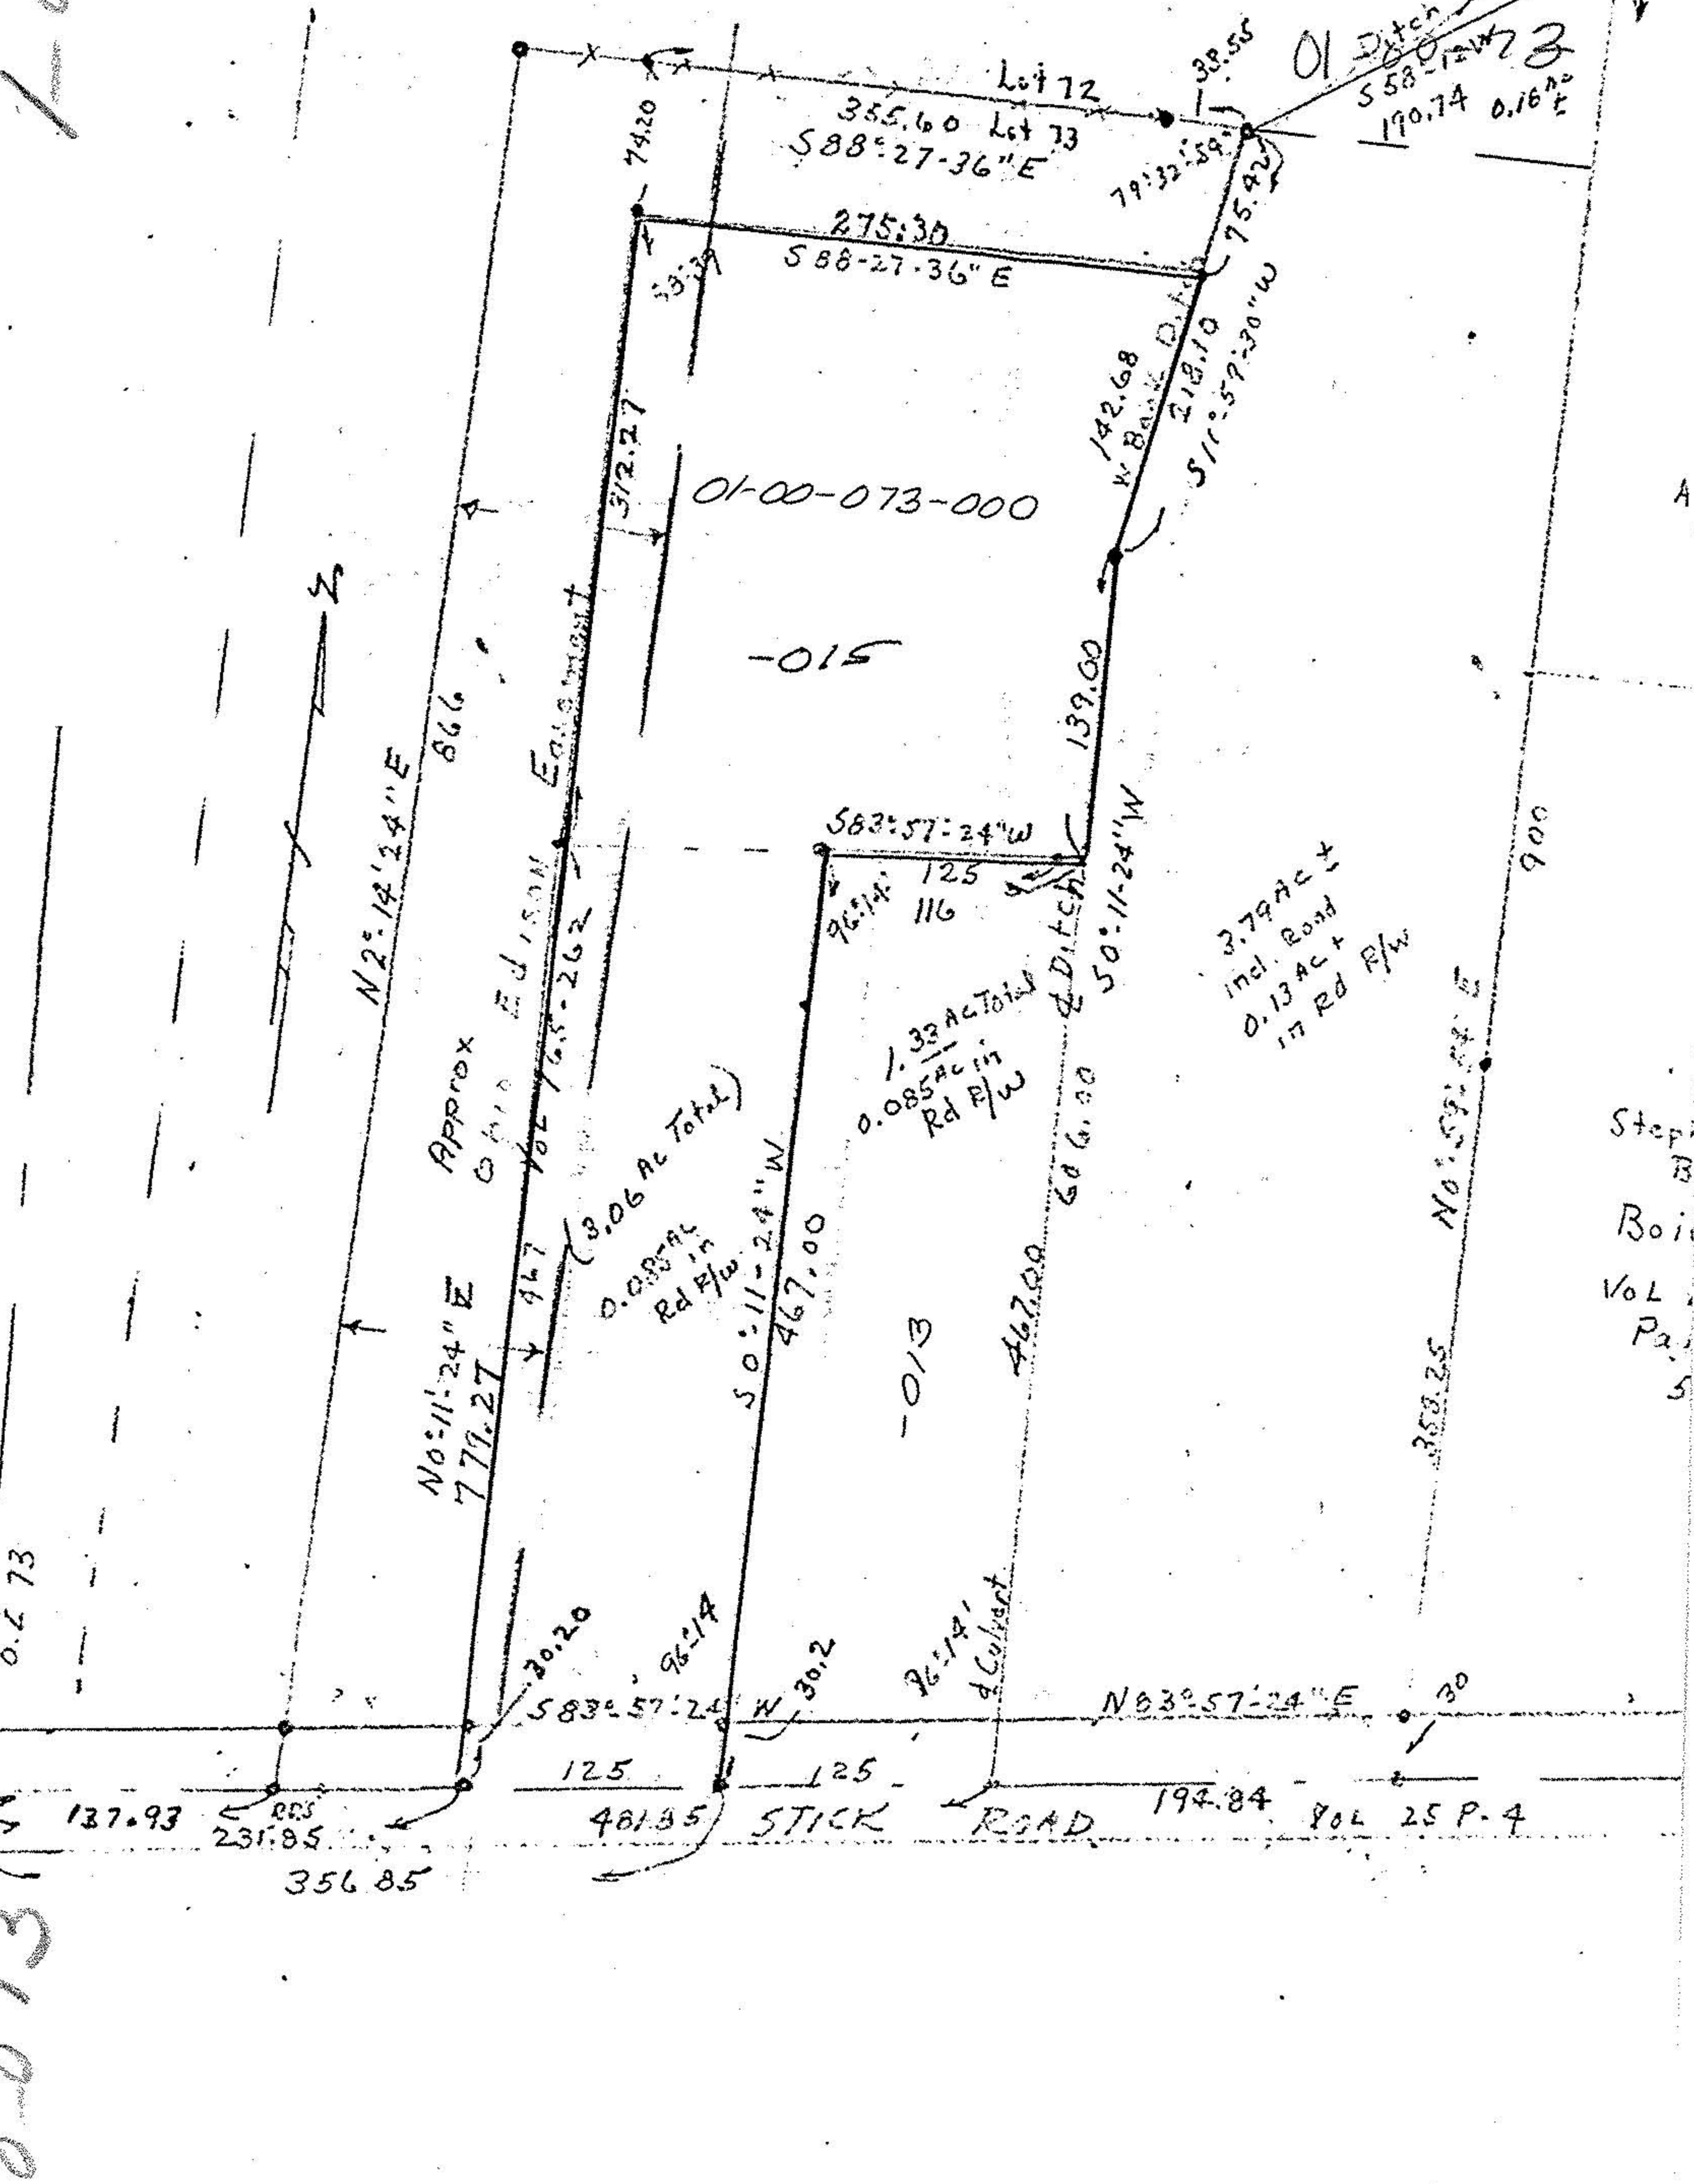

P.P.N

01-00-073-000-015