


LINE	BEARING	DISTANCE
L 1	S 01°46'40.0"E	65.00'

Patricia Penton Leimbach • Paul Leimbach Trust  
O.R. Volume 1407 Pg. 901


Patricia Leimbach  
O.R. Volume 1400  
Page 939  
5.49 Acres

End of Public Street

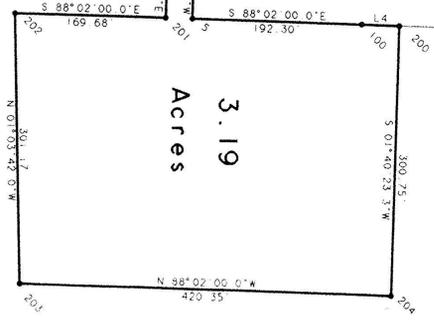

Patricia Penton Leimbach • Paul Leimbach Trust  
O.R. Volume 1407 Page 901

P.P.N 01-00-011-000-0115

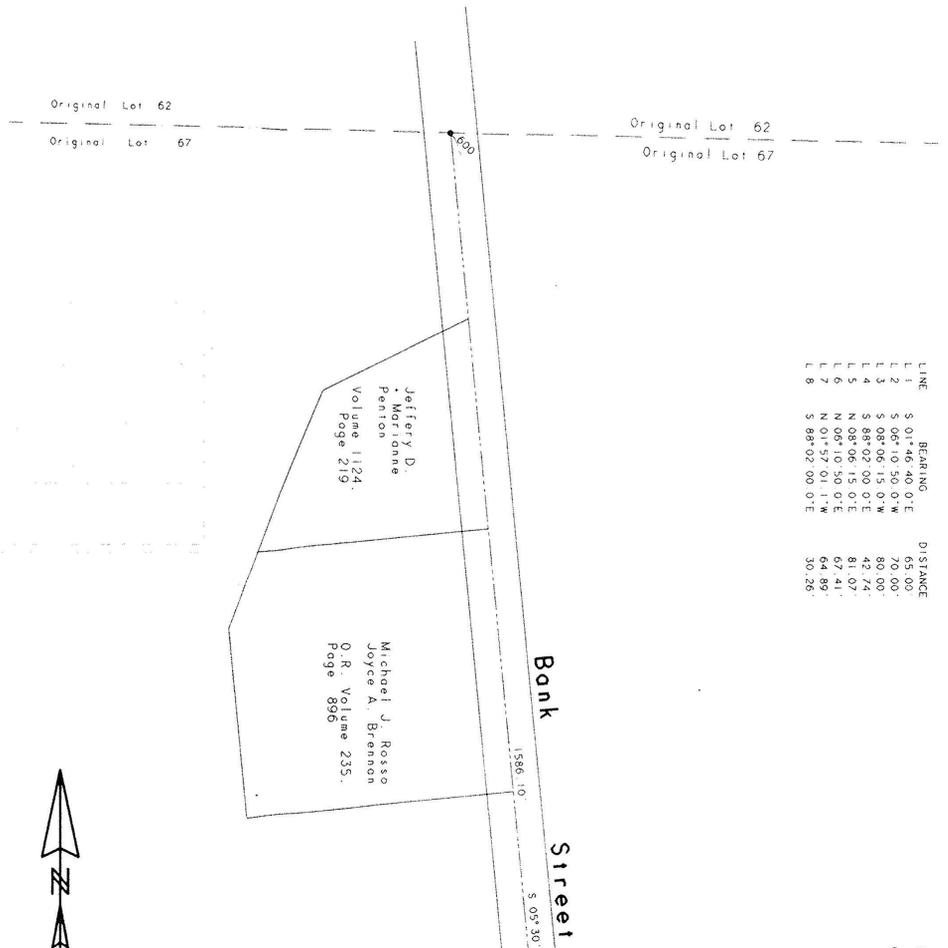

Note: Bearings shown are to an assumed meridian and are used to describe angles only.  
Note: Only copies signed with Red Ink shall be considered valid.  
*Patrick A. McGannon*  
Patrick A. McGannon, P.S. 7154  
Prepared for: Orrin Leimbach

Being known as part of Original Lot 67 of the Brownhelm Township in the County of Lorain, in the State of Ohio.

POINT	NORTHING	EASTING	DESCRIPTION
1	1000.00000	1000.00000	
2	935.03129	1002.01650	RR, Spike Fd.
3	865.43816	994.48016	RR, Spike Fd.
4	786.23708	983.20231	RR, Spike Fd.
5	658.05244	978.52377	RR, Spike Fd.
6	508.16643	964.90820	I.P. Set
7	364.40420	953.22975	I.P. Set
8	288.00514	948.54105	I.P. Set
9	659.07326	1170.71050	Iron Pin Found
100	651.45307	1213.42532	Iron Pin Set
200	649.98632	948.54144	Iron Pin Set
201	659.08198	778.96139	Iron Pin Set
202	664.90507	784.54162	Iron Pin Set
203	563.78077	1204.64402	Iron Pin Set
204	349.36117	950.29452	Iron Pin Found
300	1017.15905	985.62314	R.R. Spike Fd.
301	1149.30943	847.97905	Iron Pin Found
302	2578.79791		



• IRON PIN or Railroad Spike

**#22212**  
APPROVED  
LORAIN CO.  
MAP DEPT.  
DATE 6-24-97  
PAGE 1-5  
BY R. Bell  
#22212

Boundary Survey  
Patrick A. McGannon  
Registered Professional Surveyor  
1731 Gettysburg Drive, Lorain, Ohio (216)-2822712

